


MAP SHOWING PROPERTY OF
COMMERCIAL COAL COMPANY
 SITUATE IN
 BLACKLICK TWP., CAMBRIA CO., PA.
 SCALE 1"=100' FEB. 1950
 PERTINENT REV. 1950

Commercial Coal
 Mining Company

- Existing Strip Mines
- Proposed Mining within Succeeding Six Months
- Completed Area

FROM ALL INDICATIONS AREA SURROUNDING PROPOSED PERMITTED AREA HAS BEEN ALL MINED OUT

REVISED: DEC. 9, 1966
 REVISED: MAR. 1967
 REVISED: NOV. 1967
 REVISED: MAY 1968
 REVISED: NOV. 1968
 REVISED: MAY 1969
 REVISED: NOV. 1969

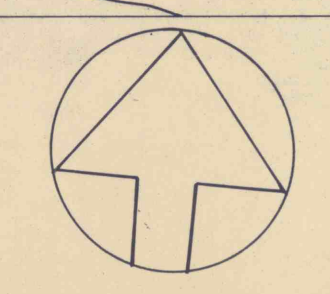

COMMERCIAL COAL COMPANY OF TWIN ROCKS

Blacklick Twp.,
 Scale: 1" = 200'

Cambria Co.,

Pennsylvania
 October, 1966

This map prepared by L. ROBERT KIMBALL, Consulting Engineers, Ebensburg, Pennsylvania, using an enlargement of U.S.G.S. Quadrangles and maps by others.

#119
 6-29-99
 C.C.