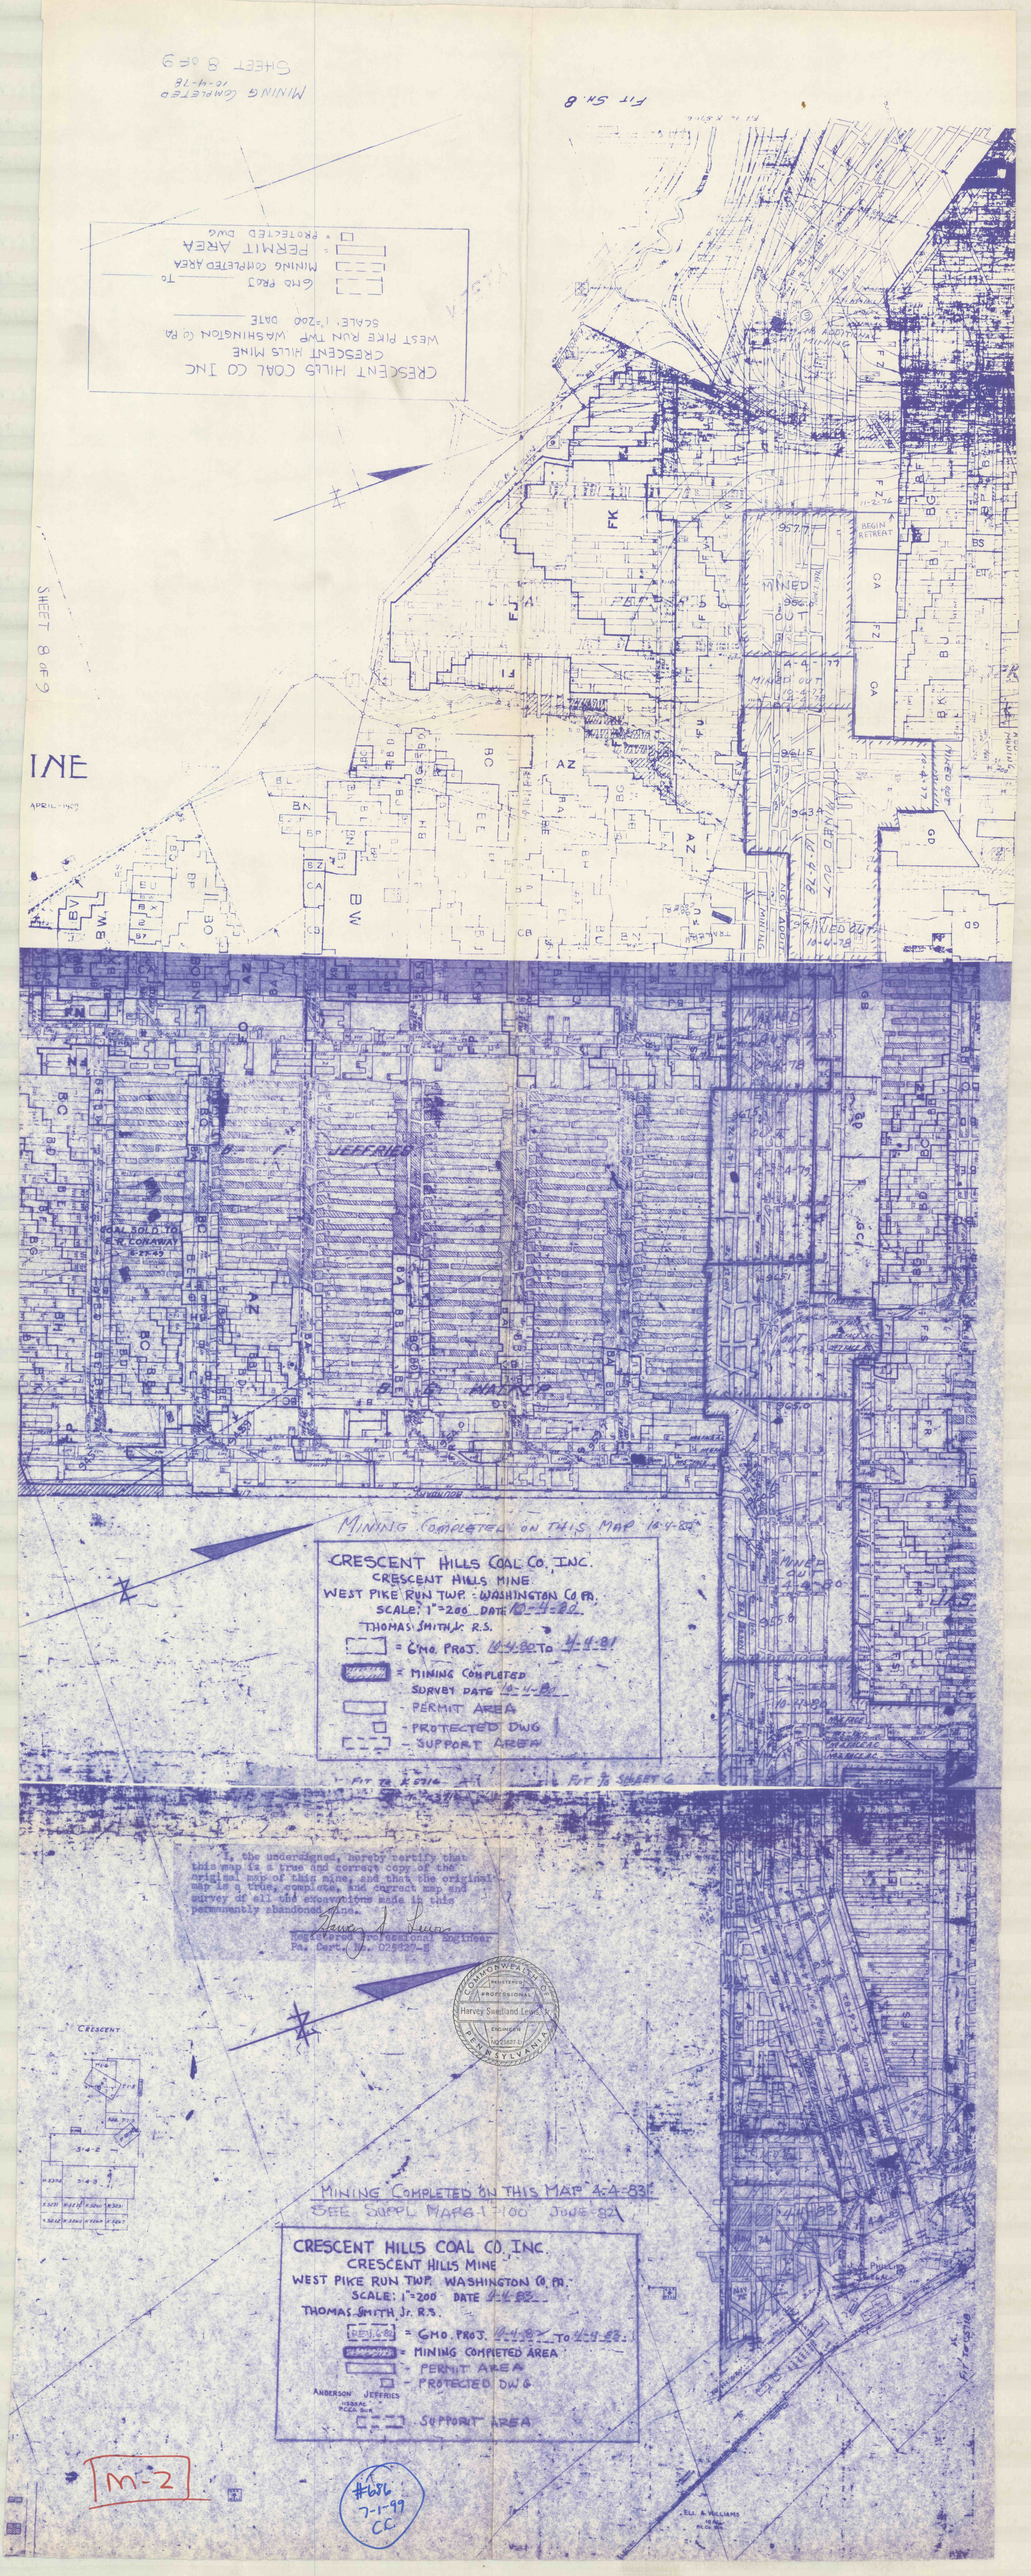
MINING COMPLETED 10-4-78
SHEET 8 OF 9
CRESCENT HILLS COAL CO INC
CRESCENT HILLS MINE
WEST PIKE RUN TWP WASHINGTON CO PA
SCALE: 1"=200 DATE
GMO PROJ To
MINING COMPLETED AREA
PERMIT AREA
PROTECTED DWG
Fit Sh. 8
SHEET 6 OF 9
APRIL 1980
MINED OUT 4-4-77
BEGIN RETREAT
MINED OUT 10-4-78
JEFFRIES
COAL SOLD TO R. CONAWAY 6-FX-43
MINING COMPLETED ON THIS MAP 10-4-82
CRESCENT HILLS COAL CO. INC.
CRESCENT HILLS MINE
WEST PIKE RUN TWP. : WASHINGTON CO PA.
SCALE: 1"=200 DATE 10-4-82
THOMAS SMITH JR. R.S.
= GMO. PROJ. 10-4-82 TO 4-4-83
= MINING COMPLETED SURVEY DATE 10-4-82
- PERMIT AREA
- PROTECTED DWG
- SUPPORT AREA
Fit to Sh 6
Fit to Sheet 6
I, the undersigned, hereby certify that this map is a true and correct copy of the original map of this mine, and that the original map is a true, complete, and correct map and a survey of all the excavations made in this permanently abandoned mine.
Registered Professional Engineer
Pa. Cert. No. 029827-E
COMMONWEALTH OF PENNSYLVANIA
REGISTERED PROFESSIONAL ENGINEER
Harvey Sweitland Lewis, Jr.
MINING COMPLETED ON THIS MAP 4-4-83
SEE SUPPL MAP 6-1-100 JUNE 82
CRESCENT HILLS COAL CO. INC.
CRESCENT HILLS MINE
WEST PIKE RUN TWP. WASHINGTON CO. PA.
SCALE: 1"=200 DATE 4-4-83
THOMAS SMITH Jr. R.S.
= GMO. PROJ. 4-4-83 TO 4-4-88
= MINING COMPLETED AREA
- PERMIT AREA
- PROTECTED DWG
- SUPPORT AREA
ANDERSON JEFFRIES
M-2
#686
7-1-99
CC