


#686
7-1-99
CC

CRESCENT HILLS COAL CO. INC
CRESCENT HILLS MINE
WEST PIKE RUN TWP WASHINGTON CO PA
SCALE: 1"=200 DATE - 10-10-83

I, the undersigned, hereby certify that this map is a true and correct copy of the original map of this mine, and that the original map is a true, complete, and correct map and survey of all the excavations made in this permanently abandoned mine.

Harvey S. Lewis
Registered Professional Engineer
Pa. No. 025827-E

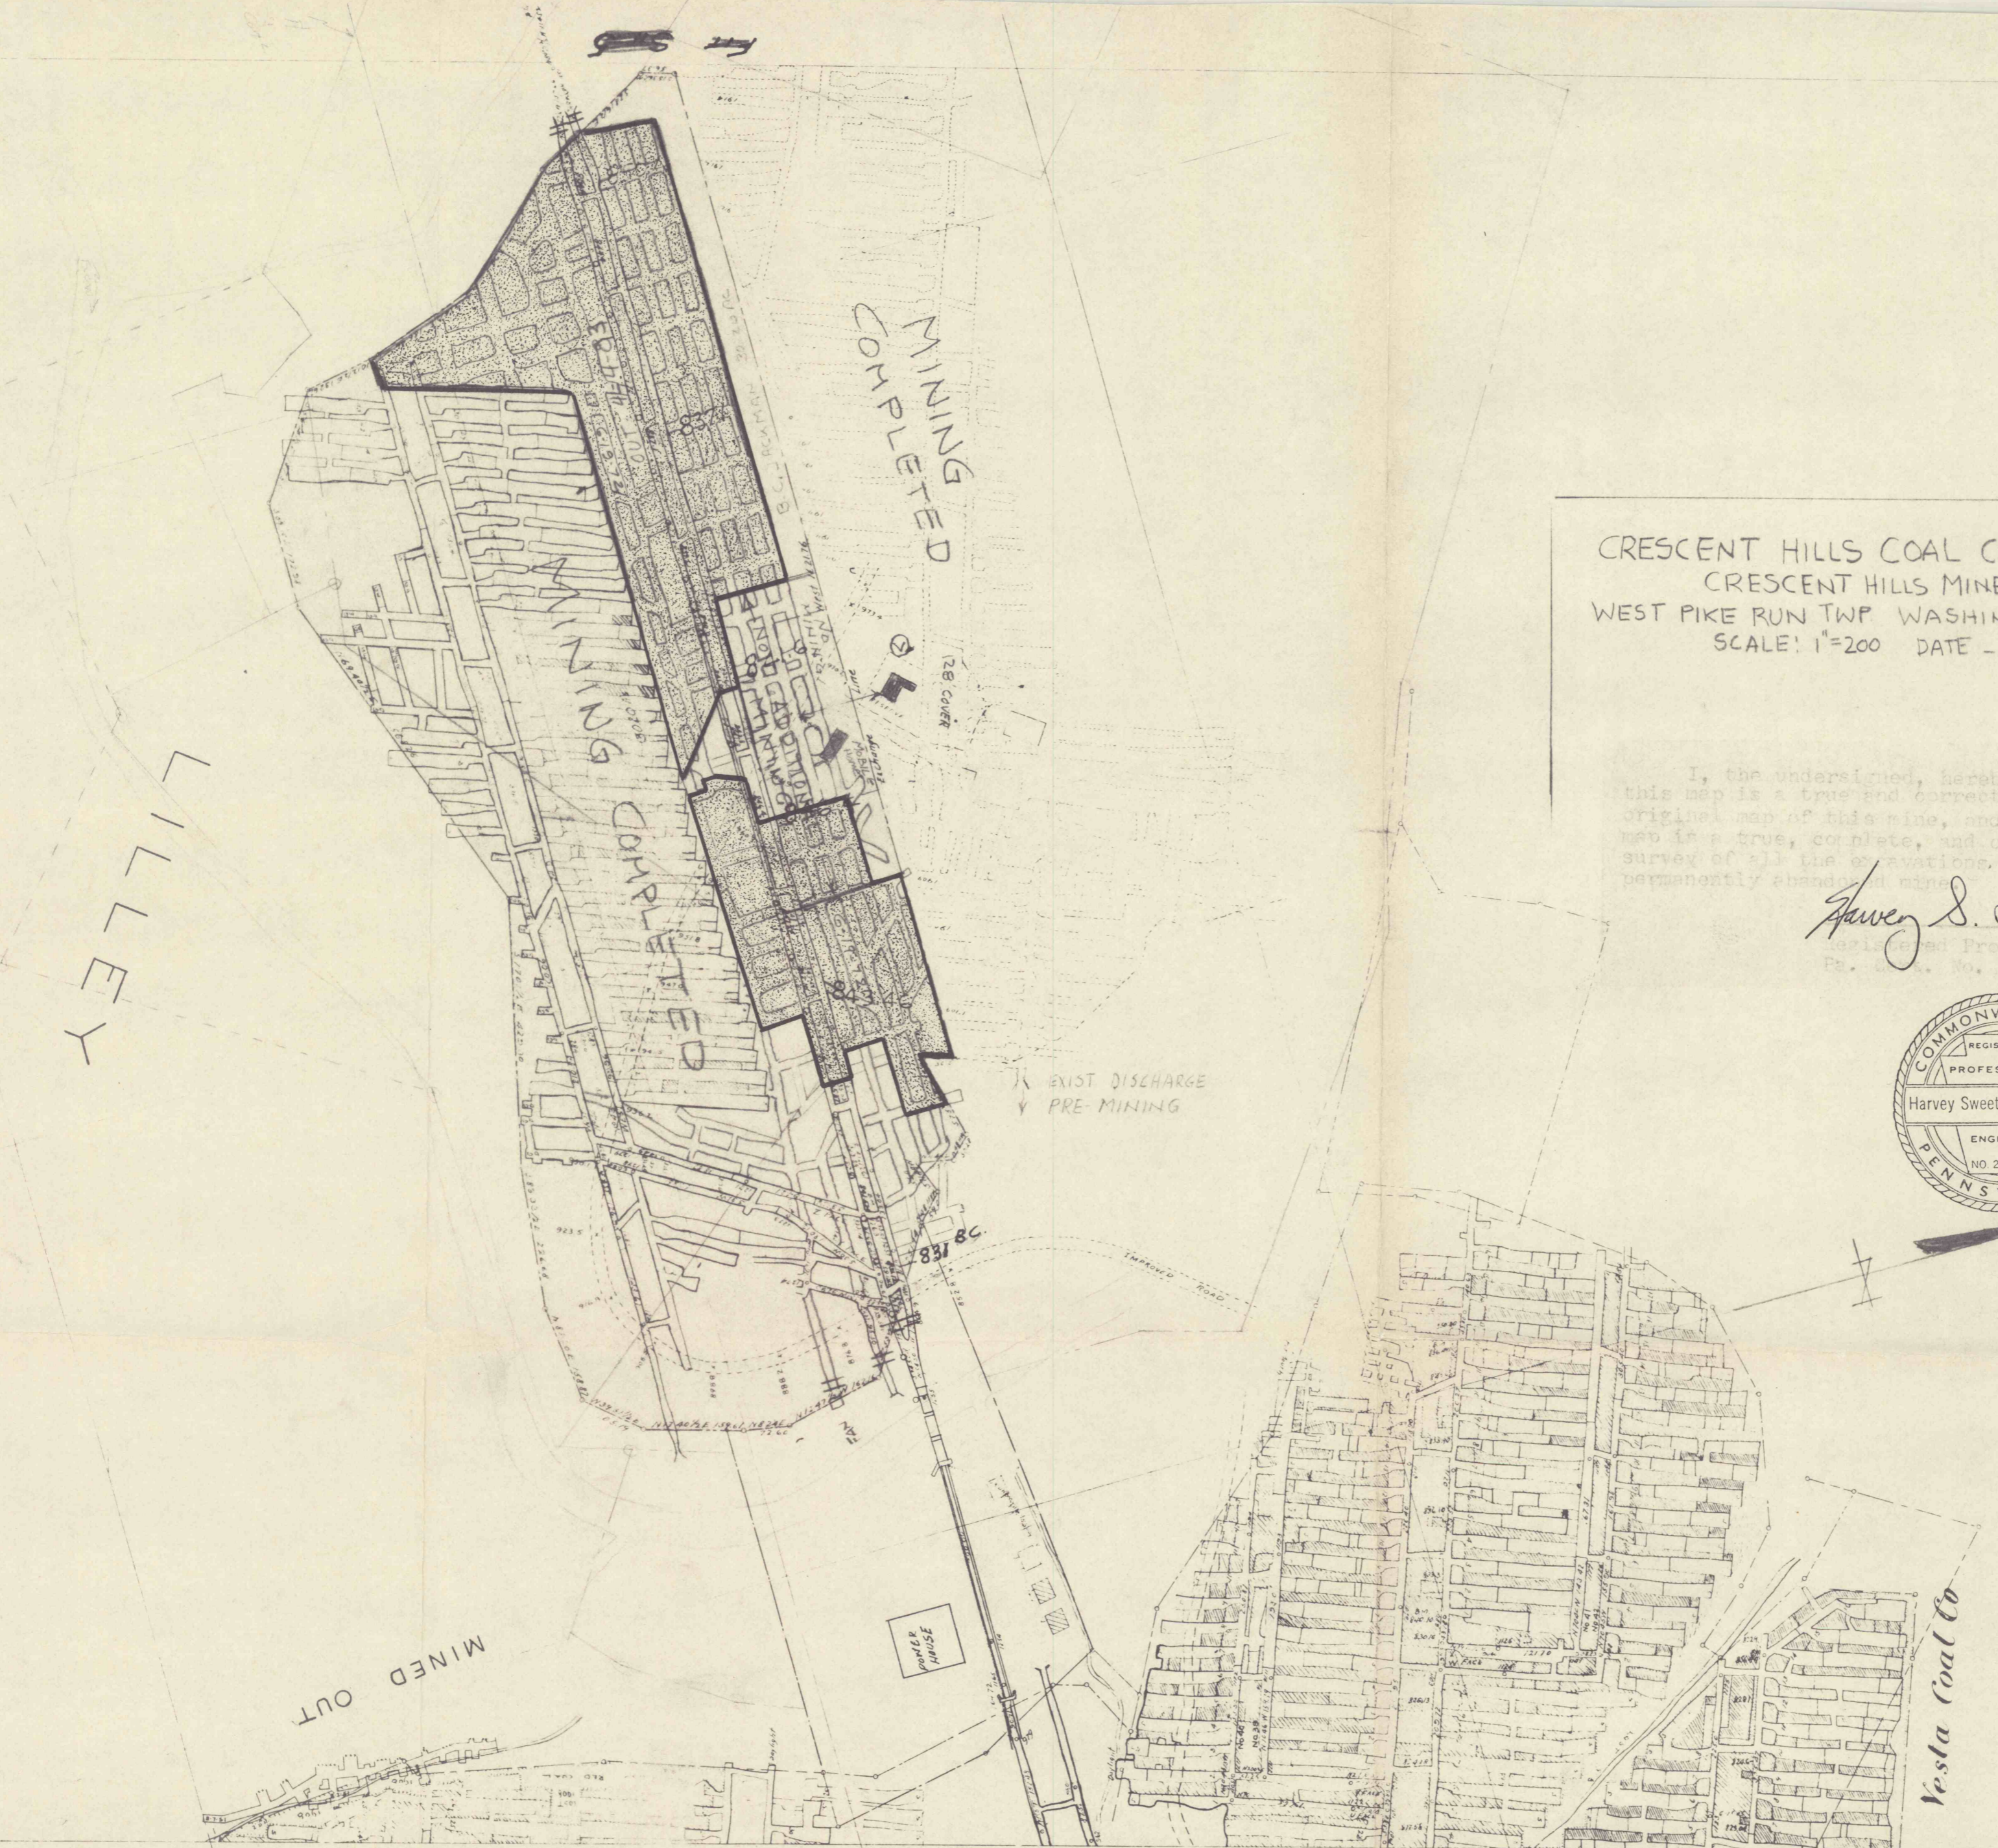

LILLEY

MINING COMPLETED

EXIST DISCHARGE
PRE-MINING

POWER HOUSE

Vesta Coal Co

FIT SH 3

SHEET 50K 9 SH. 1

SHEET 50K 9
CO