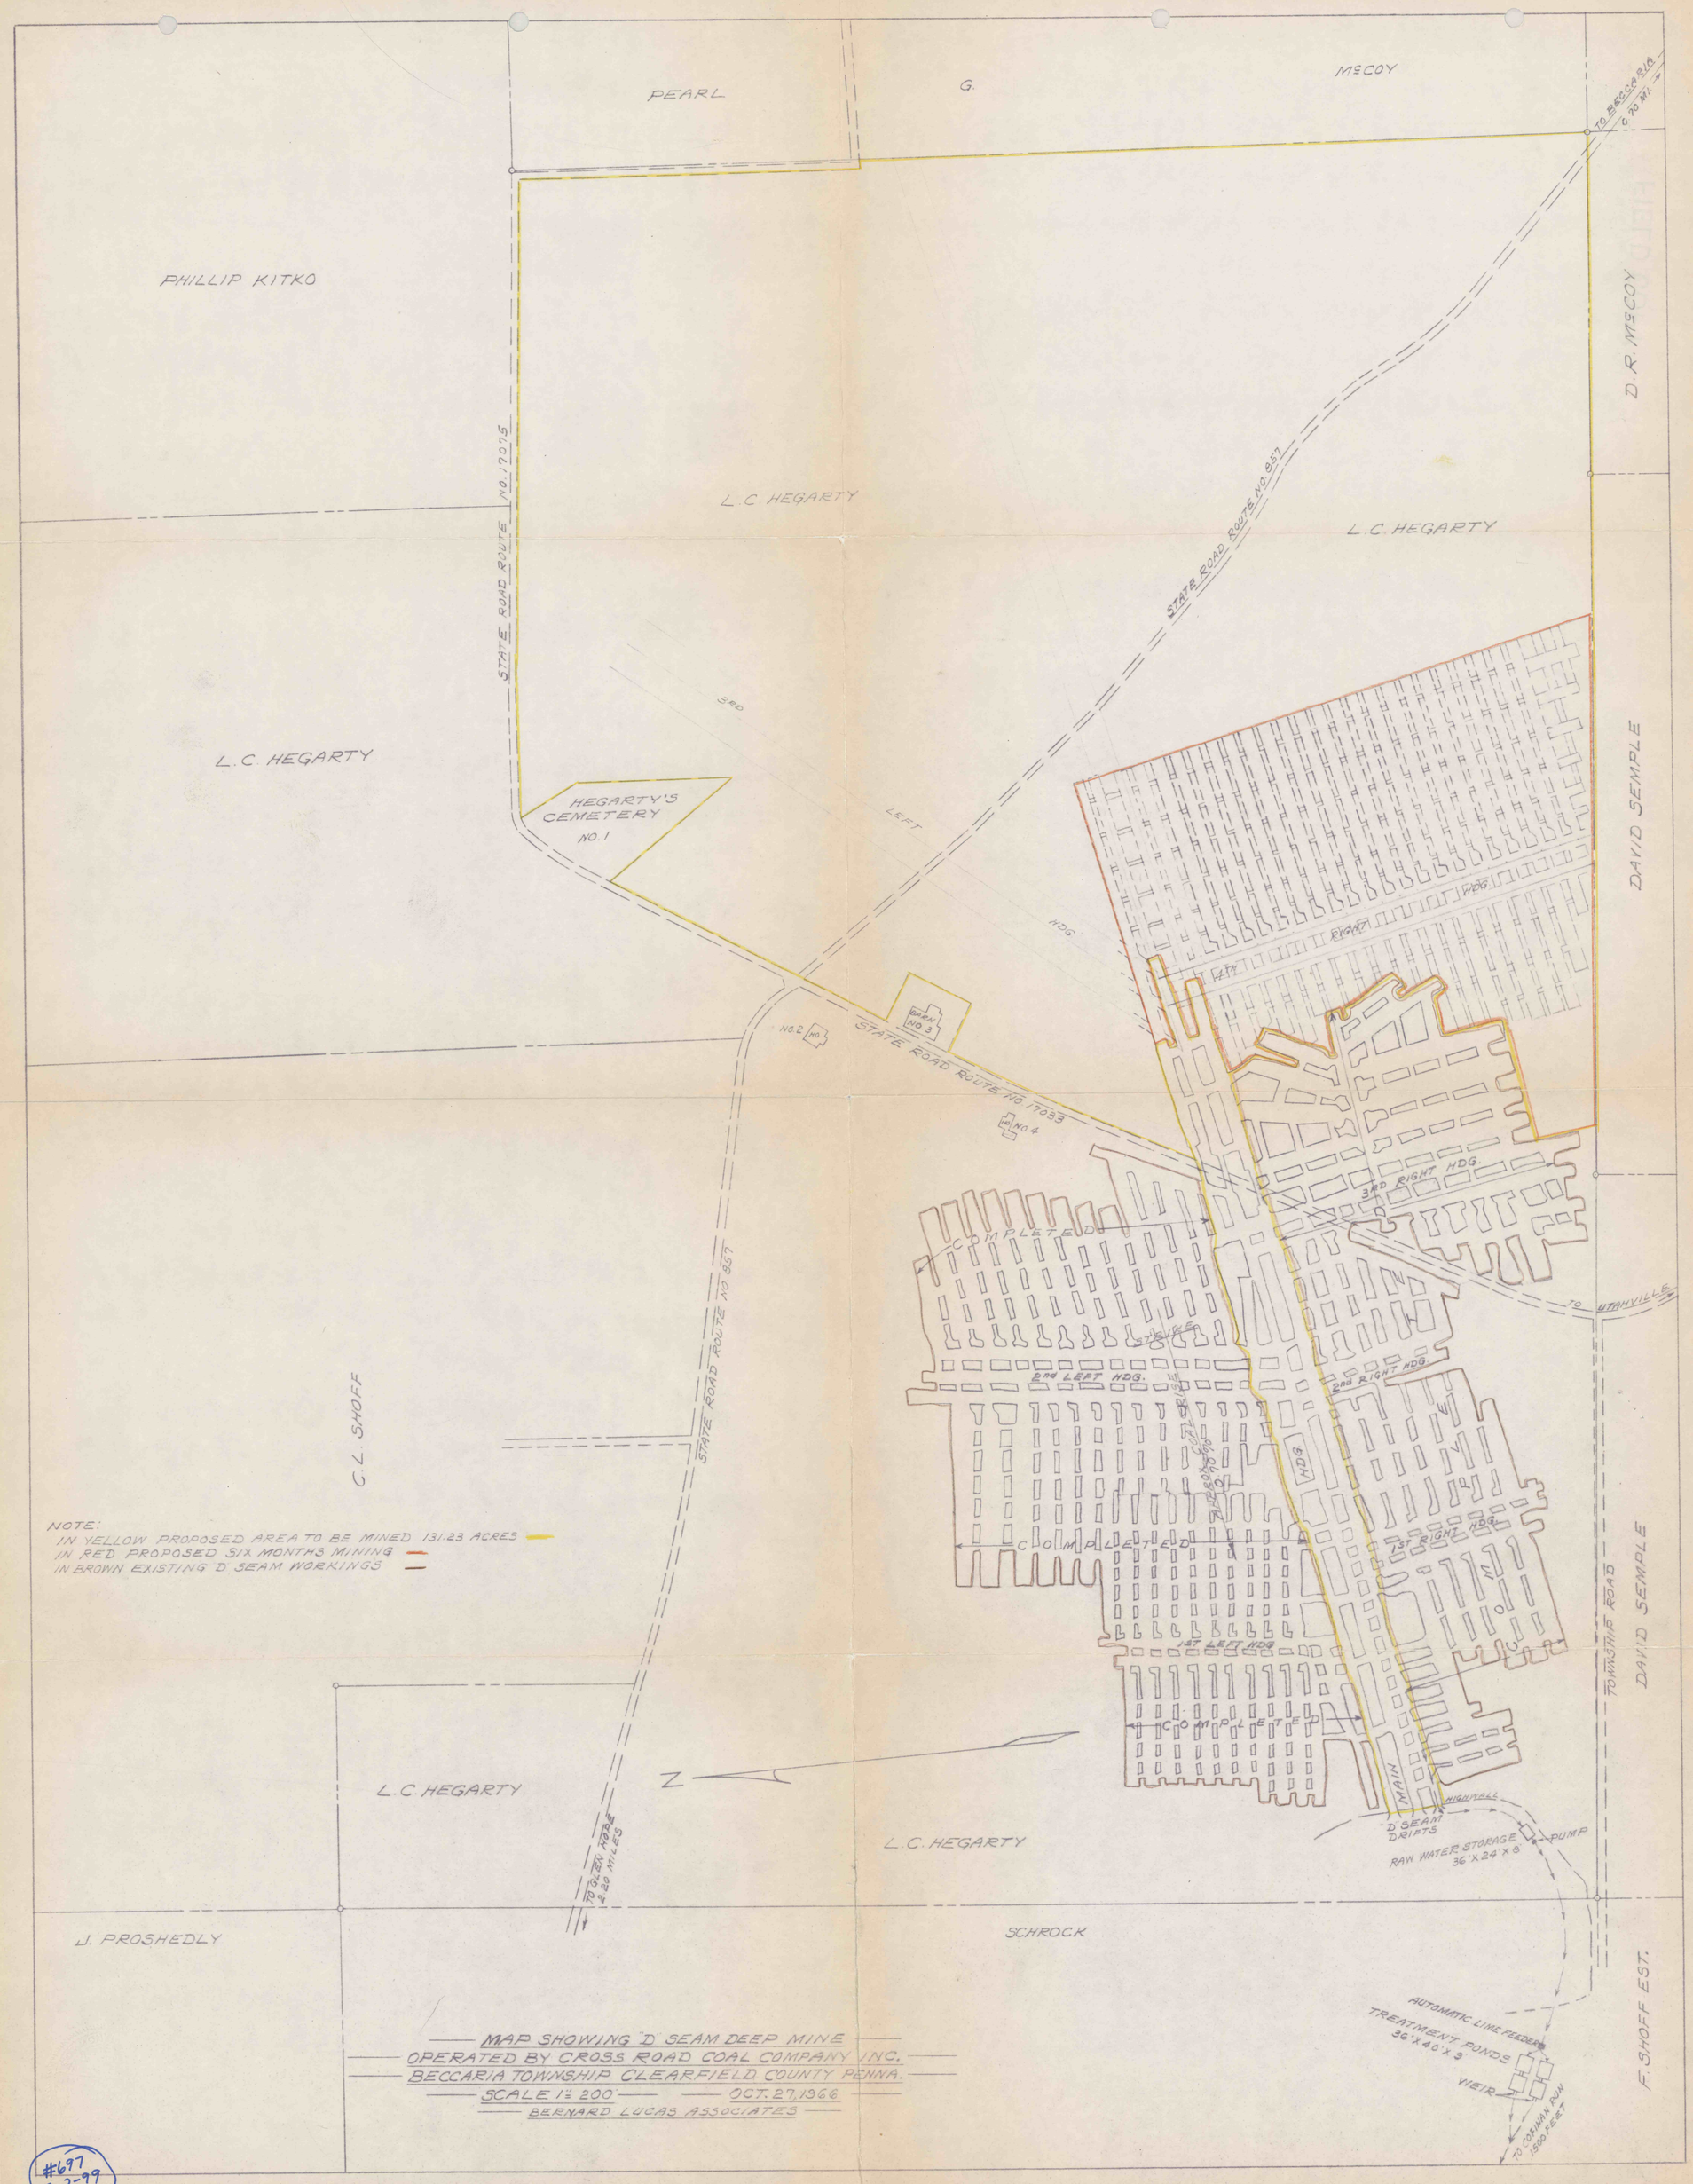
PEARL
G.
McCOY
TO BECCARIA 0.70 MI.
PHILLIP KITKO
D.R. McCOY
STATE ROAD ROUTE NO. 17075
L.C. HEGARTY
STATE ROAD ROUTE NO. 857
L.C. HEGARTY
3RD
LEFT
HDG
L.C. HEGARTY
HEGARTY'S CEMETERY NO. 1
DAVID SEMPLE
RIGHT
HDG
BARN NO. 3
NO. 2
NO. 4
STATE ROAD ROUTE NO. 17033
3RD RIGHT HDG.
COMPLETED
TO UTAHVILLE
STRIKE
2nd LEFT HDG.
2nd RIGHT HDG.
C.L. SHOFF
STATE ROAD ROUTE NO. 857
HDG
COMPLETED
1ST RIGHT HDG.
COMPLETED
1ST LEFT HDG
COMPLETED
TOWNSHIP ROAD
DAVID SEMPLE
NOTE:
IN YELLOW PROPOSED AREA TO BE MINED 131.23 ACRES
IN RED PROPOSED SIX MONTHS MINING
IN BROWN EXISTING 'D' SEAM WORKINGS
L.C. HEGARTY
N
L.C. HEGARTY
TO GLEN HOPE 2.20 MILES
MAIN
HIGHWALL
'D' SEAM DRIFTS
RAW WATER STORAGE 36'X24'X8'
PUMP
J. PROSHEDLY
SCHROCK
AUTOMATIC LIME FEEDER
TREATMENT PONDS 36'X40'X9'
WEIR
TO COFINAN RUN 1500 FEET
F. SHOFF EST.
MAP SHOWING 'D' SEAM DEEP MINE
OPERATED BY CROSS ROAD COAL COMPANY INC.
BECCARIA TOWNSHIP CLEARFIELD COUNTY PENNA.
SCALE 1" = 200'
OCT. 27, 1966
BERNARD LUCAS ASSOCIATES

#697
7-2-99
C.C.