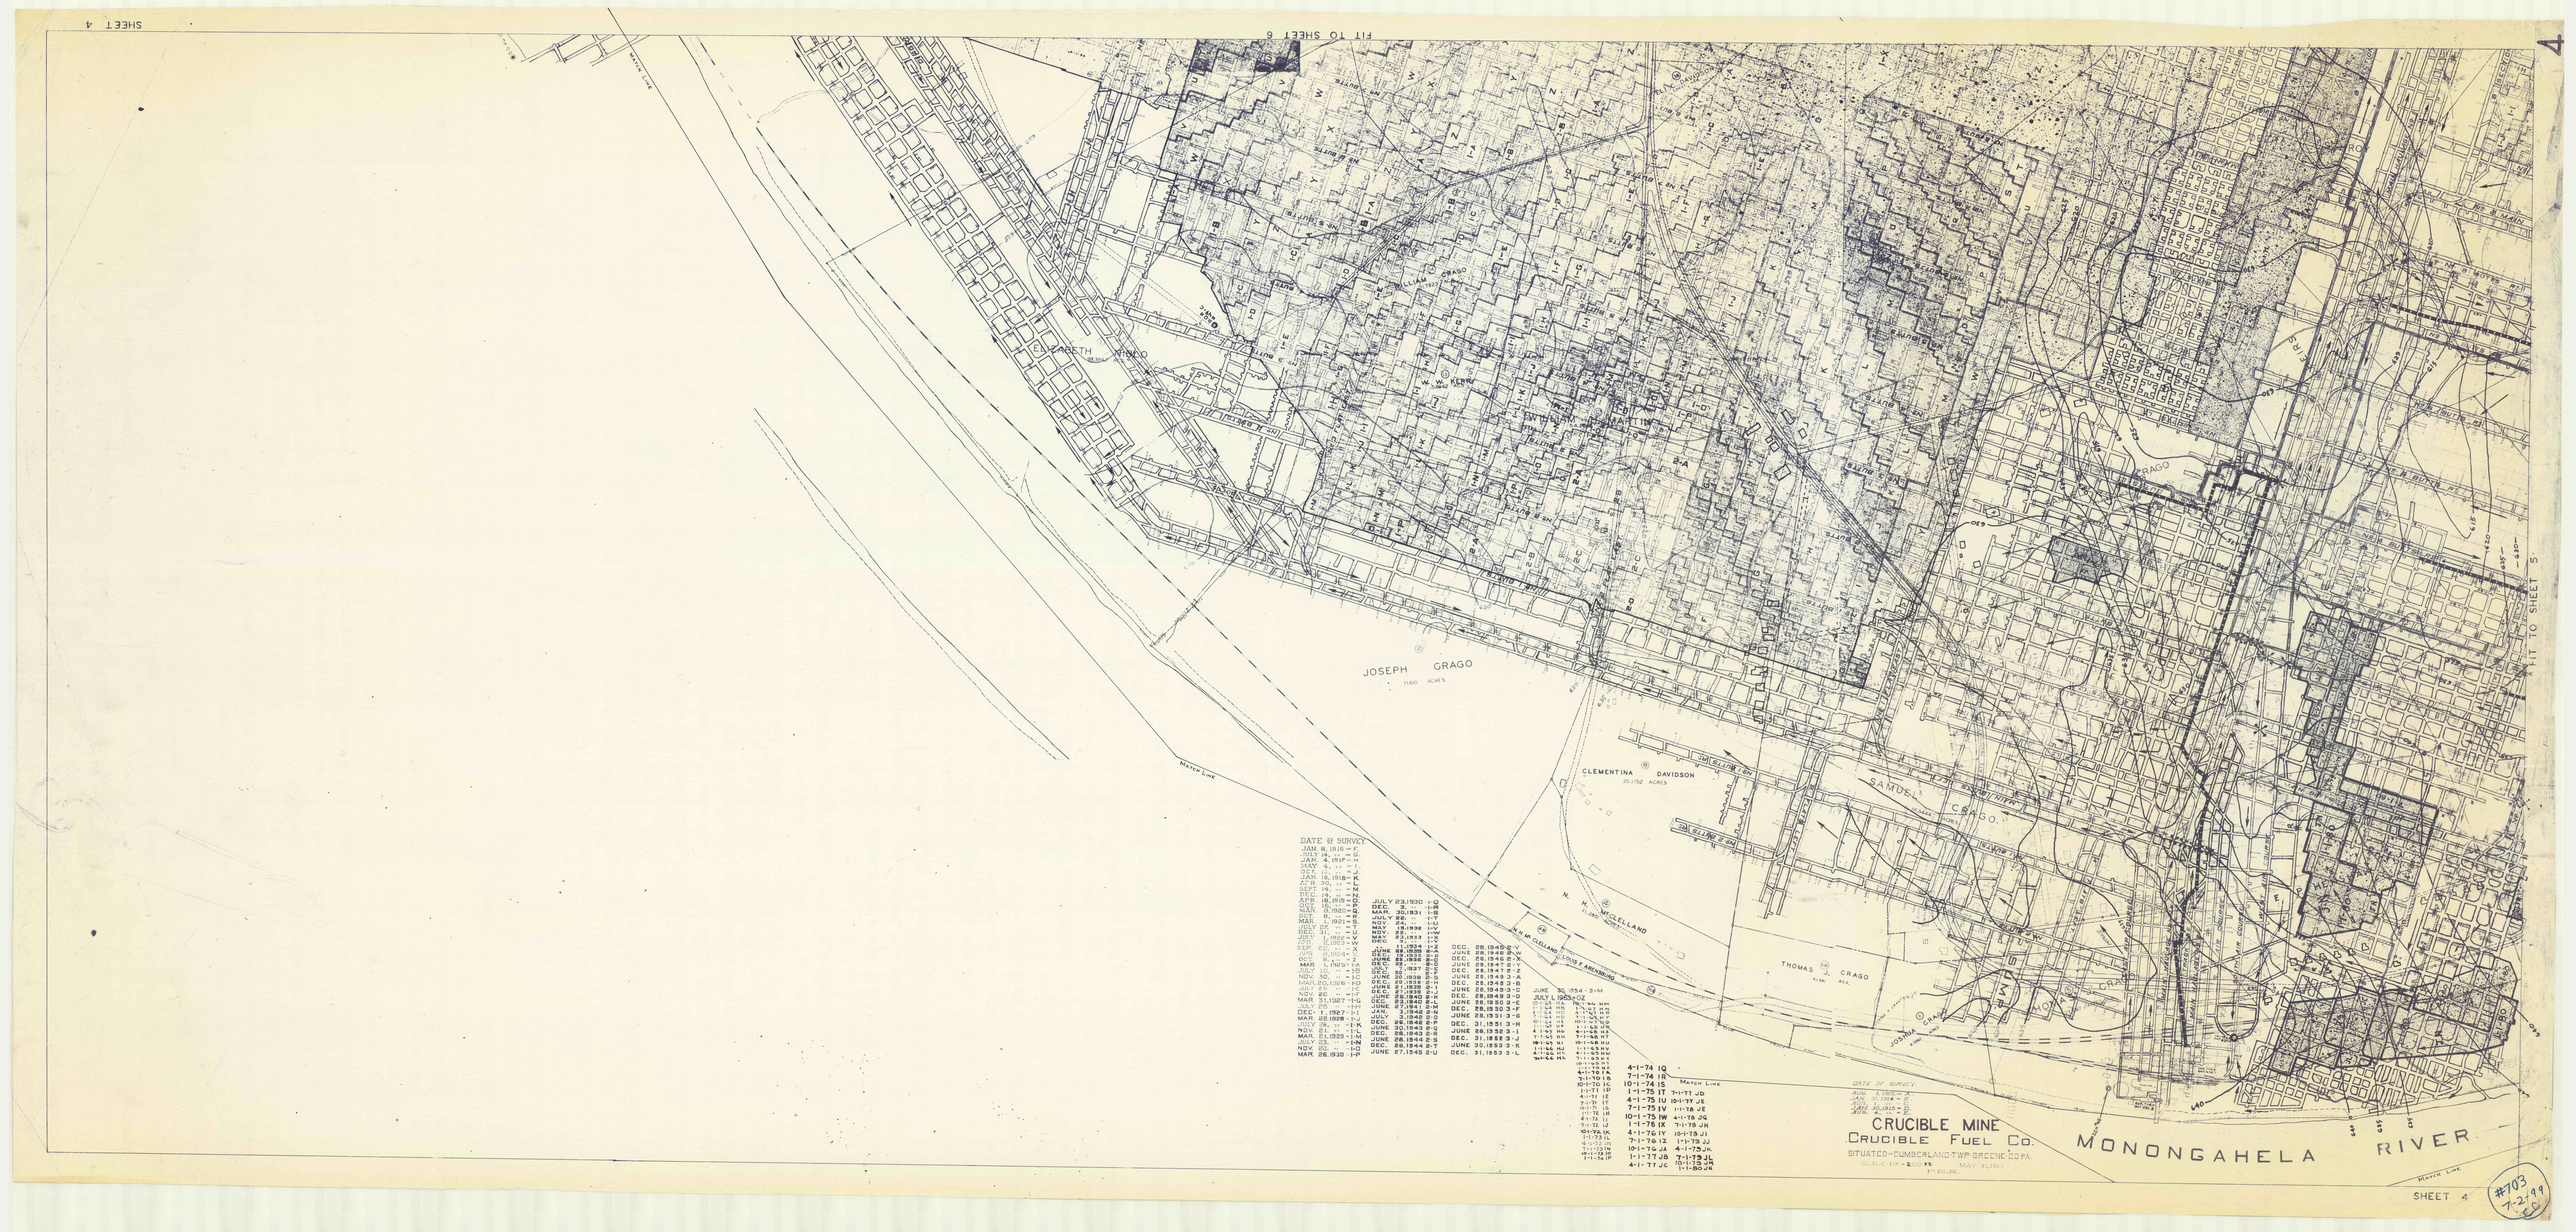
SHEET 4
FIT TO SHEET 6
FIT TO SHEET 5
4
JOSEPH GRAGO
TIGRO ACRES
CLEMENTINA DAVIDSON
20.1752 ACRES
SAMUEL C. GRAGO
THOMAS J. GRAGO
N. H. McCLELLAND
ILLINOIS & ARKANSAS
MARTIN
W. W. KERR
ELIZABETH
MARCO
GRAGO
MARSH LINE
MONONGAHELA RIVER
CRUCIBLE MINE
CRUCIBLE FUEL CO.
SITUATED-CUMBERLAND TWP. GREENE CO. PA.
SCALE 1" = 200 FT.
MAY 31, 1917
DATE OF SURVEY
JAN. 8, 1915 = F
JULY 14, 1917 = G
JAN. 4, 1917 = H
DEC. 12, = I
JAN. 16, 1918 = K
APR. 30, = L
DEC. 14, = M
APR. 18, 1919 = N
NOV. 15, = P
MAR. 8, 1920 = Q
NOV. 1, = R
MAR. 1, 1921 = S
JULY 27, = T
DEC. 31, 1924 = U
FEB. 1, 1926 = V
SEP. 22, = X
OCT. 8, 1926 = Y
NOV. 1, = Z
MAR. 1, 1927 = AA
JULY 13, = AB
NOV. 30, = AC
MAR. 20, 1926 = AD
NOV. 20, = AE
JULY 25, = AH
MAR. 31, 1927 = AG
JULY 29, = AH
DEC. 1, 1927 = AJ
MAR. 22, 1928 = AJ
JULY 26, = AK
MAR. 21, = AL
MAY 23, 1929 = AM
JULY 31, = AN
NOV. 20, = AP
MAR. 28, 1930 = AP
JULY 23, 1930 = AQ
DEC. 9, = AR
MAR. 30, 1931 = AS
NOV. 24, = AJ
MAY 19, 1938 = AV
JULY 1, = AW
NOV. 23, 1933 = AX
DEC. 1, = AY
JUNE 28, 1934 = AZ
JUNE 28, 1935 = BA
JUNE 28, 1936 = BB
DEC. 20, = BC
DEC. 20, 1937 = BE
JUNE 28, 1938 = BF
DEC. 20, 1938 = BH
DEC. 21, 1939 = BJ
JUNE 28, 1940 = BK
JUNE 27, 1941 = BM
JAN. 3, 1942 = BN
DEC. 31, 1942 = BO
JUNE 28, 1943 = BP
DEC. 28, 1943 = BQ
JUNE 28, 1944 = BR
DEC. 28, 1944 = BT
JUNE 27, 1945 = BU
DEC. 28, 1945 = BV
JUNE 28, 1946 = BW
DEC. 28, 1946 = BX
JUNE 28, 1947 = BY
DEC. 28, 1947 = BZ
JUNE 28, 1948 = CA
DEC. 28, 1948 = CB
JUNE 28, 1949 = CC
DEC. 28, 1949 = CD
JUNE 28, 1950 = CE
DEC. 28, 1950 = CF
JUNE 28, 1951 = CG
DEC. 31, 1951 = CH
JUNE 28, 1952 = CJ
DEC. 31, 1952 = CJ
JUNE 30, 1953 = CK
DEC. 31, 1953 = CL
JUNE 30, 1954 = CM
JULY 1, 1954 = CN
4-1-74 IQ
7-1-74 IR
10-1-74 IS
1-1-75 IT
4-1-75 IU
7-1-75 IV
10-1-75 IW
1-1-76 IX
4-1-76 IY
7-1-76 IZ
10-1-76 JA
1-1-77 JB
4-1-77 JC
7-1-77 JD
10-1-77 JE
1-1-78 JF
4-1-78 JG
7-1-78 JH
10-1-78 JJ
1-1-79 JJ
4-1-79 JK
7-1-79 JL
10-1-79 JM
1-1-80 JN
#703
7-2-99
SHEET 4