

YORKSHIRE COAL CO

MOSHANNON SMITHING COAL CORP.

PROPOSED MINING AREA
FROM
DEC 20, 1966 TO
JUNE 20, 1967

YORKSHIRE COAL CO.

MINING COMPLETED
MINING COMPLETED
MINING COMPLETED

'D' SEAM HIGH
50' BARRIER WALL


MINING COMPLETED

RUSSELL CAVANER

LEE ESTATE

LOW POINT PUMPING STA.

ABRAHAM NEVLING

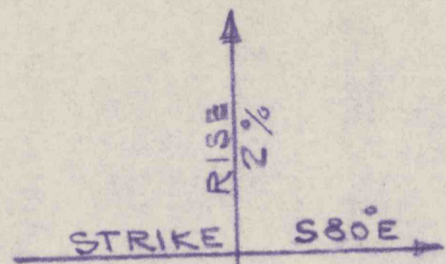

PORTAL

JOHN FIELDING

ABRAHAM NEVLING

DICK COAL CO
N^o 2 MINE LOWER FREEPORT SEAM
SITUATE

BECCARIA TWP. CLEARFIELD CO. PA
NOV. 1966

FIELD COPY

SCALE 1" = 200'
Martin C. Kirsch RE
Spangler Pa.

STRIP ROAD
ACCESS ROAD TO DEEP MINE

To Coalport T. 539
To Glen Hope

#909
7-8-99
C.C.