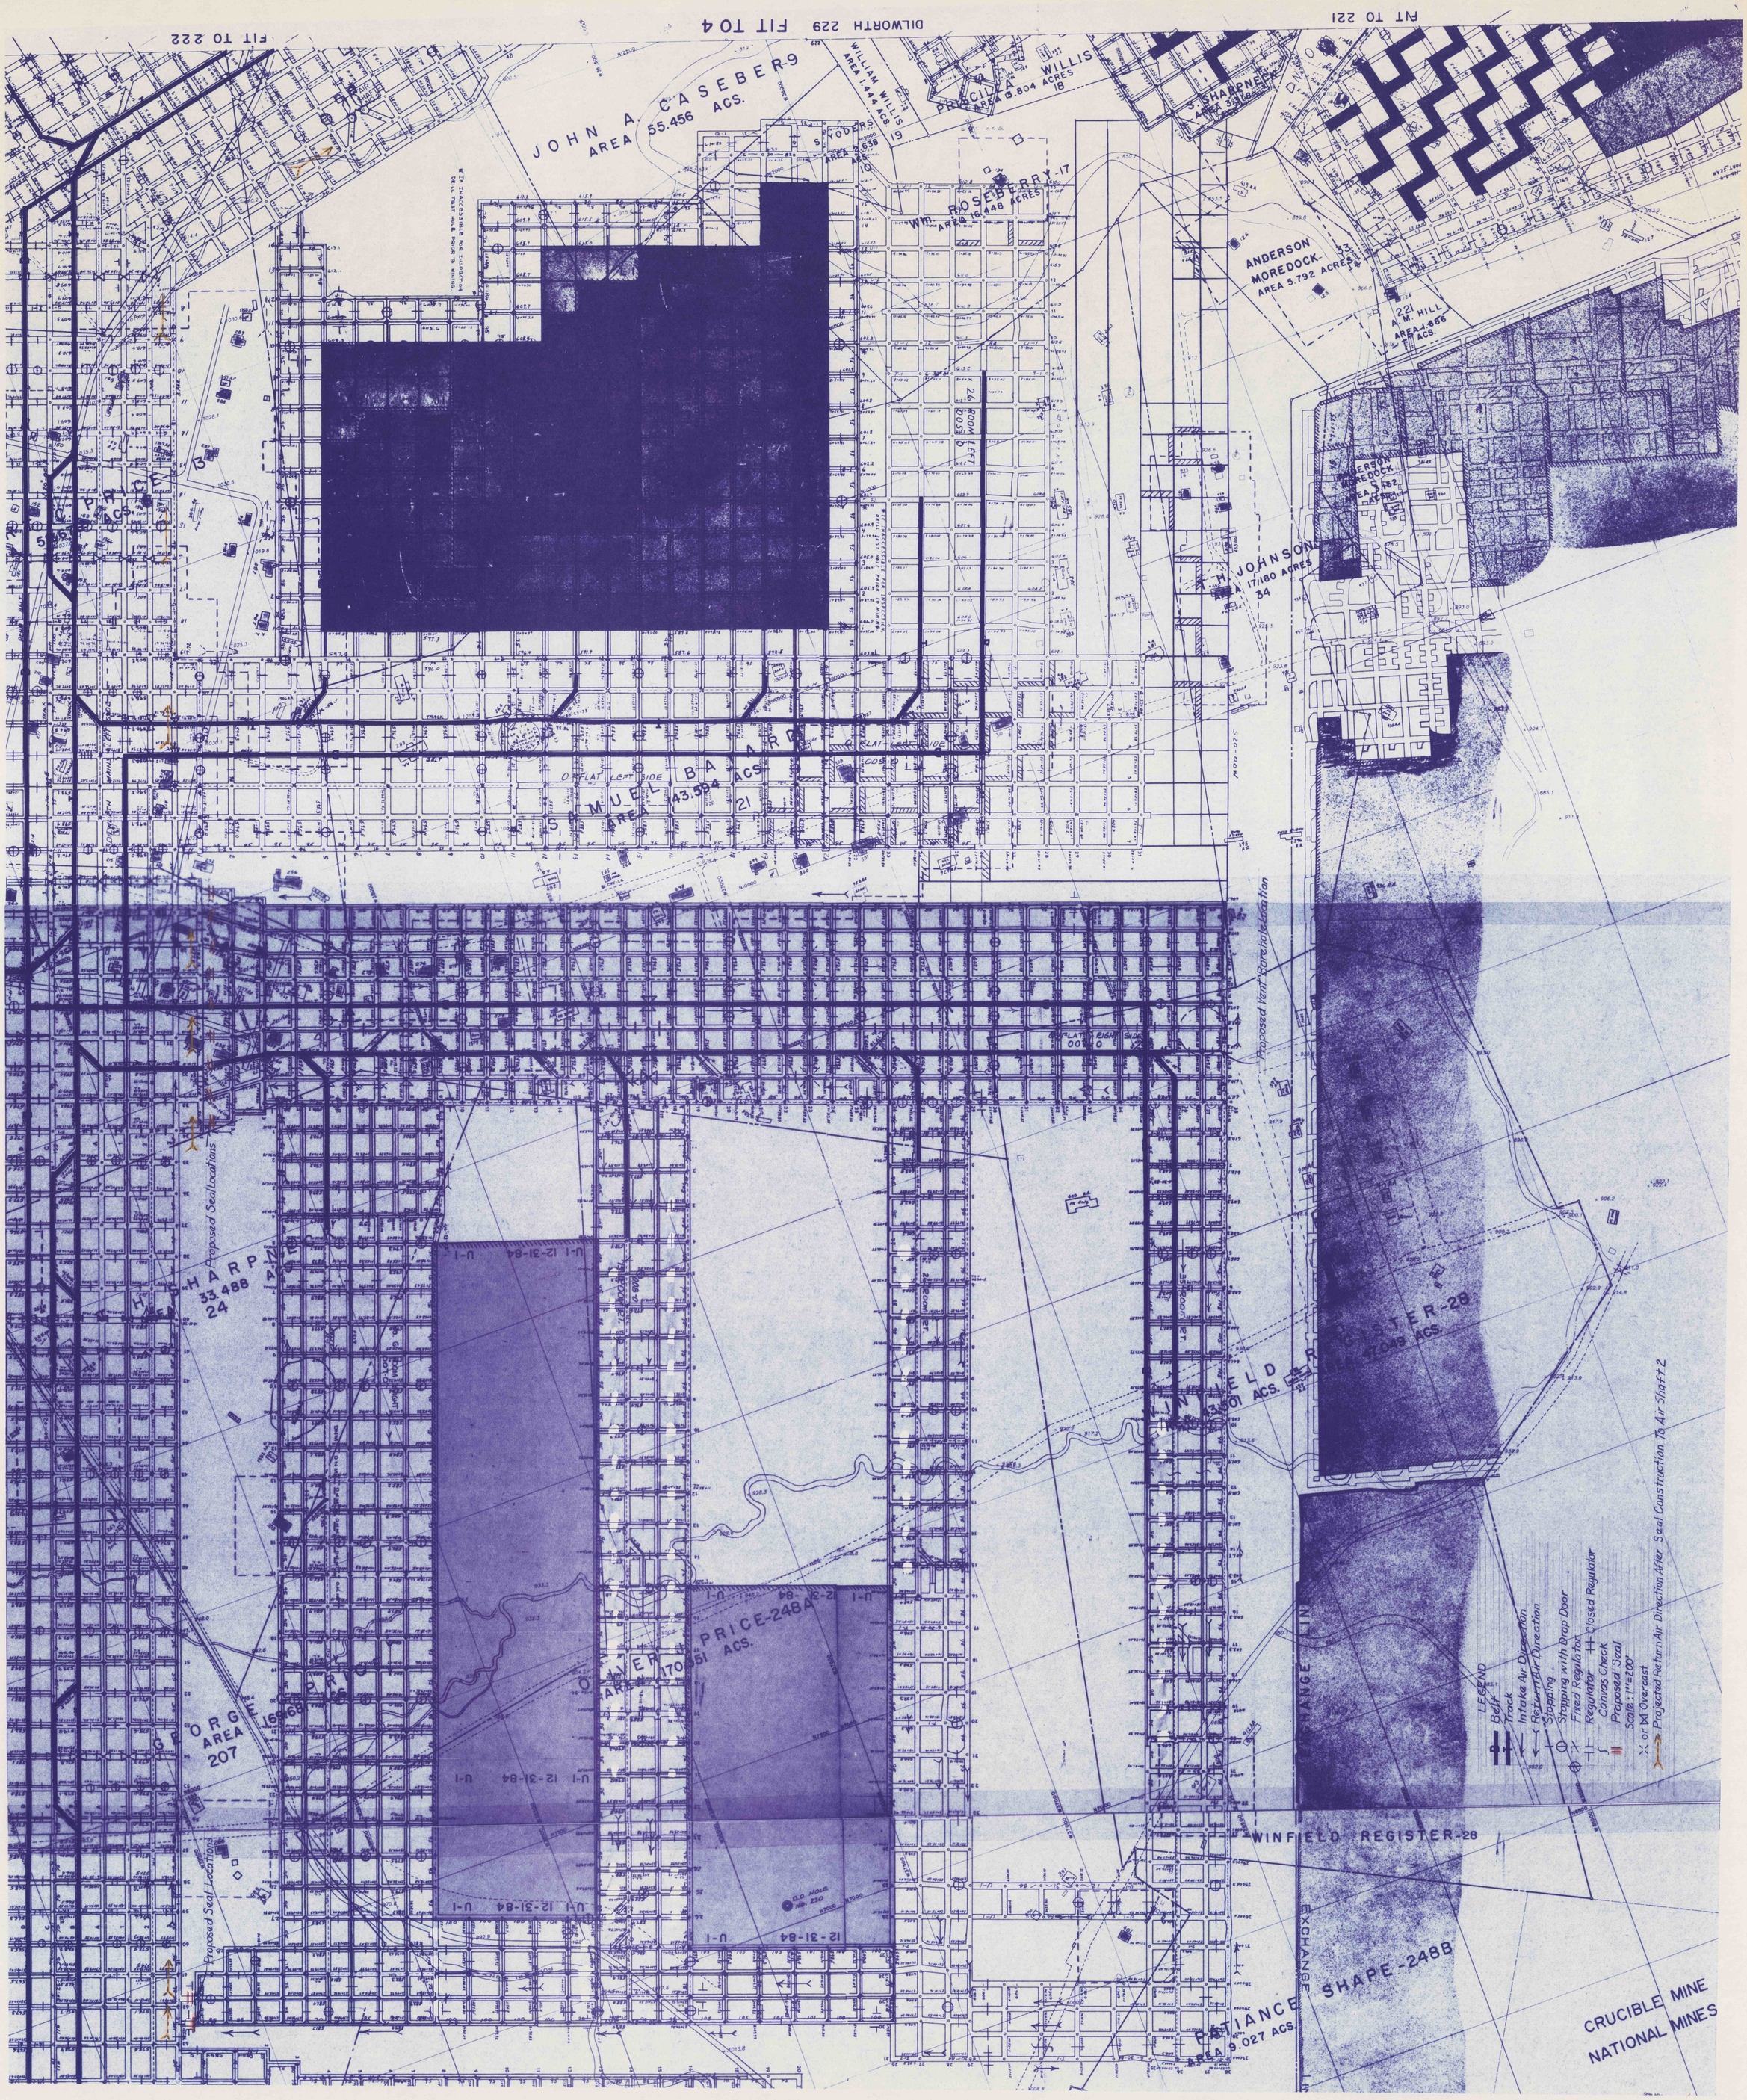
FIT TO 222
DILWORTH 229 FIT TO 4
FIT TO 221
JOHN A. CASEBER-9
AREA 55.456 ACS.
WILLIAM WILLIS
AREA 1.444 ACS.
19
PRISCILLA WILLIS
AREA 3.804 ACRES
18
S. SHARPNEK
AREA 33.188 ACS.
S. YODER
AREA 2.638 ACS.
WM. ROSEBERRY-17
AREA 16.448 ACRES
ANDERSON MOREDOCK-33
AREA 5.792 ACRES
221
A. M. HILL
AREA 1.666 ACS.
ANDERSON MOREDOCK
AREA 3.782 ACRES
M. JOHNSON
AREA 17.180 ACRES
34
26 ROOM LEFT
ROOM
SAMUEL BAIRD
AREA 43.594 ACS.
21
O. FLAT LEFT SIDE
O. FLAT RIGHT SIDE
Proposed Vent Borehole Location
Proposed Seal Locations
H. SHARPNEK
AREA 33.488 ACS.
24
U-1 12-31-84
GEORGE PRICE
AREA 16.868 ACS.
207
OLIVER PRICE-248A
AREA 17.051 ACS.
O.D. HOLE NO. 230
WINFIELD REGISTER-28
AREA 17.049 ACS.
EXCHANGE LINE
SHAPE-248B
RESTIANCE
AREA 9.027 ACS.
LEGEND
Belt
Track
Intake Air Direction
Return Air Direction
Stopping
Stopping with Drop Door
Fixed Regulator
Regulator
Closed Regulator
Canvas Check
Proposed Seal
Scale: 1"=200'
or Overcast
Projected Return Air Direction After Seal Construction To Air Shaft 2
CRUCIBLE MINE
NATIONAL MINES