



MSHA I.D. No. 36-06583 CMAP No. 33841303

Stanford

Doverspike Bros. Coal Co.
 R.D. #4, Box 271, Punxsutawney, PA 15767
 Porter & Perry Twp., Jefferson County


DORA #6 MINE

SCALE: 1" = 200' SHEET 12 of 24

Final Mine Map

- | | | |
|------------------------------|-----------------------------|---|
| — PERMIT AREA | GAS LINE | — MINE OPENINGS, SEALED |
| - - - PROPERTY LINES | ⊙ GAS WELL | — STREAMS |
| ① PROPERTY OWNERS | — T L TELE./ELEC. LINES | ▲ ₁₂ SURVEY STATION |
| ② CONT. PROPERTY OWNERS | ● WATER WELL | ▨ SUPPORT AREA (No Second Mining) |
| ■ PRE-66 DWELLINGS | ○ SPRING | ▩ L.F. DEEP MINE |
| ■ DWELLINGS, STRUCTURES | ⊙ DRILL HOLE | ▩ ZONE OF POTENTIAL INFLUENCE |
| ■ PROT. ACT 54 STRUCTURES | ▨ IMPOUNDMENT | ● GAS WELL BARRIER (No Mining Within Barrier Unless Approved) |
| — LK-1480 L.K. COAL CONTOURS | ◇ CEMETERY | ⊗ OVERCAST |
| ▨ L.K. COAL OUTCROP | — MINE OPENINGS, NOT SEALED | |

- INTAKE AIR
- RETURN AIR
- BELT LINE
- STOPPING
- STOPPING W/ DOOR
- CHECK CURTAIN
- REGULATOR
- DOUBLE DOORS
- RUN-THROUGH CHECK
- OVERCAST

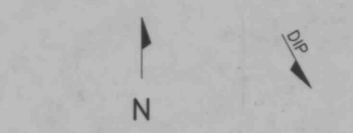

SURVEY IS CLOSED LOOP; ACCURACY IS 1:10000

INDIVIDUALS RESPONSIBLE FOR INFORMATION:
 CHARLES ISHMAN, ENGINEER & CHUCK MARTZ, SUPERINTENDENT
 MAP FULFILLS REQUIREMENTS OF 75.372 & 75.1200
 NO ADJACENT MINE WORKINGS WITHIN 1000 FEET
 NO MINE WORKINGS BELOW MINE PROPERTY



FINAL MINE MAP

SIGNATURE *Joseph P. Kalynychuk*

DATE 4-14-99