



MSHA I.D. No. 36-06583 CMAP No. 33841303

Stanford

Doverspike Bros. Coal Co.
R.D. #4, Box 271, Punxsutawney, PA 15767
Porter & Perry Twp., Jefferson County


DORA #6 MINE

SCALE: 1" = 200' SHEET 17 of 24

Final Mine Map

- | | | |
|--|---|--|
| <ul style="list-style-type: none"> — PERMIT AREA - - - PROPERTY LINES ① PROPERTY OWNERS ② CONT. PROPERTY OWNERS ③ PRE-66 DWELLINGS ④ DWELLINGS, STRUCTURES ⑤ PROT. ACT 54 STRUCTURES -LK-1480- L.K. COAL CONTOURS ▨ L.K. COAL OUTCROP | <ul style="list-style-type: none"> ⋯ GAS LINE ⊙ GAS WELL - T - TELE./ELEC. LINES ● WATER WELL ○ SPRING ○ DRILL HOLE ▨ IMPOUNDMENT ◇ CEMETERY ⋯ MINE OPENINGS, NOT SEALED | <ul style="list-style-type: none"> ◀ MINE OPENINGS, SEALED — STREAMS △ SURVEY STATION ▨ SUPPORT AREA (No Second Mining) ▨ L.F. DEEP MINE ▨ ZONE OF POTENTIAL INFLUENCE ● GAS WELL BARRIER (No Mining Within Barrier Unless Approved) ⋯ |
|--|---|--|

- INTAKE AIR
- RETURN AIR
- BELT LINE
- STOPPING
- STOPPING W/ DOOR
- CHECK CURTAIN
- REGULATOR
- DOUBLE DOORS
- RUN-THROUGH CHECK
- OVERCAST

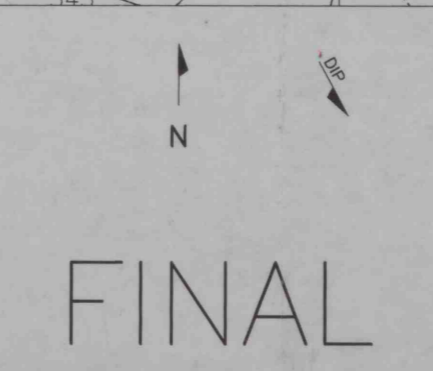

SURVEY IS CLOSED LOOP; ACCURACY IS 1:10000

INDIVIDUALS RESPONSIBLE FOR INFORMATION:
CHARLES ISHMAN, ENGINEER & CHUCK MARTZ, SUPERINTENDENT

MAP FULFILLS REQUIREMENTS OF 75.372 & 75.1200

NO ADJACENT MINE WORKINGS WITHIN 1000 FEET

NO MINE WORKINGS BELOW MINE PROPERTY

FINAL MINE MAP

SIGNATURE: *Joseph P. Kalyanchuk*

DATE: 4-14-99