



MSHA I.D. No. 36-06583 CMAP No. 33841303

**Stanford**

**Doverspike Bros. Coal Co.**  
R.D. #4, Box 271, Punxsutawney, PA 15767  
Porter & Perry Twp., Jefferson County


**DORA #6 MINE**

SCALE: 1" = 200' SHEET 23 of 24

Final Mine Map

- |                                |                             |   |
|--------------------------------|-----------------------------|---|
| — PERMIT AREA                  | ..... GAS LINE              | — MINE OPENINGS, SEALED                                       |
| - - - PROPERTY LINES           | ⊛ GAS WELL                  | — STREAMS   |
| ① PROPERTY OWNERS              | — T TELE./ELEC. LINES       | ⊕ SURVEY STATION  |
| ② CONT. PROPERTY OWNERS        | • WATER WELL                | ▨ SUPPORT AREA (No Second Mining)                             |
| ▲ PRE-66 DWELLINGS             | ○ SPRING                    | ▨ L.F. DEEP MINE  |
| ■ DWELLINGS, STRUCTURES        | ⊙ DRILL HOLE                | ▨ ZONE OF POTENTIAL INFLUENCE                                 |
| ▤ PROT. ACT 54 STRUCTURES      | ⊞ IMPOUNDMENT               | ⊙ GAS WELL BARRIER (No Mining Within Barrier Unless Approved) |
| — LK-1480 L.K. COAL STRUCTURES | ◇ CEMETERY                  | ⊗ OVERCAST  |
| ▨ L.K. COAL OUTCROP            | — MINE OPENINGS, NOT SEALED |   |

- |                     |
|---------------------|
| — INTAKE AIR        |
| — RETURN AIR        |
| — BELT LINE         |
| — STOPPING          |
| — STOPPING W/ DOOR  |
| — CHECK CURTAIN     |
| — REGULATOR         |
| — DOUBLE DOORS      |
| — RUN-THROUGH CHECK |
| — OVERCAST          |

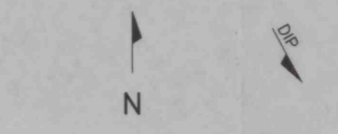

SURVEY IS CLOSED LOOP; ACCURACY IS 1:10000

INDIVIDUALS RESPONSIBLE FOR INFORMATION:  
CHARLES ISHMAN, ENGINEER & CHUCK MARTZ, SUPERINTENDENT

MAP FULFILLS REQUIREMENTS OF 75.372 & 75.1200

NO ADJACENT MINE WORKINGS WITHIN 1000 FEET

NO MINE WORKINGS BELOW MINE PROPERTY

# FINAL MINE MAP



SIGNATURE *Joseph P. Kalychuk*

DATE 4-14-99