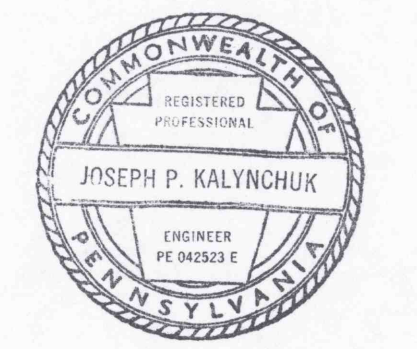

Doverspike Bros. Coal Co.
 R.D. #4, Box 271, Punxsutawney, PA 15767
 Perry Twp., Jefferson Co., North Mahoning Twp., Indiana Co.

Dora No. 8 Mine
 SCALE: 1" = 200' SHEET 1 of 8
MODULE 19.5

<p>--- PERMIT AREA</p> <p>--- PROPERTY LINES</p> <p>① PROPERTY OWNERS</p> <p>② CONT. PROPERTY OWNERS</p> <p>■ DWELLINGS, STRUCTURES</p> <p>⚠ PROTECTED ACT 54 STRUCTURE</p> <p>—LK-1480— L.K. COAL CONTOURS</p> <p>—LK/LK— L.K. COAL OUTCROP</p>	<p>—G— GAS LINE</p> <p>⊙ GAS WELL</p> <p>—T— TELE./ELEC. LINES</p> <p>• WATER WELL</p> <p>○ SPRING</p> <p>○ DRILL HOLE</p> <p>⊞ IMPONDMENT</p> <p>← MINE OPENINGS, NOT SEALED</p> <p>→ MINE OPENINGS, SEALED</p>	<p>--- STREAMS</p> <p>⊕ SURVEY STATION</p> <p>⊞ ZONE OF POTENTIAL INFLUENCE</p> <p>--- CONTEMPLATED MINING 11/1/98 TO 5/1/99</p> <p>--- 6 MONTH PROJECTIONS</p> <p>● GAS WELL BARRIER (No Mining Within Barrier Unless Approved)</p> <p>▨ NO MINING AREA</p>
--	--	--

Final Mining by:
Doverspike Bros. Coal Co.



SIGNATURE: *Joseph P. Kalynchuk*
 DATE: 4-15-99