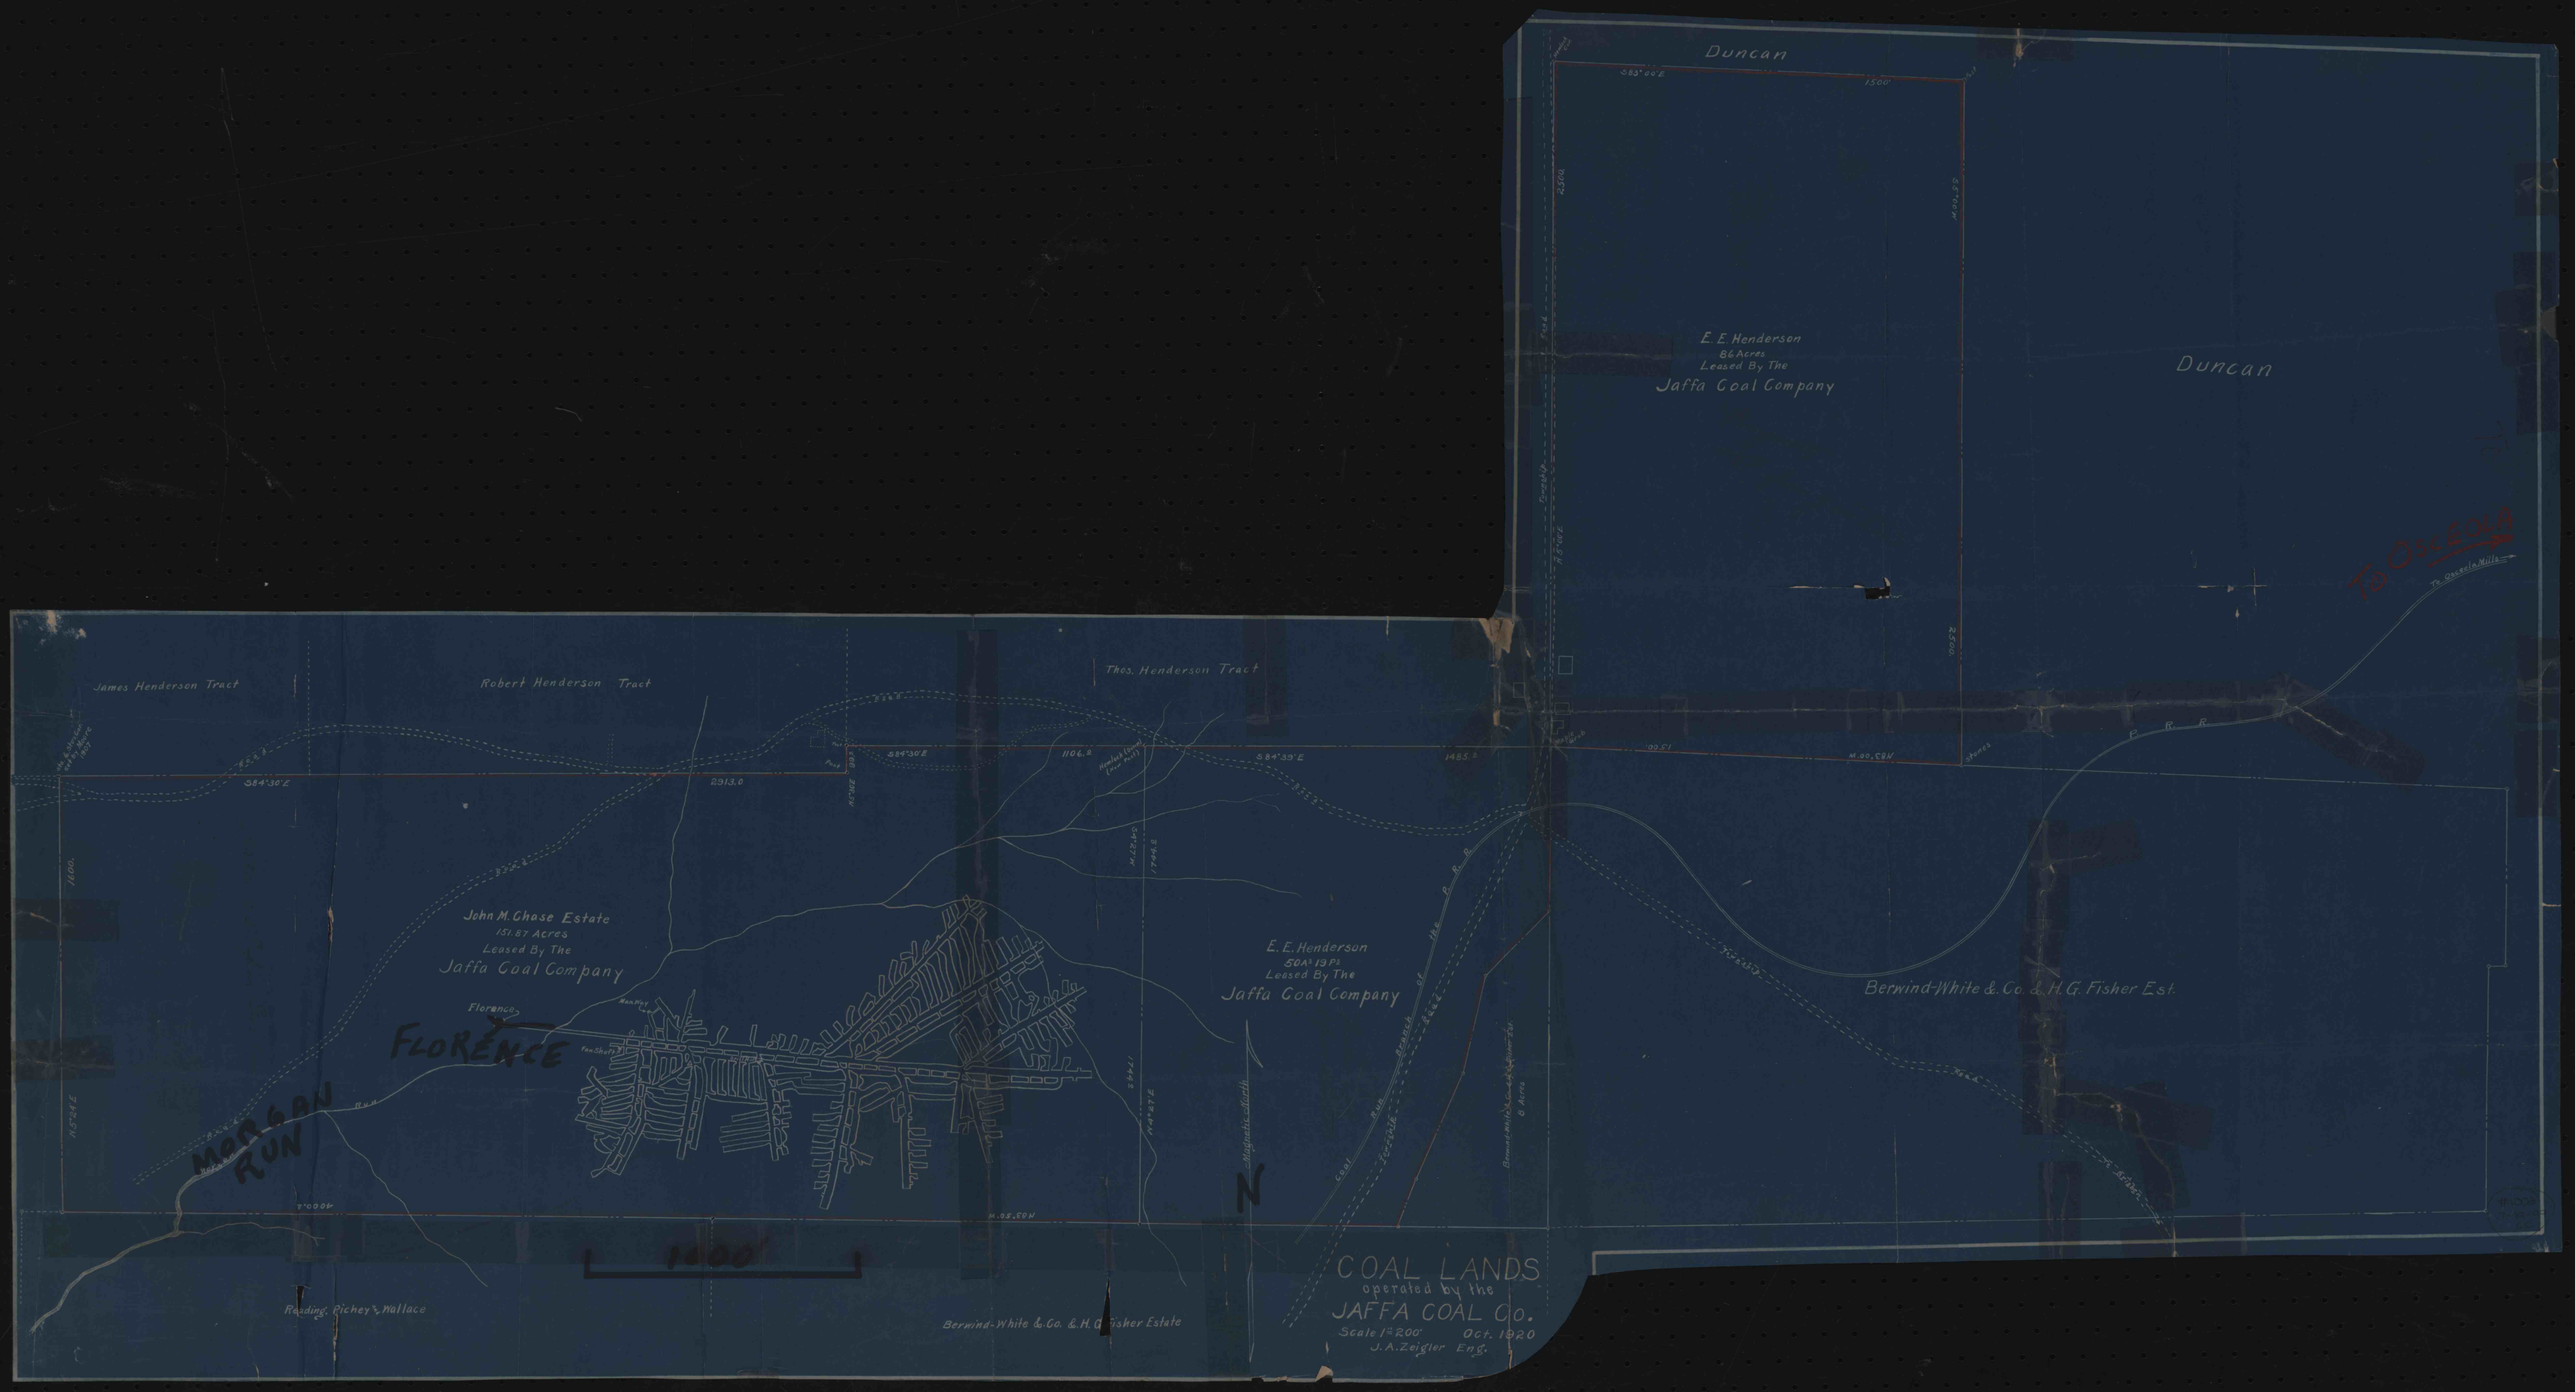
Duncan
S83°00'E
1500'
E. E. Henderson
86 Acres
Leased By The
Jaffa Coal Company
Duncan
To Osceola
To Osceola Mills
James Henderson Tract
Robert Henderson Tract
Thos. Henderson Tract
S84°30'E
2913.0
S84°30'E
1106.2
S84°33'E
1485.2
N.00, 58W
John M. Ghase Estate
151.87 Acres
Leased By The
Jaffa Coal Company
E. E. Henderson
50A. 13P.
Leased By The
Jaffa Coal Company
Berwind-White & Co. & H.G. Fisher Est.
Florence
FLORENCE
MORGAN RUN
Main Plot
Fan Shaft
Reading, Pichey & Wallace
Berwind-White & Co. & H.G. Fisher Estate
1400'
N
COAL LANDS
operated by the
JAFFA COAL Co.
Scale 1" = 200'
Oct. 1920
J.A. Zeigler Eng'r.