




- Area Worked to July-1966
- Area To Work July-1966 Bottom Coal To Jan-1967
- Area To work Top Coal To Jan-1967

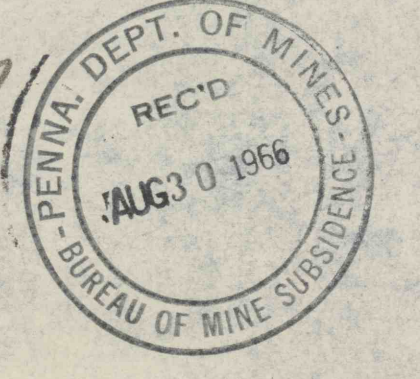

G.M. & W. Coal Co. Broad Top Twp Bedford Co. Penna.
Aug 1966 E. Corrie