


To Rockwood 3.5 Mi. approx.  
PAUL ROMESBURG  
Rt. 653

HARRY SANNER

CLYDE JUDY FARM

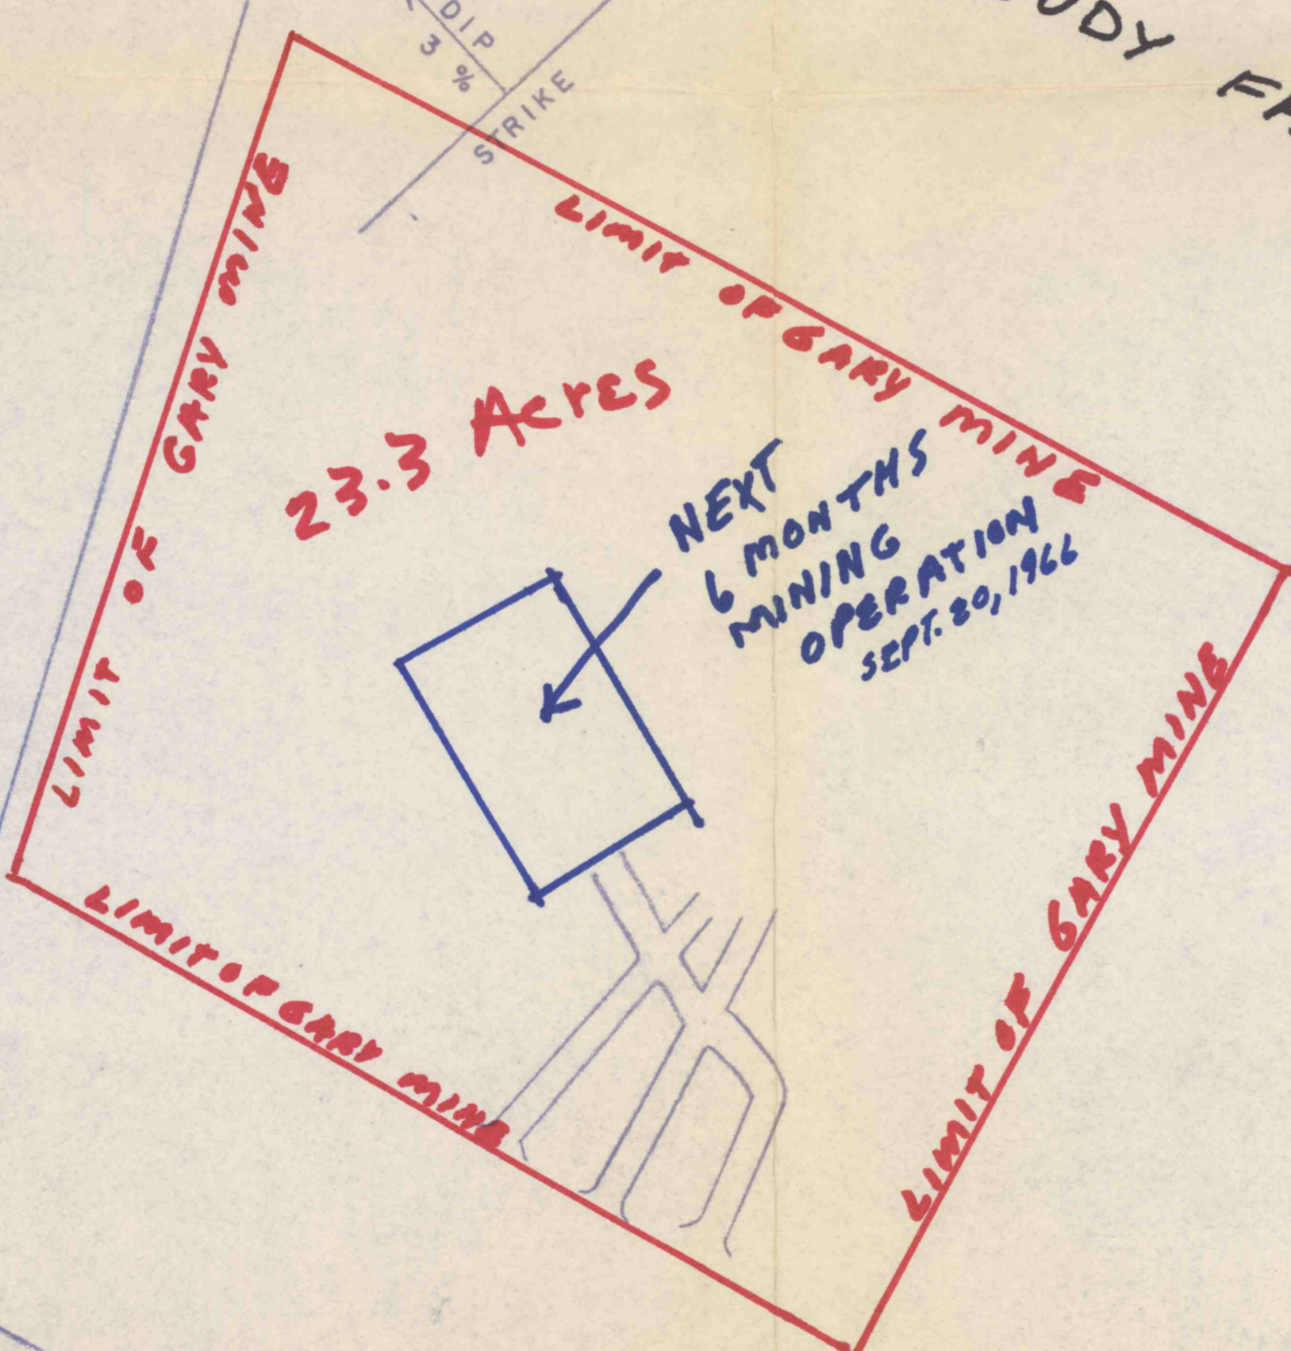

DAVID DUNMEYER

RUSSEL KELLER

ELY & FRENCH

LESTER GARY ——— MINE  
BLACK TWP. SOMERSET CO. PA.  
SCALE 1" = 200' SEPT. 14, 1966  
A-COAL

Mine work not surveyed by ELY & FRENCH.



#1082  
7-22-99  
C.C.

FIELD COPY