

#1087
7-22-99
C.C.

SHEET No. 12
GATEWAY MINE


FIT TO SHEET No. 16

FIT TO SHEET No. 16

FIT TO SHEET No. 13

FITS TO SHEET No. 13

SHEET No. 12
GATEWAY MINE

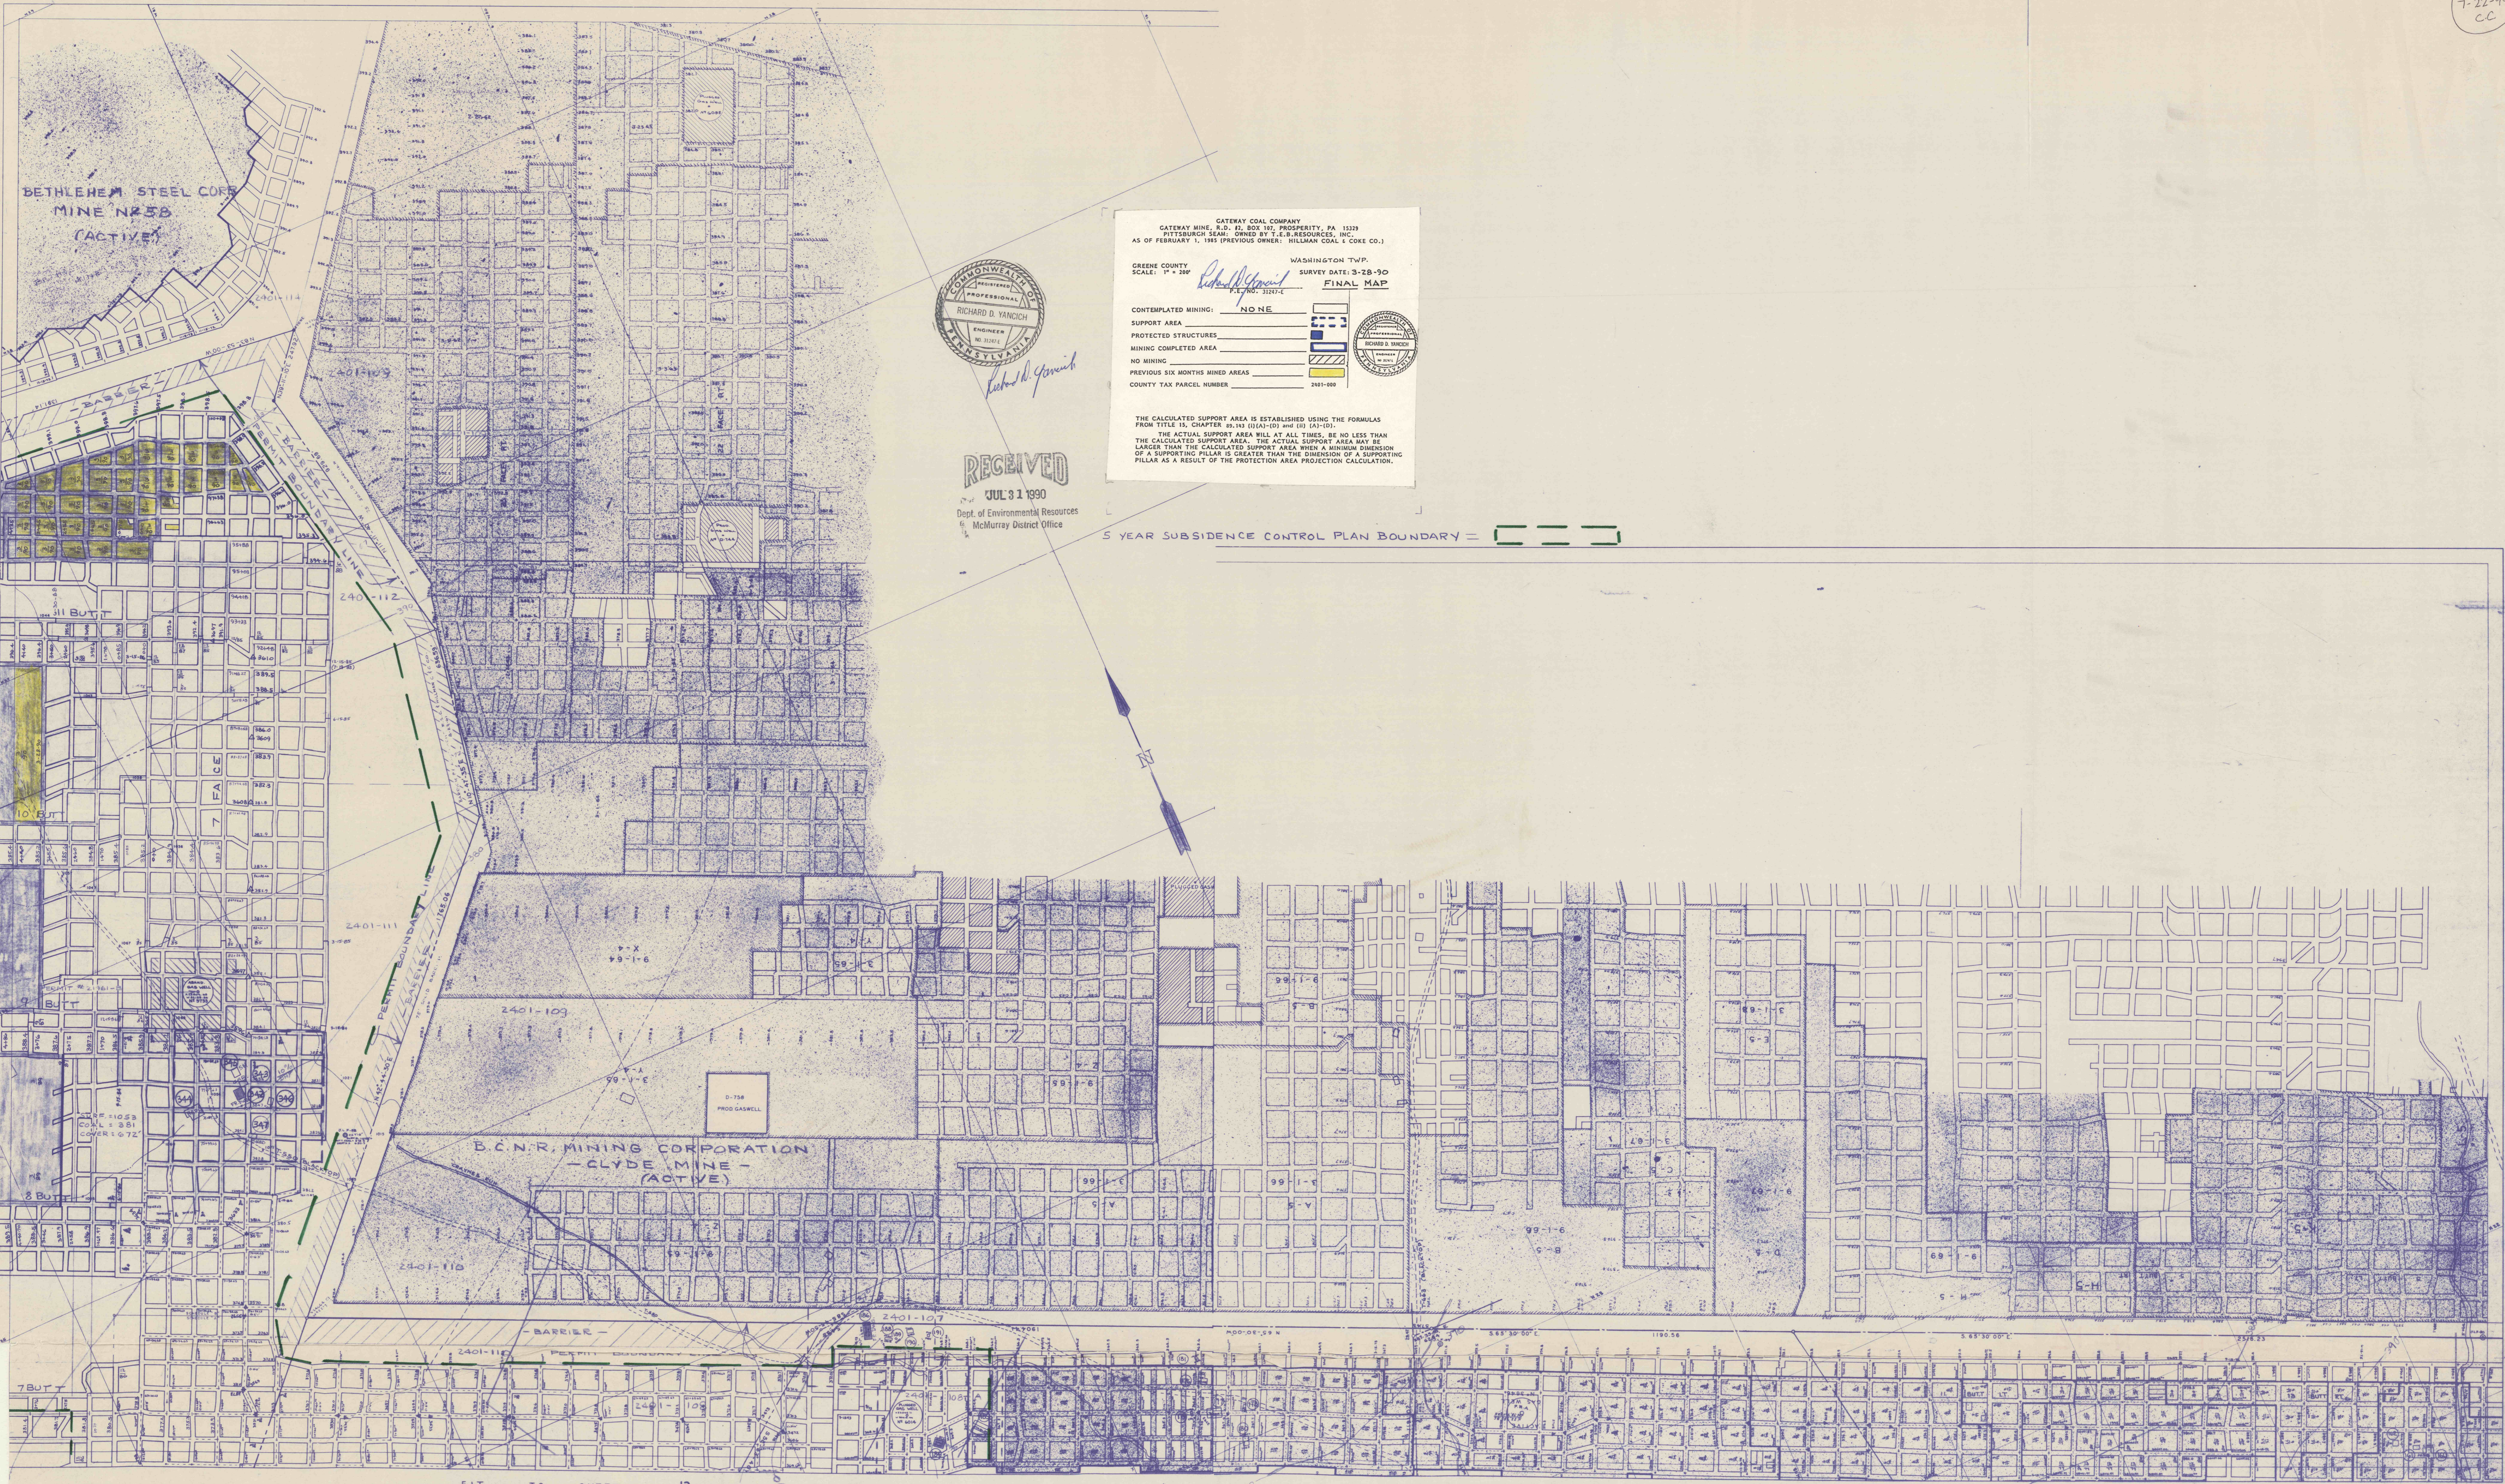

GATEWAY COAL COMPANY
 GATEWAY MINE, R.D. #1, BOX 107, PROSPERITY, PA 15229
 PITTSBURGH SEAM, OWNED BY T. E. B. RESOURCES, INC.
 AS OF FEBRUARY 1, 1985 (PREVIOUS OWNER: HILLMAN COAL & COKE CO.)

WASHINGTON TWP.
 SURVEY DATE: 3-28-90
FINAL MAP

GREENE COUNTY
 SCALE: 1" = 200'

Richard D. Yandich
 PROFESSIONAL ENGINEER
 RICHARD D. YANDICH
 ENGINEER
 PENNSYLVANIA

CONTEMPLATED MINING: **NO NE**

SUPPORT AREA: [Symbol]

PROTECTED STRUCTURES: [Symbol]

MINING COMPLETED AREA: [Symbol]

NO MINING: [Symbol]

PREVIOUS SIX MONTHS MINED AREAS: [Symbol]

COUNTY TAX PARCEL NUMBER: 2401-000

THE CALCULATED SUPPORT AREA IS ESTABLISHED USING THE FORMULAS FROM TITLE 15, CHAPTER 89.93 (A)(1)-(D) AND (B) (A)-(D).
 THE ACTUAL SUPPORT AREA WILL AT ALL TIMES, BE NO LESS THAN THE CALCULATED SUPPORT AREA. THE ACTUAL SUPPORT AREA MAY BE LARGER THAN THE CALCULATED SUPPORT AREA WHEN A MINIMUM DIMENSION OF A SUPPORTING PILLAR IS GREATER THAN THE DIMENSION OF A SUPPORTING PILLAR AS A RESULT OF THE PROTECTION AREA PRODUCTION CALCULATION.

RECEIVED
 JUL 31 1990
 Dept. of Environmental Resources
 McMurray District Office

5 YEAR SUBSIDENCE CONTROL PLAN BOUNDARY = [Symbol]