


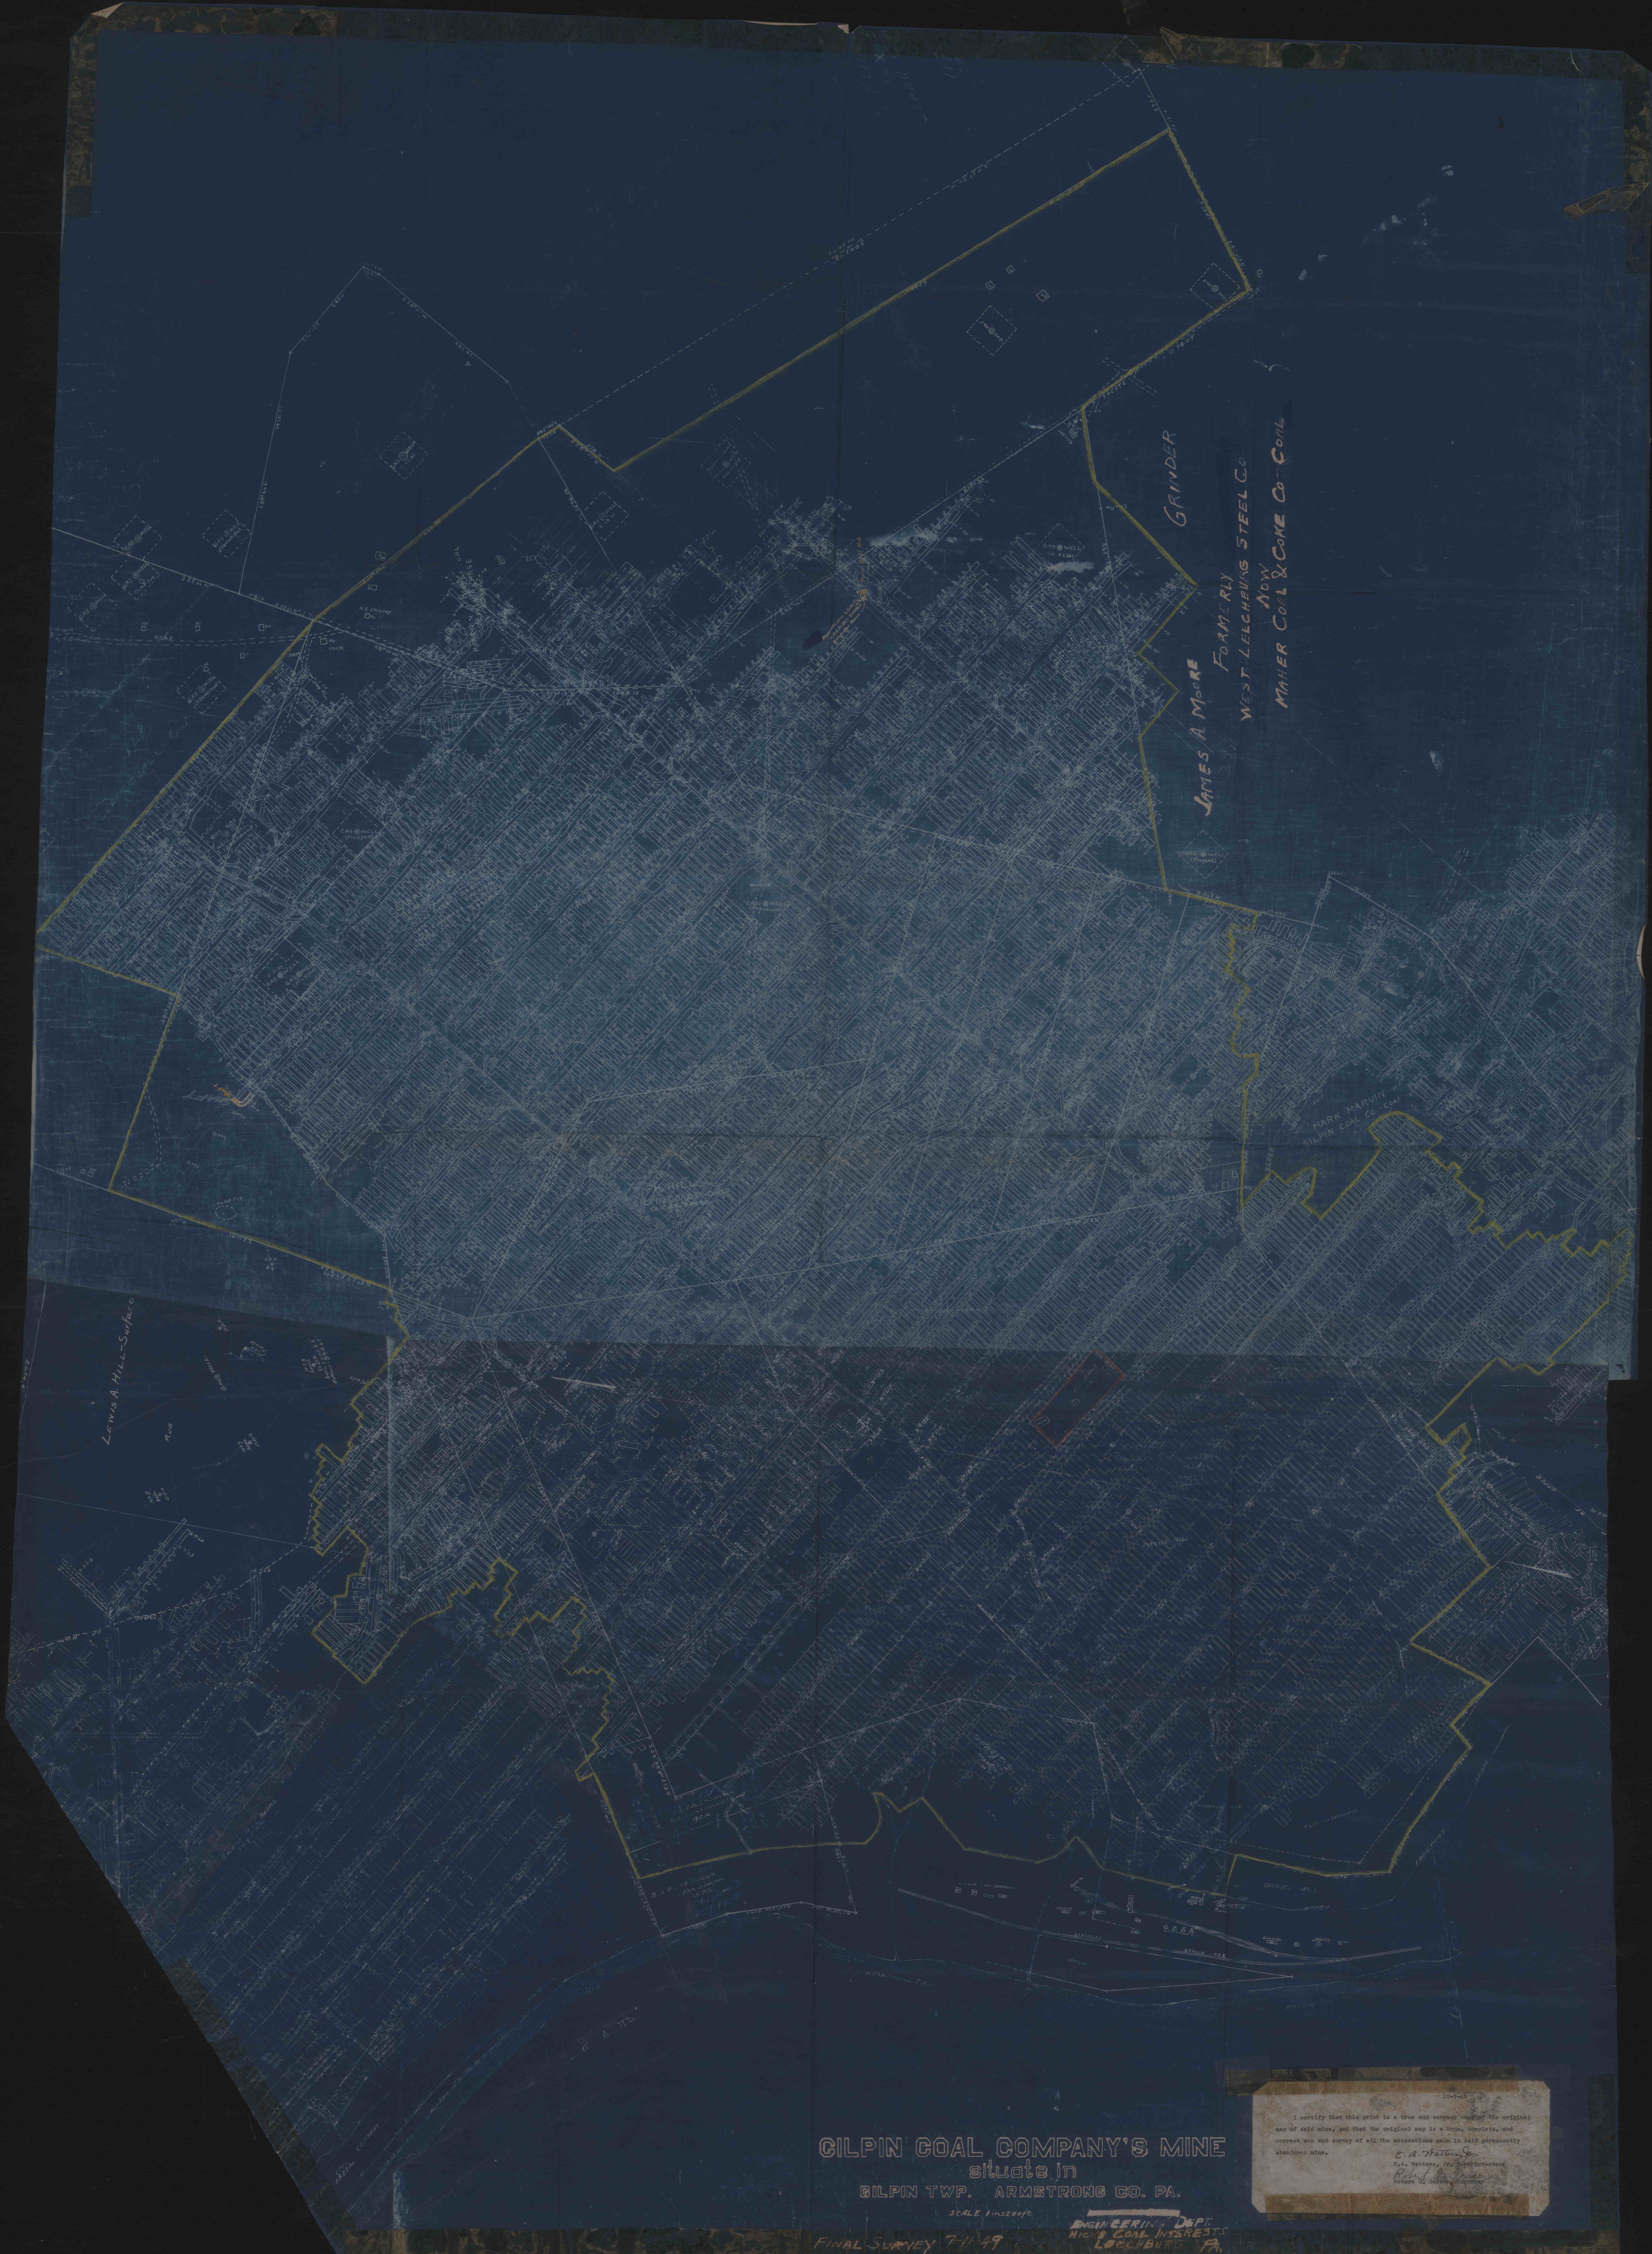

GILPIN COAL COMPANY'S MINE
situate in
GILPIN TWP. ARMSTRONG CO. PA.

SCALE 1 in = 200 ft.

FINAL SURVEY 7-11-49

ENGINEER IN CHARGE
NICHOLS COAL INTERESTS
LOCKSBURG, PA.

I certify that this print is a true and correct copy of the original map of said mine, and that the original map is a true, complete, and correct map and survey of all the excavations made in said permanently established mine.
E. A. Hatten, Jr.
S.A. Hatten, Jr., Superintendent
Robert W. Hatten, Engineer