

BERNARD MYERS

ALTOONA COAL & COKE CO.


MAXIMUM COVER 180'

FIRST MINING ONLY
GREEN - 6 MONTH PROJECTION
7-28-1966

FRANCIS GATES MINE
GALLITZIN TWP.
CAMBRIA CO.
PENNSYLVANIA

SCALE 1"=200' AUGUST 5 1964
S.W. DUKES R.P.E. 14468

GWIN ENGINEERS INC.
1200 12th AVENUE
ALTOONA, PENNSYLVANIA 16601

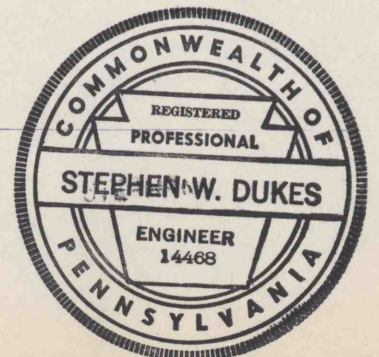

#1117
7-23-99
C.C.