


FIELD COPY


BERNARD MYERS

REVISIONS :	
1	MARCH 15, 1967
2	SEPT. 15, 1967
3	
4	
5	
6	

ALTOONA COAL & COKE CO.

JAMES C. WILT

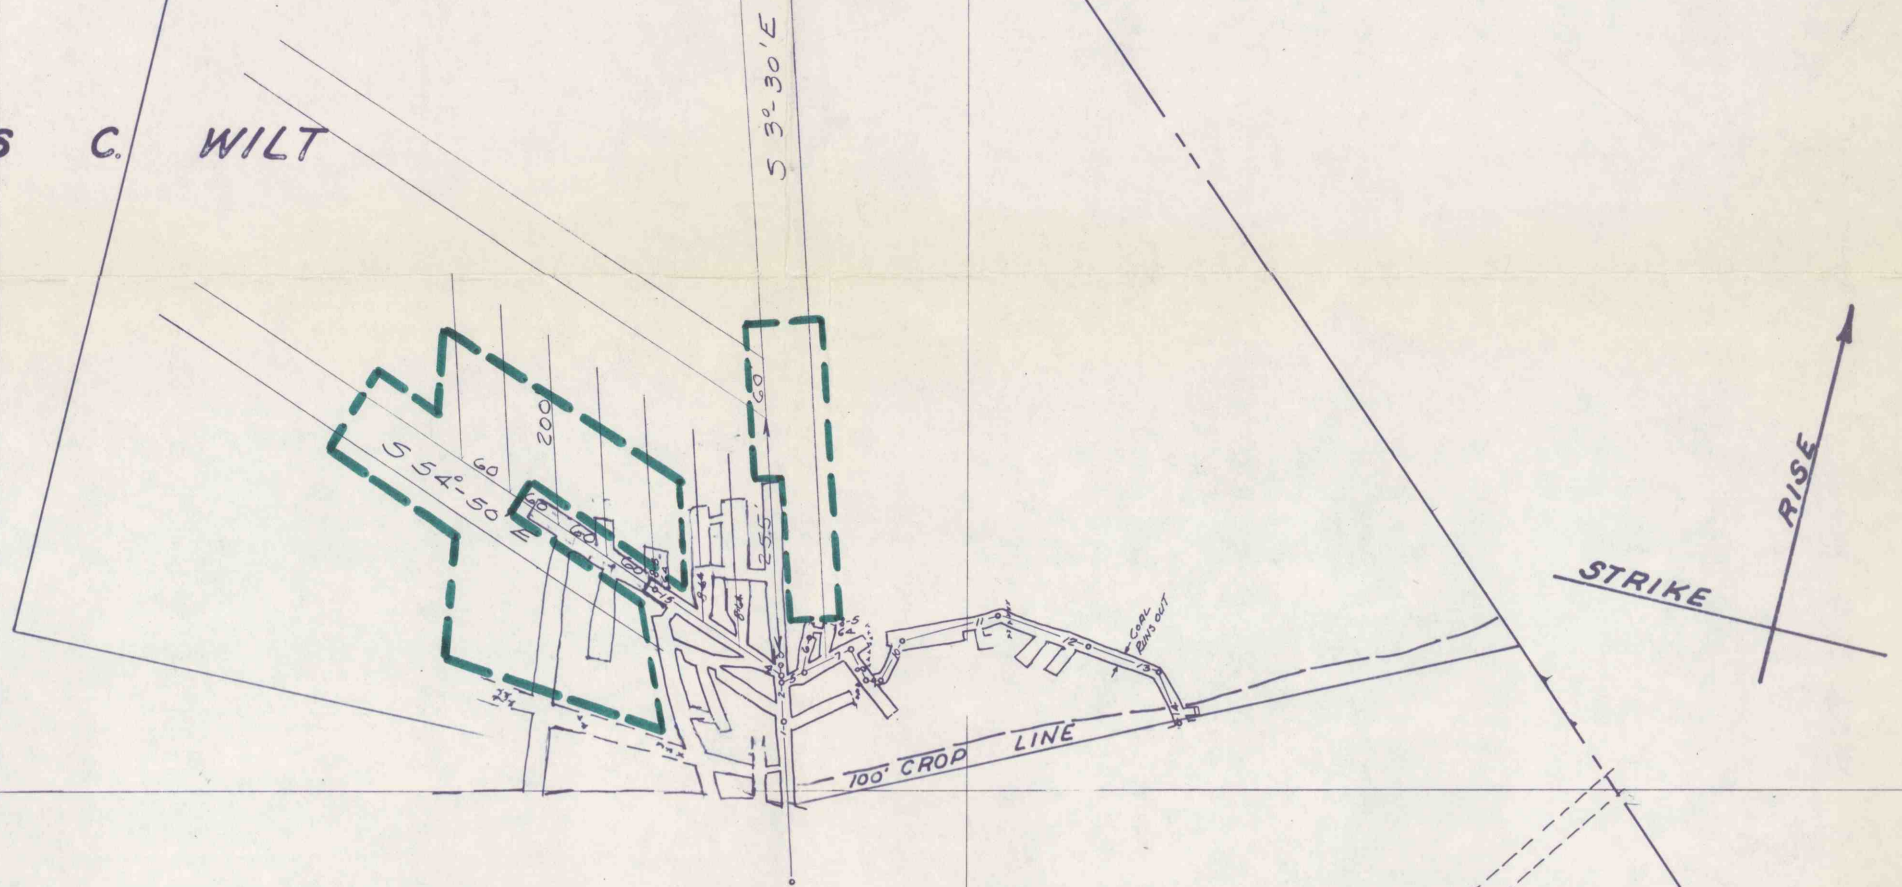

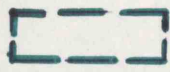 Mining Area  
 Sept. 1967-Mar. 1968  
 9-15-67 3-15-68

PERMIT N° 12-1  
 GLENDALE N° 2  
 FRANCIS GATES MINE  
 GALLITZIN TWP.  
 CAMBRIA CO.  
 PENNSYLVANIA


SCALE 1"=200' AUGUST 5 1964  
S. W. DUKES R.P.E. 14468


ASHVILLE

BOROUGH

TO ASHVILLE  
1/2 MI.

Prepared by  
 GWIN ENGINEERS, INC.  
 Consulting Engineers  
 ALTOONA, PENN., 15004

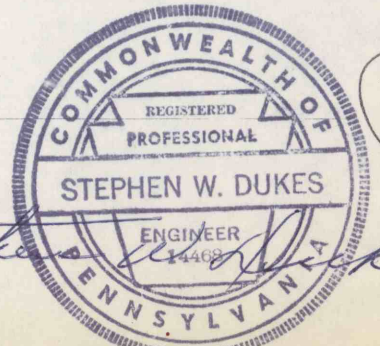

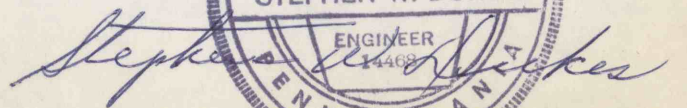  
 Stephen W. Dukes