

14
J. ARTHUR
99,689 Ac.
(Fee)

15
ANNA GOSS
98,153 Ac.
(Fee)

16
PHIL WHEELER
10,000 Ac.
(Fee)

A4-11

A4-9

A4-6

A4-7

A4-A


A4-5

FIRST MINING ONLY

FIRST MINING ONLY

FIRST MINING ONLY

MINING ONLY INSIDE BARRIER LINES

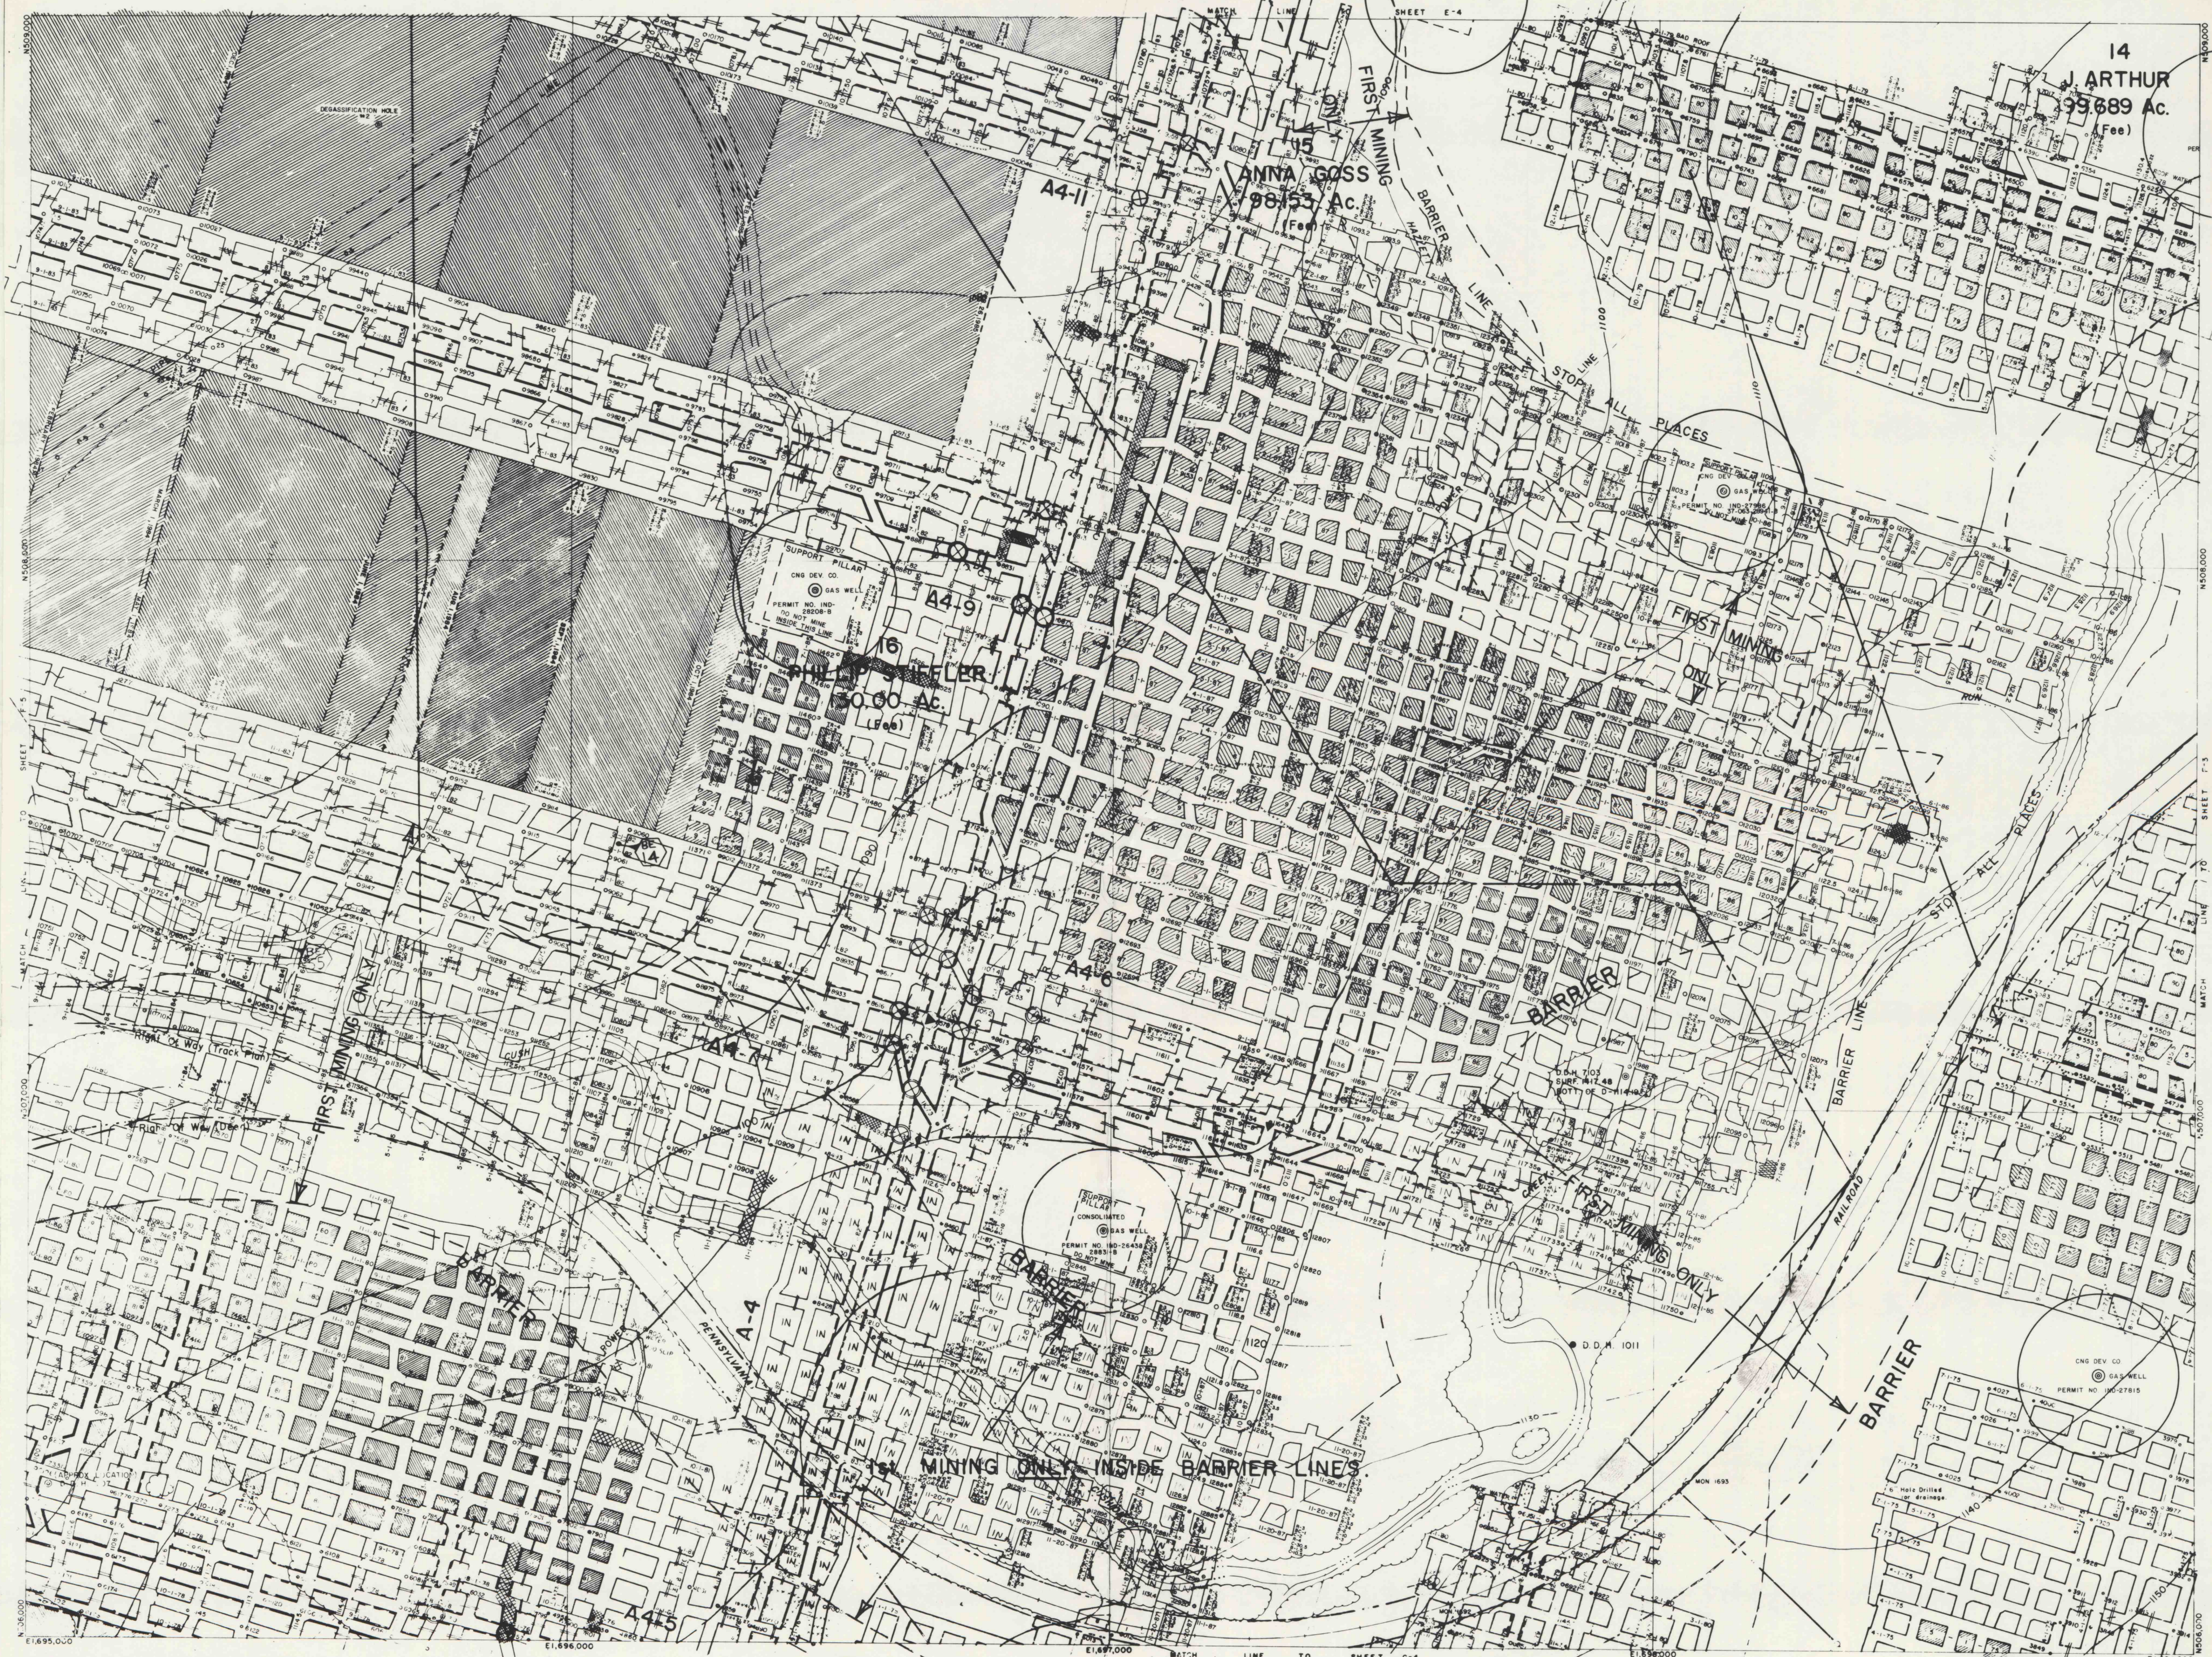

Topography compiled from aerial photography taken April, 1967
Aerial Map Service Co. Pittsburgh, Pennsylvania

Final Map - Mine Workings

#1157
7-26-99

TOPOGRAPHIC MAP
GREENWICH
COAL LANDS
SHEET F-4
INDIANA & AMBRIA COUNTIES