


# HARMAR MINE

1969  
1" = 00'

**LEGEND**

- 1968 WORKINGS
- FAULTY AREAS
- MAIN TRACK
- ABD - ACTIVE WELLS
- MG SETS - RECTIFIERS
- PUMPS TO OUTSIDE
- RESERVES
- SURFACE OWNED
- BORE HOLES
- 1969
- JANUARY
- FEBRUARY
- MARCH
- APRIL
- MAY
- JUNE
- DECEMBER

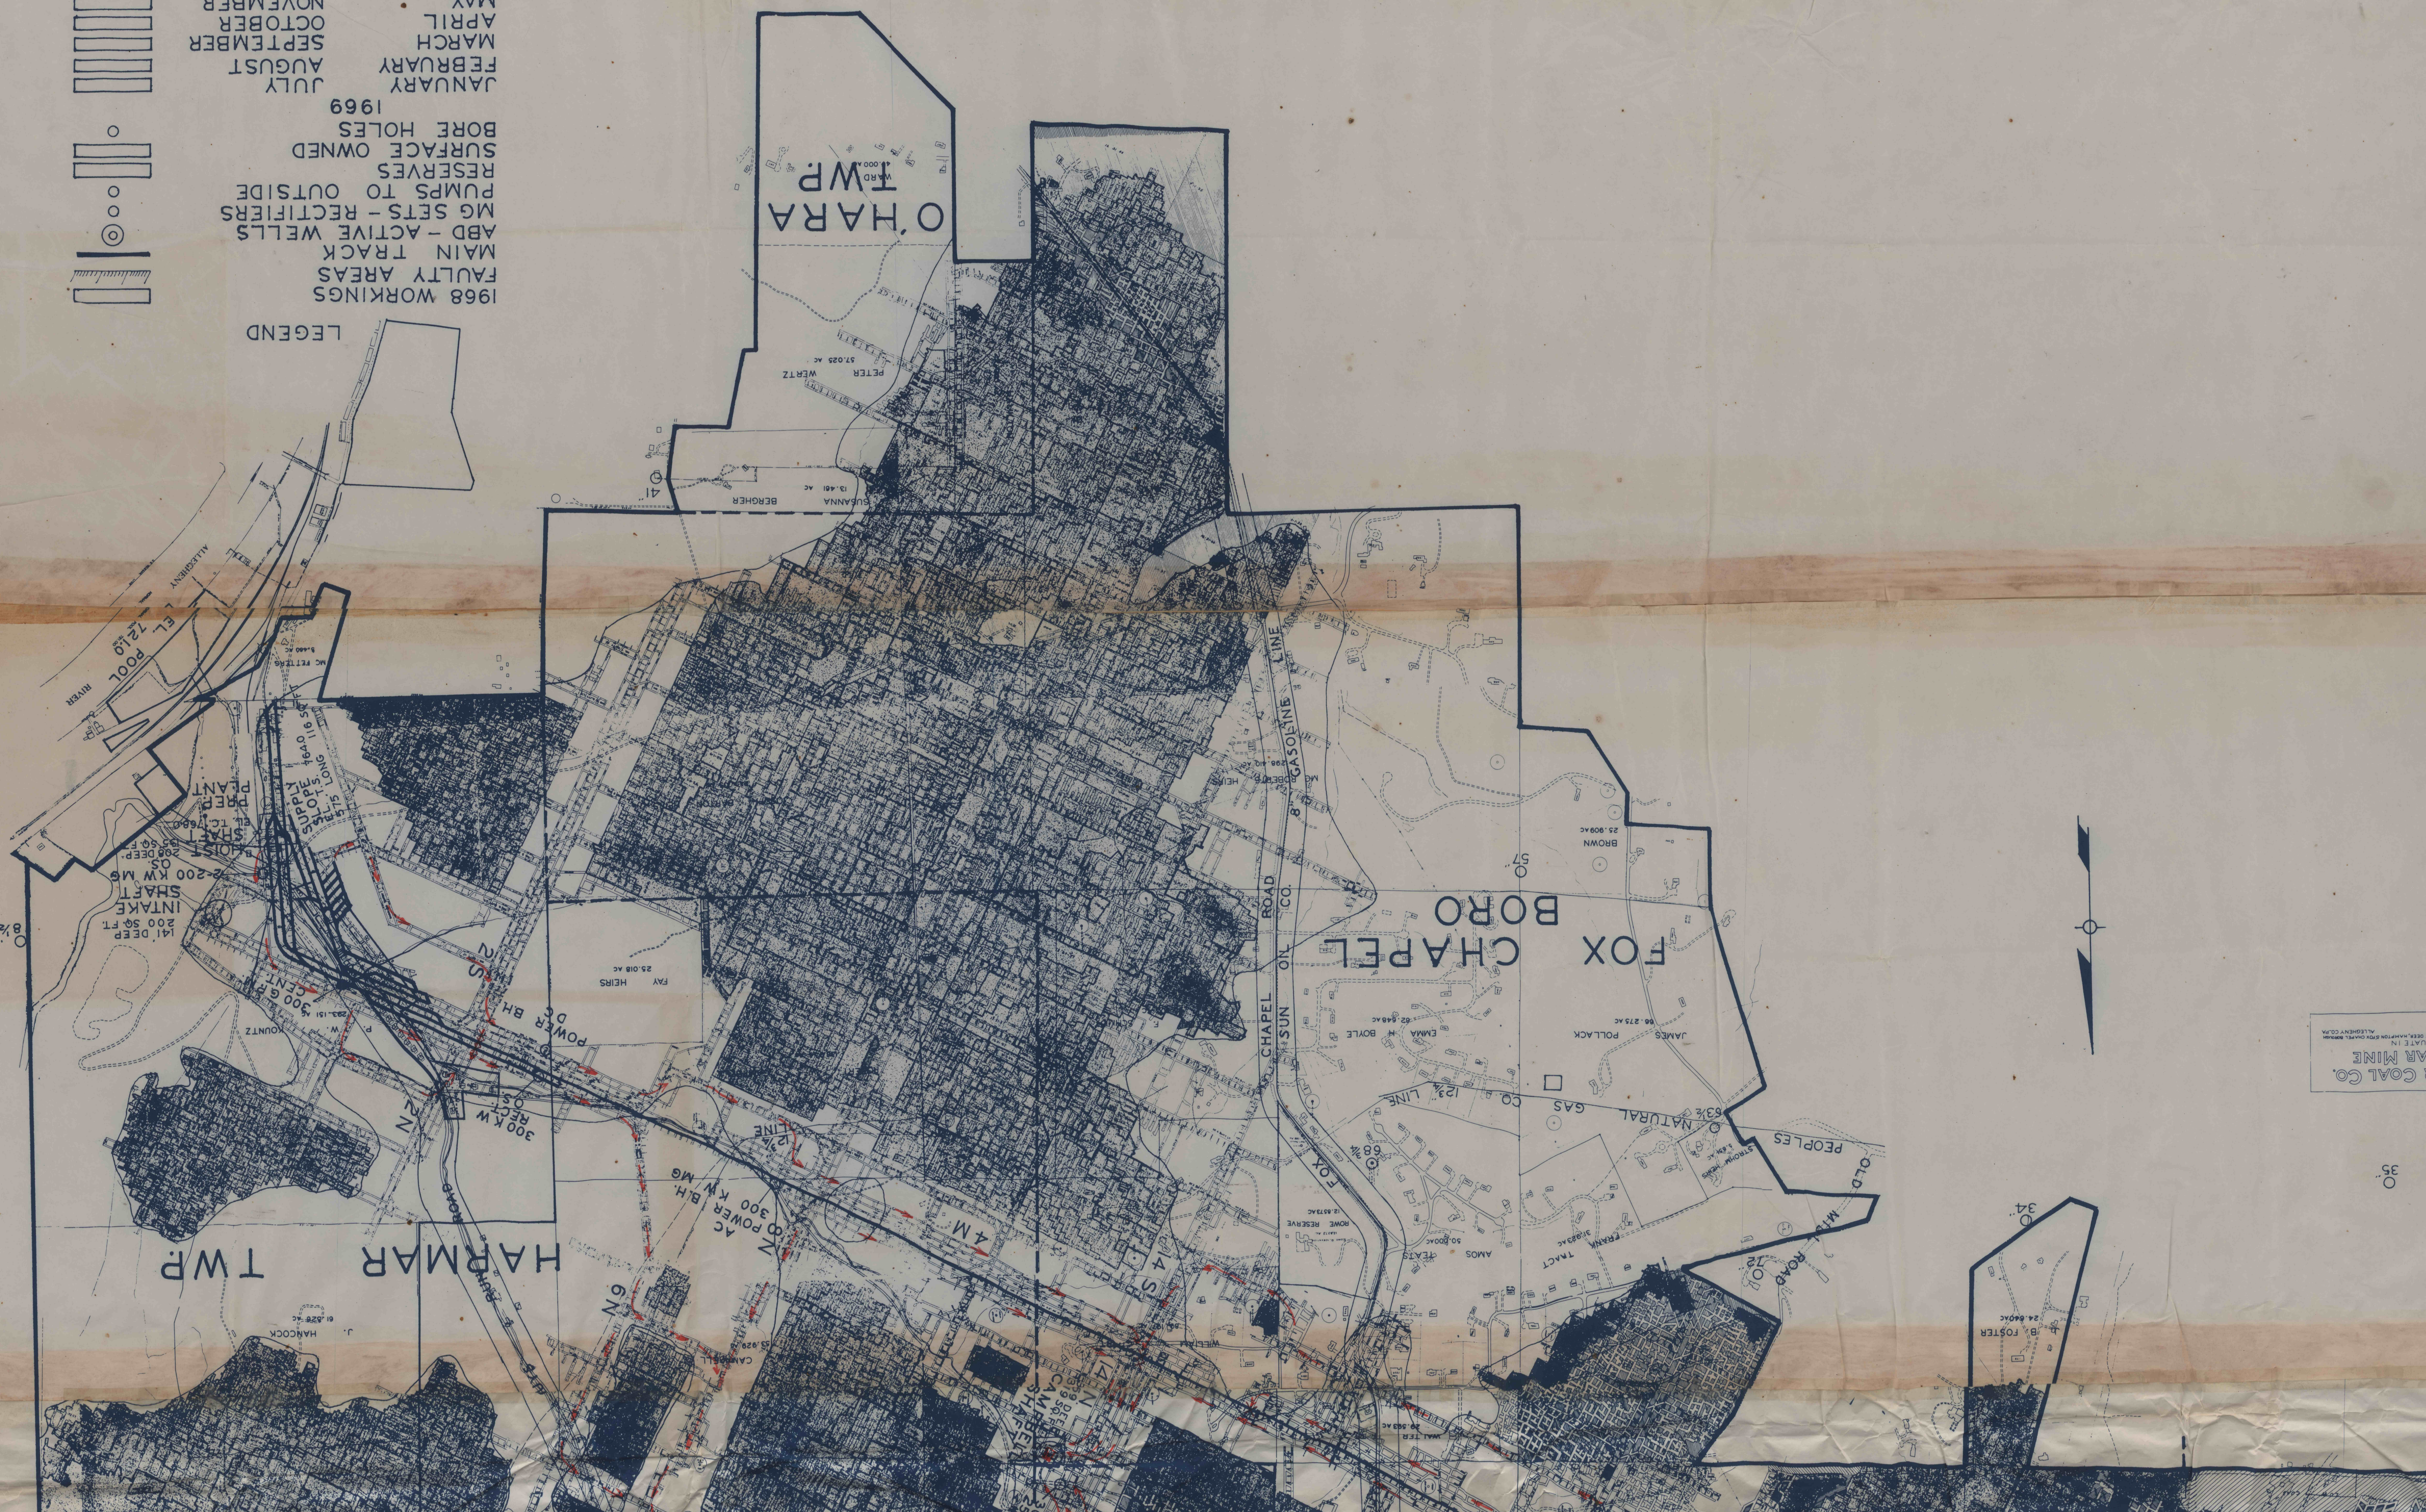

HARMAR COAL CO.  
HARMAR MINE  
STATE IN  
ALLEGANY CO. PA.