


- LEGEND**
- 1 PERMITTED PROPERTY AREA
 - 2 PERMITTED MINING AREA
 - 3 SURFACE AFFECTED AREA
 - 4 MINE ROAD
 - 5 SLUDGE DISPOSAL AREA
 - 6 COAL STOCKPILE AREA
 - 7 TOPSOIL OR SUBSOIL (SPOIL) AREAS
 - 8 M.K. - MIDDLE KITTANNING-C-HIGHWALL
 - 10 M.K. - MIDDLE KITTANNING-C-OUTCROP
 - 11 PROPOSED SEAL
 - 12 ELEV. 10 FEET M.K.-C - COAL CONTOUR
 - 13 PROPERTY LINE
 - 14 SUBDIVISION
 - 15 NEXT 6 - MONTH PROJECTION
 - 16 (5) YEARS PROJECTION
 - 17 AREA WITH OVERBURDEN 100' OR LESS
 - 18 EXISTING STRUCTURES:
 - 1 MINE OFFICE & SHOWER-TRAILER
 - 2 SHOP
 - 3 LAMP HOUSE & PARTS-TRAILER
 - 4 ROCK-DUST STORAGE CAR
 - 5 ELECTRIC-GENERATOR & CONTROLS
 - 6 COAL STOCKER - BELT (FIXED)
 - 19 NUMBERED - PROTECTED STRUCTURE
(HOUSE) UN-NUMBERED - UNPROTECTED STRUCTURE
 - TR TRAILER
 - GR GARAGE
 - SH SHOP
 - BR BARN
 - 20 W.W. WATER WELL
 - 21 S.E. SPRING
 - 22 W.S. NO. WATER SAMPLE
 - 23 MONITORING POINT
 - 24 D.P. NO. DISCHARGE POINT
 - 25 T.H. TEST HOLE
 - 26 FAULT LINE
 - 27 POWER LINE
 - 28 AREAS NOT PROP. TO BE MINED
 - 29 OLD STRIP - SPOIL AREAS
 - 30 D.D. - DIVERSION DITCH

1" = 200' - SCALE SERIES

4	2
3	1

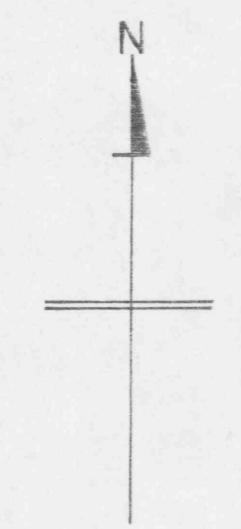

 CONTEMPLATED MINING 6-20-92 TO 12-20-92
 SIX MONTH EXTRACTION 12-20-91 TO 6-20-92
 (5) YEAR PROJECTION

RECEIVED

JUL 15 1992
 Dept. of Environmental Resources
 McMurray District Office

HILLSDALE MINING COMPANY, INC.
 HILLSDALE NO. 1 MINE
 SUSQUEHANNA TWP, CAMBRIA COUNTY, PA
 MIDDLE KITTANNING-C-SEAM OF COAL
 SCALE - 1" = 200'

PREPARED BY: *Andy Link*
 DATE: 6-20-92
 SIGNED: *Robert W. Hoffer*

