


HILLSDALE MINING COMPANY, INC.
 HILLSDALE NO. 1 MINE
 SUSQUEHANNA TWP., CAMBRIA COUNTY, PA
 MIDDLE KITTANNING-C-SEAM OF COAL
 SCALE - 1" = 200'

PREPARED BY: *Andy Lica*
 DATE: *5-7-1992*
 SIGNED: *Robert W. Helfer* SEAL

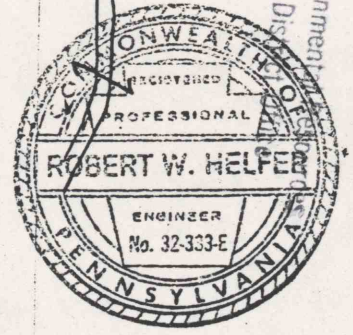

RECEIVED
 MAY 28 1992
 Dept. of Environmental Protection
 McMurray District

