


ROBERT CALHOUN SUR.
MINNS COAL Co. MIN.

- AREA MINED TO DATE
- EXTENT OF AREA TO BE MINED
- AREA TO BE MINED NEXT 6-MONTHS PERIOD
- OLD STRIPPING

YOST ASSOCIATES INC.
ENGINEERS
DUBOIS, PA.

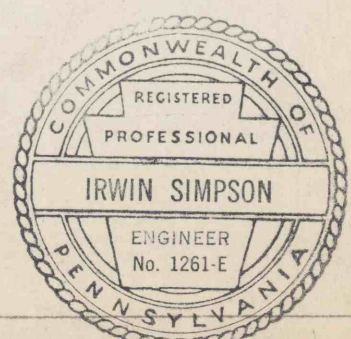

FIELD COPY
HOLT MINE
ON THE
ROBERT CALHOUN PROPERTY
IN
WASHINGTON TWP. JEFF. CO., PA.
SCALE 1"=200' SEPT. 13, 66

#1299
8-4-99
C.C.

13 401 P.1
FILE 802A