


562°50'E

2701.20

018800'

58

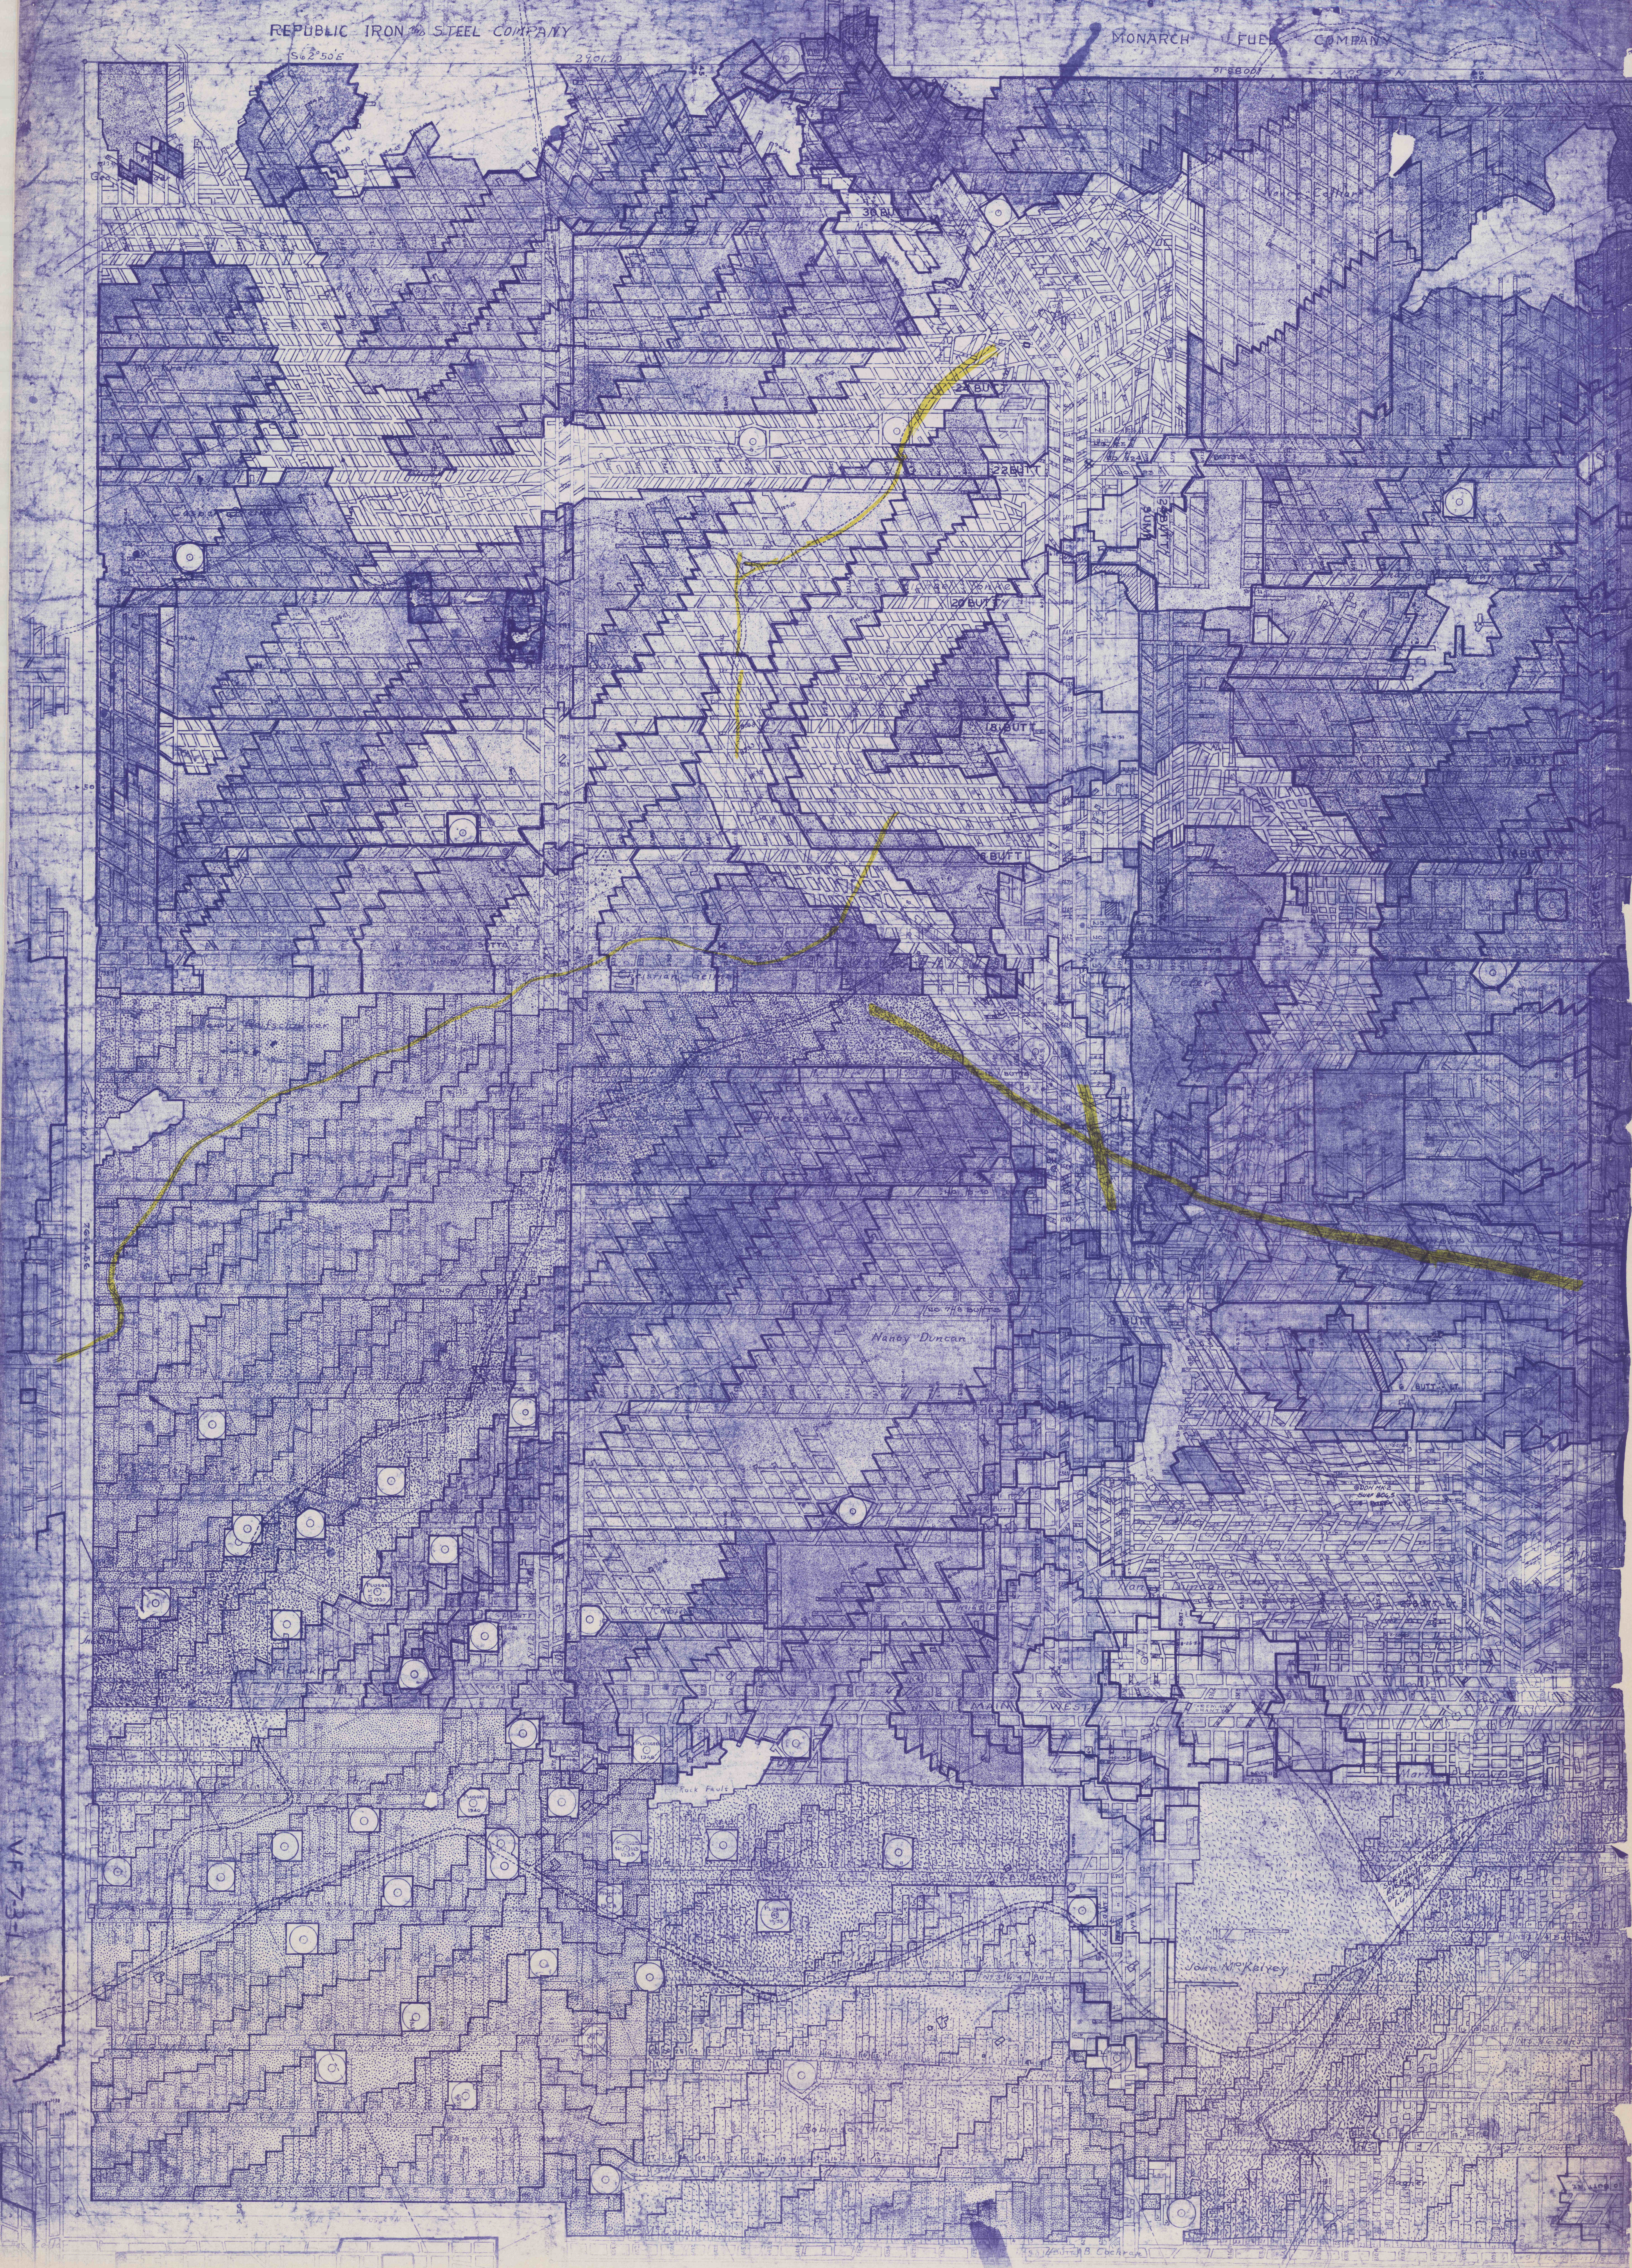

Navy Duncan

Rock Faults

John McKittrick

VF 7-3-1