


CONSUMERS MINING Co.

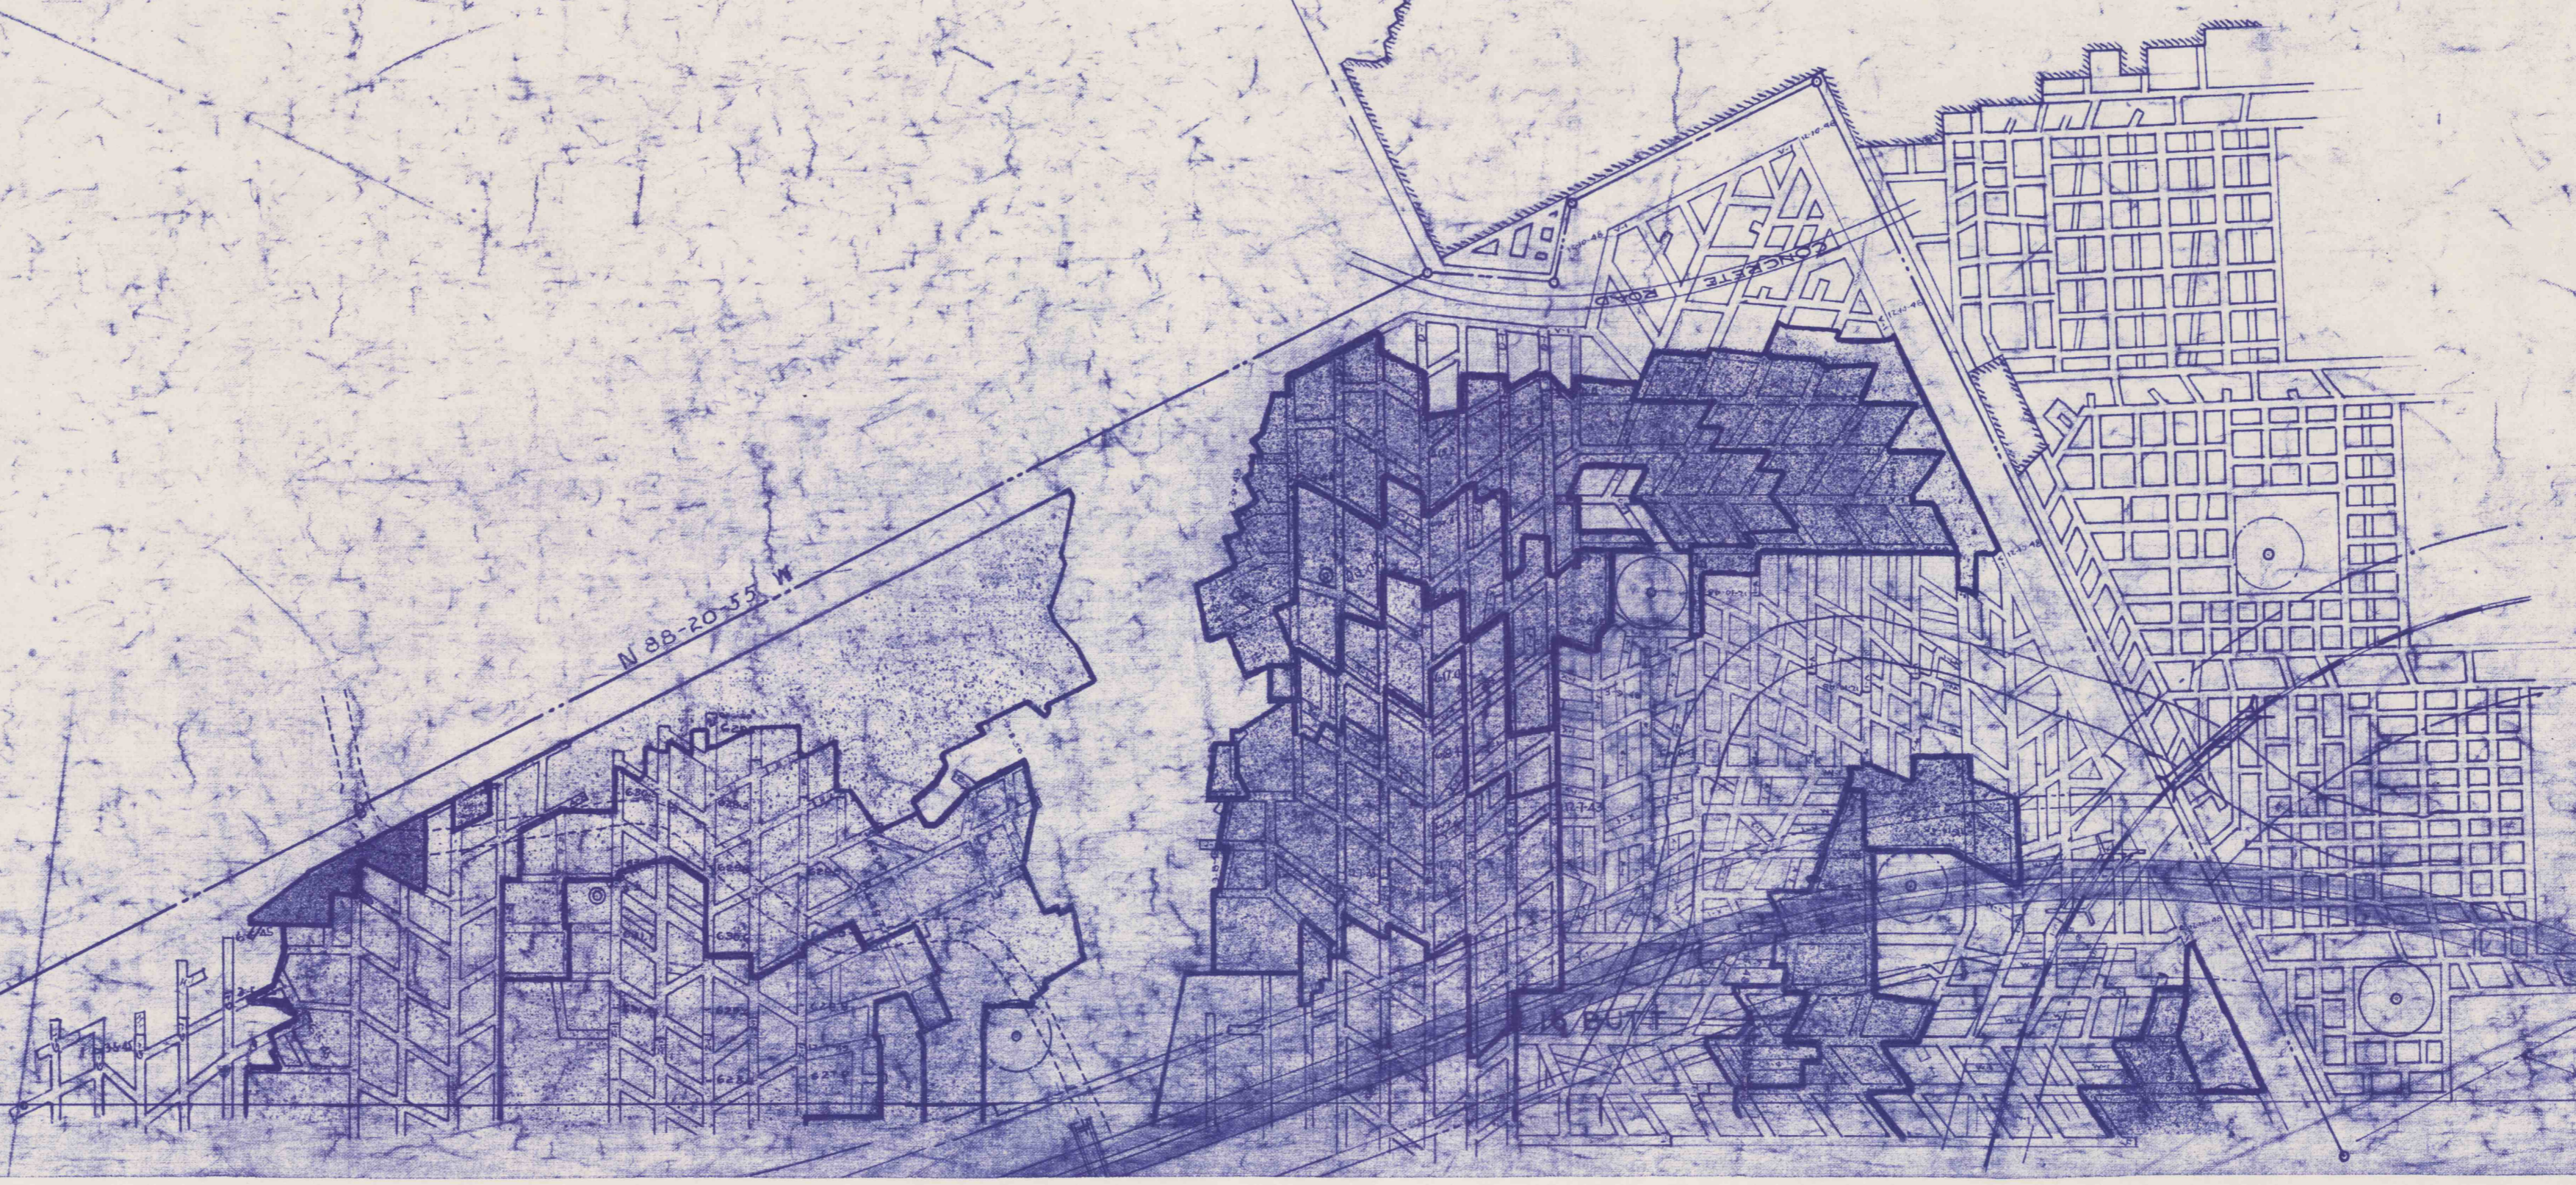

VF-7-3-4