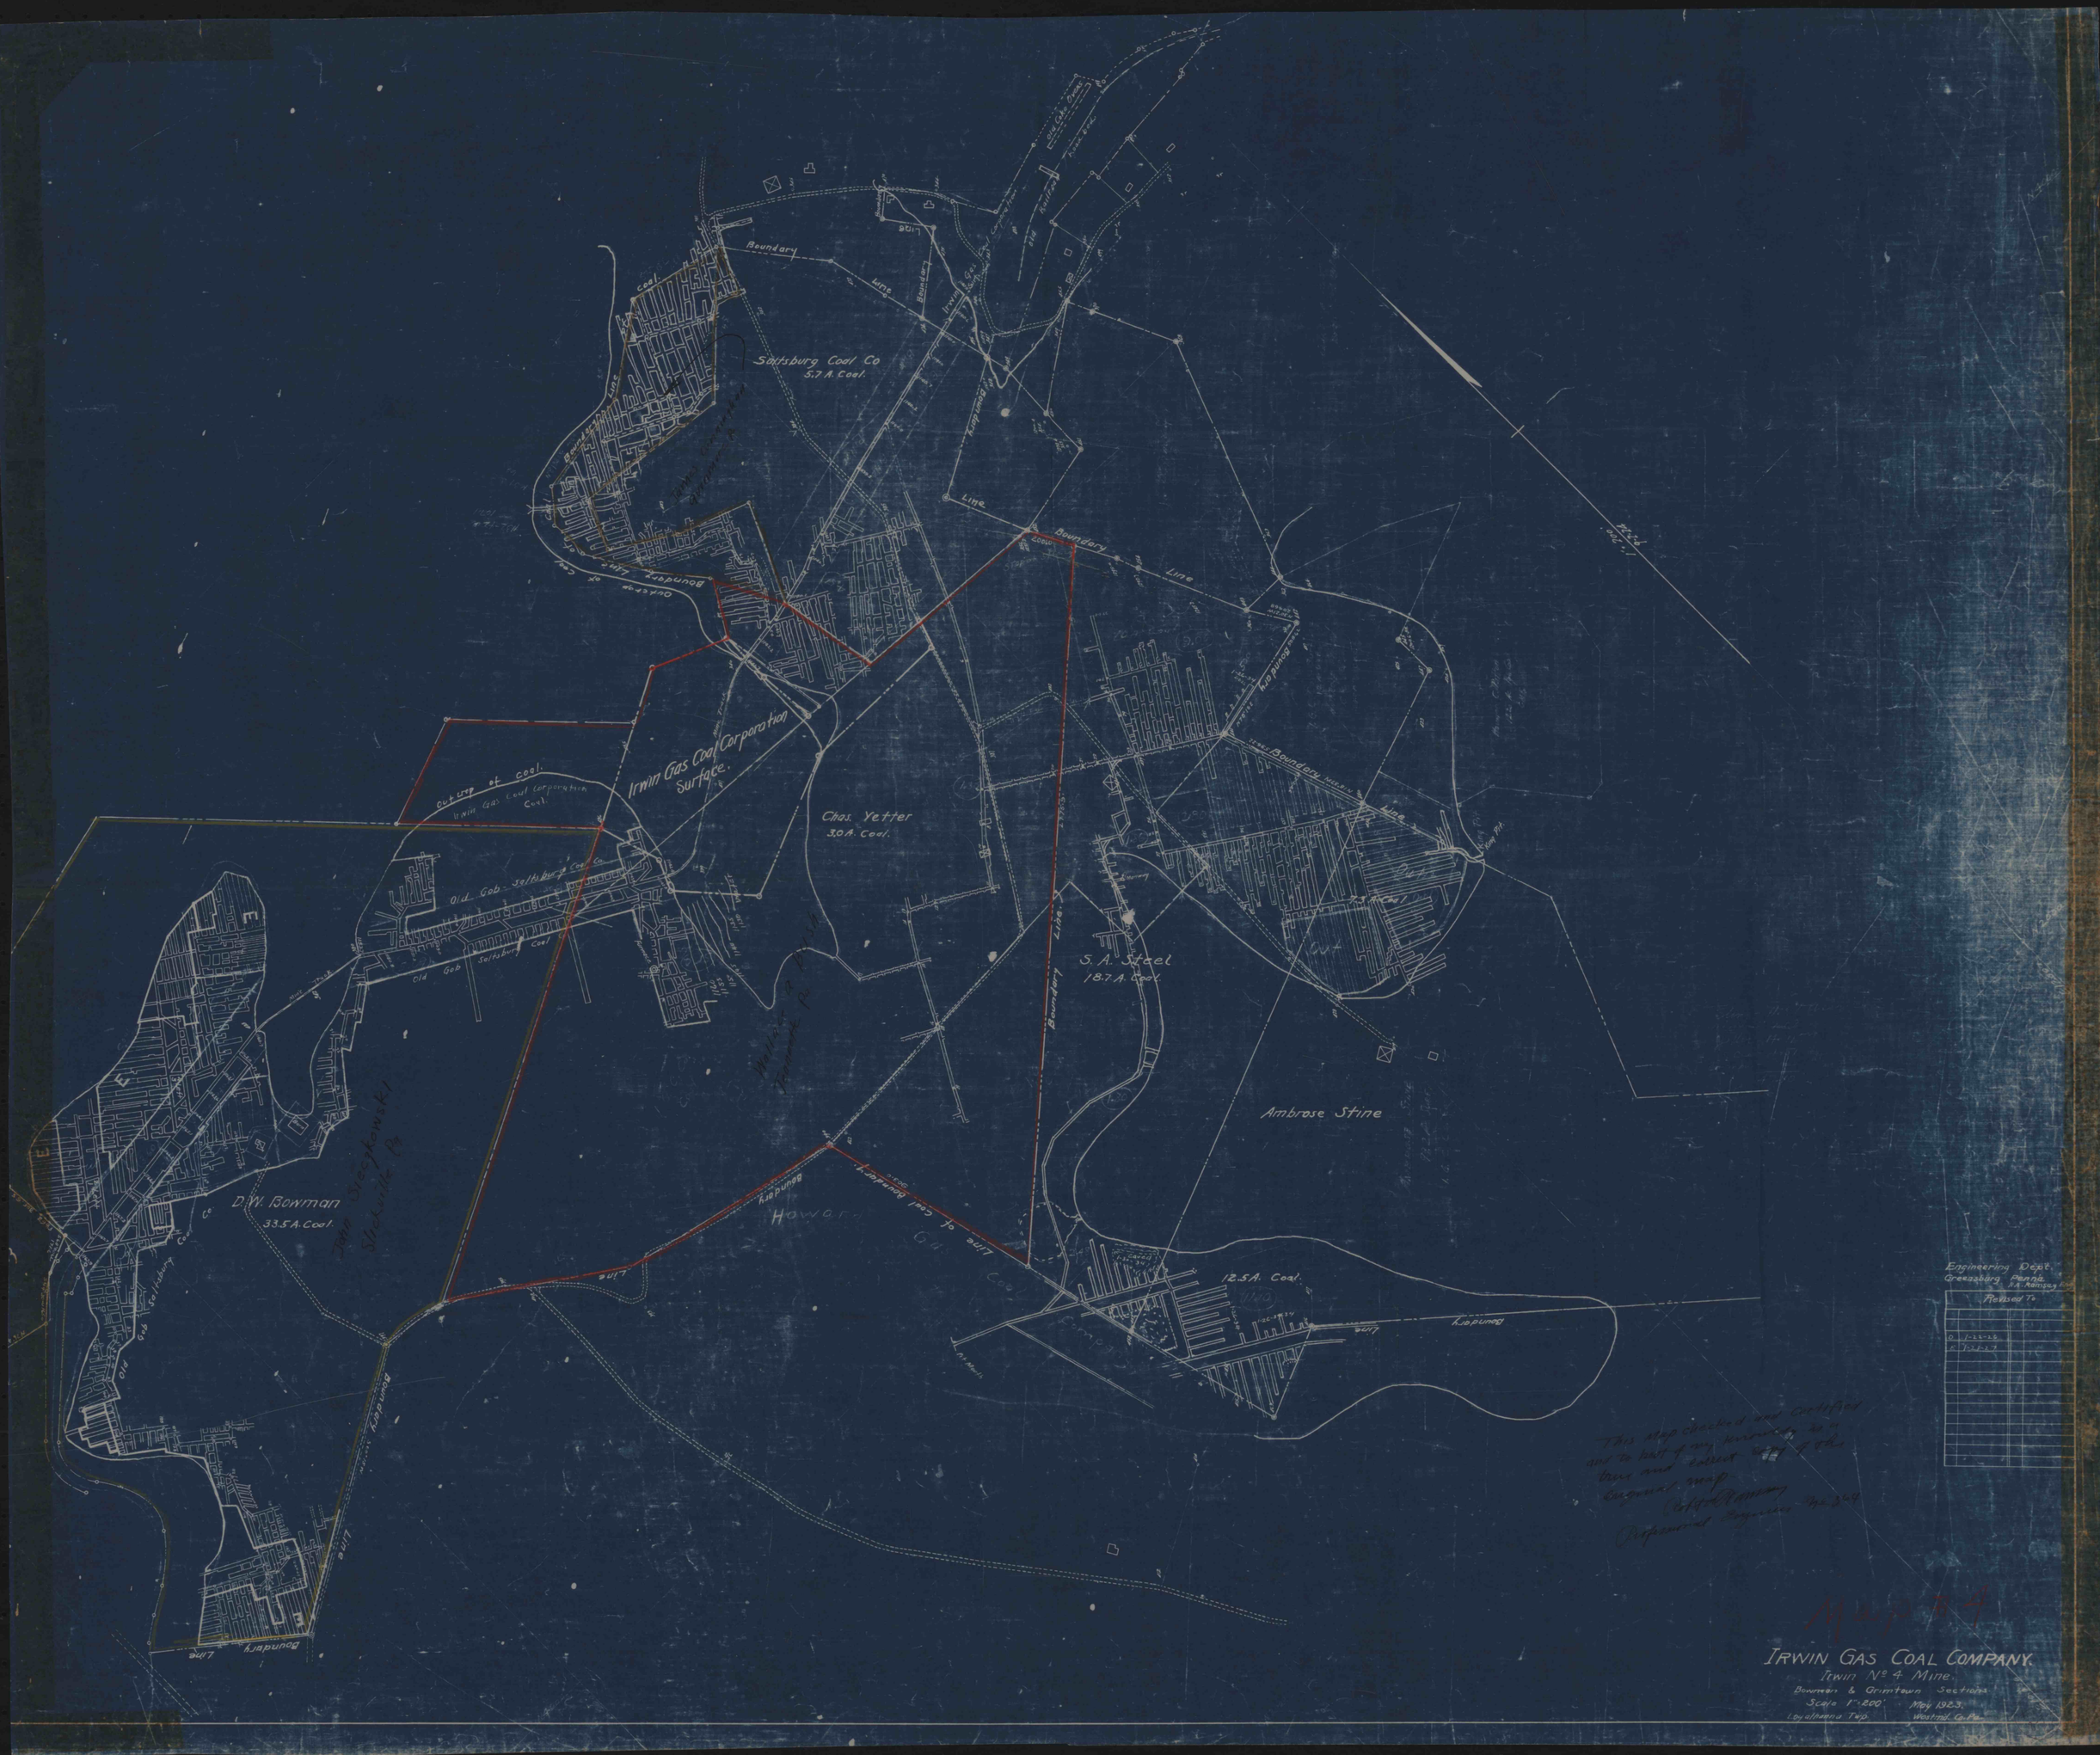
Saltsburg Coal Co
5.7 A. Coal.
Irwin Gas Coal Corporation
Surface.
Chas. Yetter
3.0 A. Coal.
S. A. Steel
18.7 A. Coal.
Ambrose Stine
D.W. Bowman
33.5 A. Coal.
12.5 A. Coal.
Boundary Line
Outcrop of Coal.
Irwin Gas Coal Corporation
Coal.
Old Gob Saltsburg Coal Co.
Engineering Dept.
Greensburg Penna.
Revised To
This Map checked and Certified
and to best of my knowledge is a
true and correct copy of the
original map.
Professional Engineer
Map No. 4
IRWIN GAS COAL COMPANY.
Irwin No 4 Mine.
Bowman & Grimtown Sections
Scale 1" = 200'
May 1923.
Loyalhanna Twp.
Westmd. Co. Pa.