



MATCH TO RIGHT SIDE SHEET NO. 1

COPY

MARGANO

E 40,000

E 42,000

E 44,000

E 46,000

N 00,000


N 02,000

N 04,000

N 06,000

ASSOCIATED DRILLING, INC.
 REPHERT MINE
 C COAL SEAM
 DECATUR AND CLEARFIELD CO. PA.
 SCALE 1"=200' GEF13-5 111

LEGEND
 [Stippled Box] UNMINED MINING AREA
 [Solid Line Box] NO MINING AREA
 [Dashed Line Box] 50% MINING AREA
 [Solid Line Box] COMPLETED MINING AREA
 [Dotted Line Box] PERMIT EXTENT

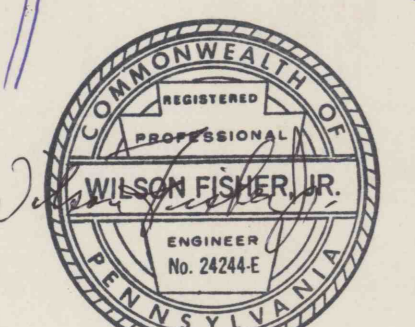

THIS PRINT IS A TRUE AND CORRECT COPY OF THE ORIGINAL MAP OF ASSOCIATED DRILLING, INC., REPHERT MINE. THE ORIGINAL MAP OF ASSOCIATED DRILLING, INC., REPHERT MINE IS A TRUE, COMPLETE, AND CORRECT MAP AND SURVEY OF ALL EXCAVATIONS MADE IN THE NOW ABANDONED ASSOCIATED DRILLING, INC., REPHERT MINE.
 DATE OF FINAL SURVEY SEPTEMBER 15, 1984.

MINE WORKS TO DATE: 9-15-84: K.W.B.
 MINE WORKS TO DATE: 7-24-84: K.W.B.
 MINE WORKS TO DATE: 7-24-84: K.W.B.
 MINE WORKS TO DATE: 7-22-85: K.W.B.

BOTTOM SHEET NO. 2

COPY