

NODESKI

STRIPPING

HAUL RD.

L.V.C. Co.

WORKED OUT AND CAVED BY L.V.C. CO.

CUTTED BY KOSHKO EL. 1540

"B" SEAM 25' HIGH WALL OF STRIPPING BY OTHERS

SND CENTER TWP. LEHIGH COUNTY

SURFACE - RUSNOK COAL - LEHIGH VALLEY COAL CO.

GEORGE WHITTAKER WARR.

WORKED OUT AND CAVED AS ABOVE EL. 1540

LOW WALL


PROPERTY LINE

RUSNOK

LEHIGH VALLEY COAL CO.

VARIOUS PROPERTIES KNOWN AS BEMAUSIDE

TWP RD# 416

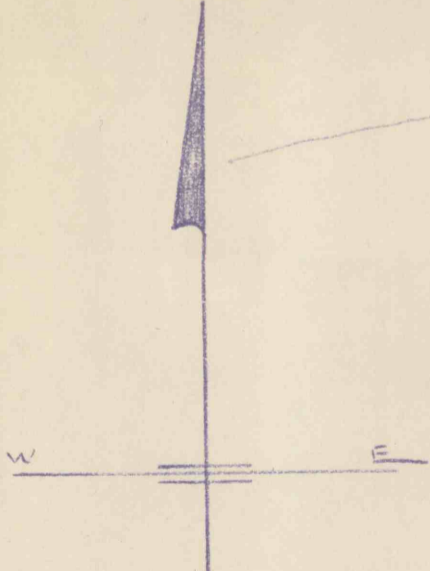

HOWARD KOSHKO  
MAP OF ABANDONNED DEEP MINES  
SECONDARY REMOVAL OF COAL  
BITUMINOUS COAL - "B" SEAM

SCALE - 1" = 200 FT.

MAP BY FRANCIS A.E. KOSKI, R.SURV. # 7619-E  
DECEMBER 28, 1962

TO CLARENCE 2 MI.

TO PANCAKE 1 MI.