


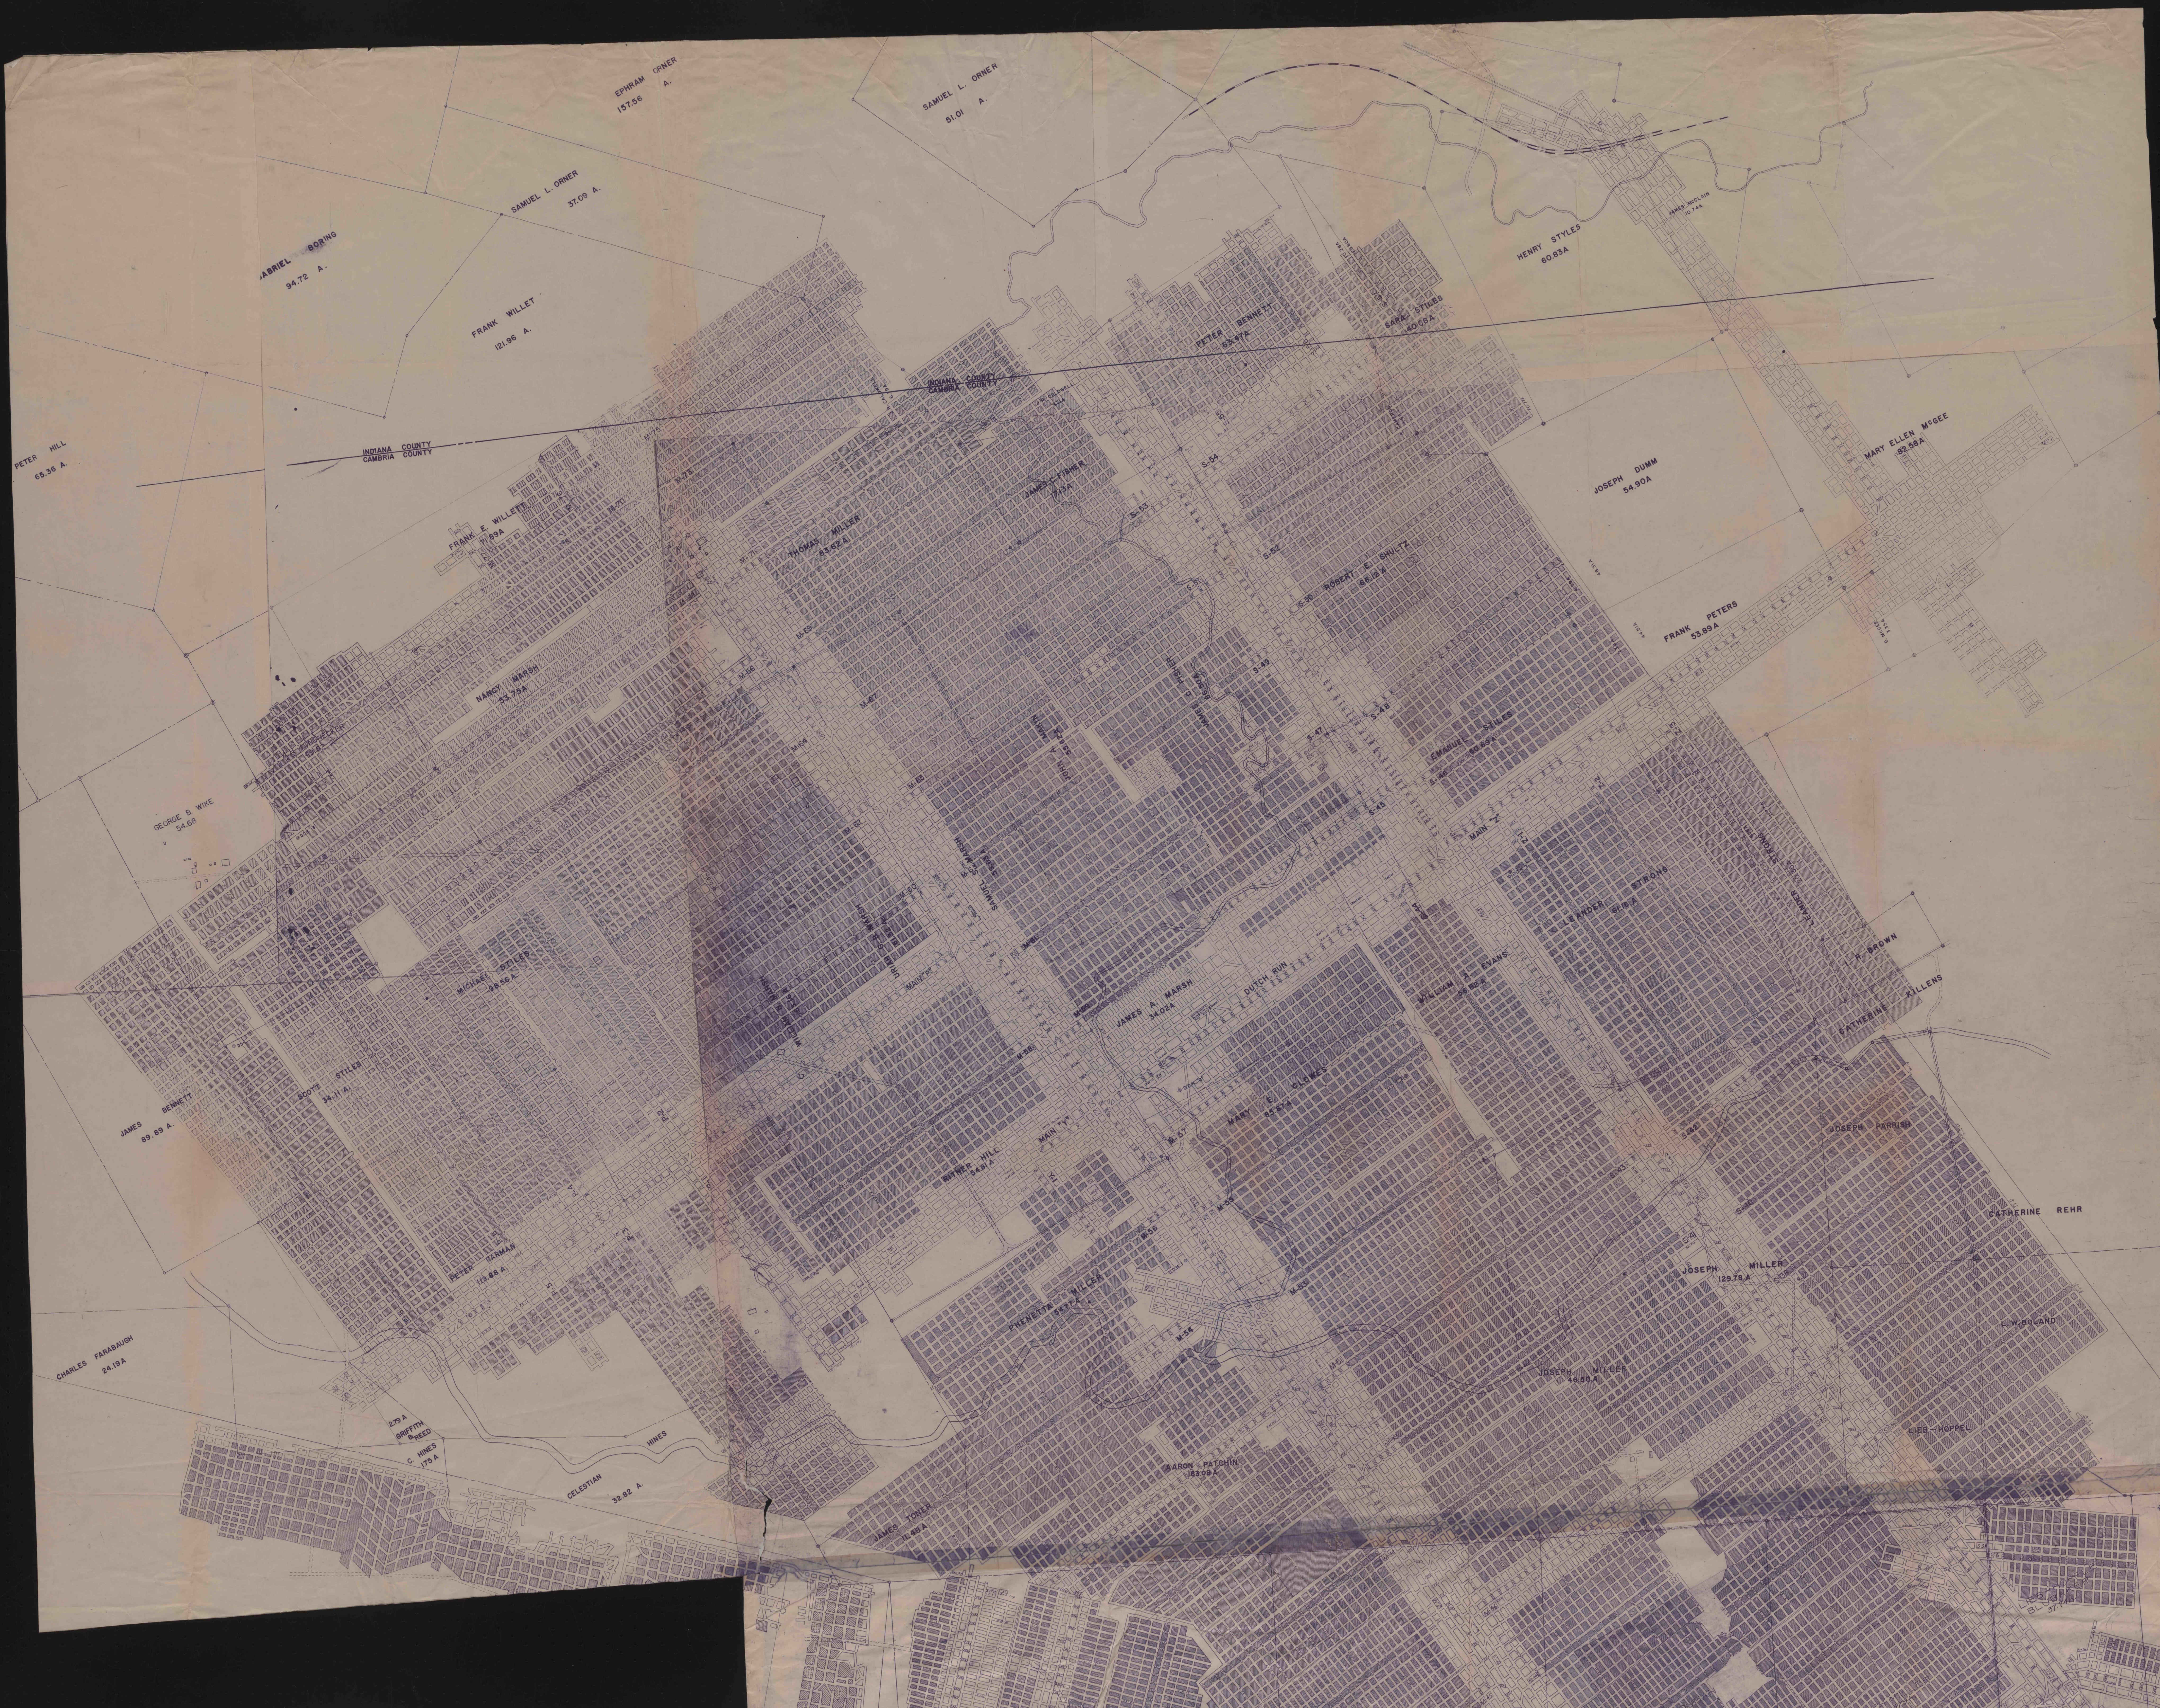

EPHRAIM ORNER
157.56 A.
SAMUEL L. ORNER
51.01 A.

ABRIEL BORING
94.72 A.

SAMUEL L. ORNER
37.09 A.
FRANK WILLET
121.96 A.

PETER HILL
65.36 A.

INDIANA COUNTY
CAMBRIA COUNTY

HENRY STYLES
60.83A

PETER BENNETT
62.37A
BAPT STILES
60.69A

JOSEPH DUMM
54.90A

MARY ELLER MCGEE
82.58A

FRANK PETERS
53.89 A

GEORGE B. WILK
54.68

63.75A

THOMAS MILLER
61.92 A


ROBERT E. SHULTZ
86.84 A

EMANUEL STILES
88.80A

ANDER STRONG
81.10 A

CATHERINE KILLENS

JOSEPH PARRISH

CATHERINE REHR

JOSEPH MILLER
129.78A

W. BOUND

LIEB-HOPPEL

JOSEPH MILLER
48.99 A

BARON PATCHIN
162.99 A

JAMES TOWNE
11.40 A

CELESTIAN
32.82 A

C. HINES
175 A

CHARLES FARABAUGH
24.19A

JAMES BENNETT
89.89 A.

SCOTT STILES
36.11 A.

MICHAEL STILES
98.56 A.

PETER HARMAN
14.88 A.

RUTH HILL
14.81A

MARY T.

JAMES A. MARSH
34.02A

MARY E. CLAWES
82.57A

WILLIAM EVANS
56.82A