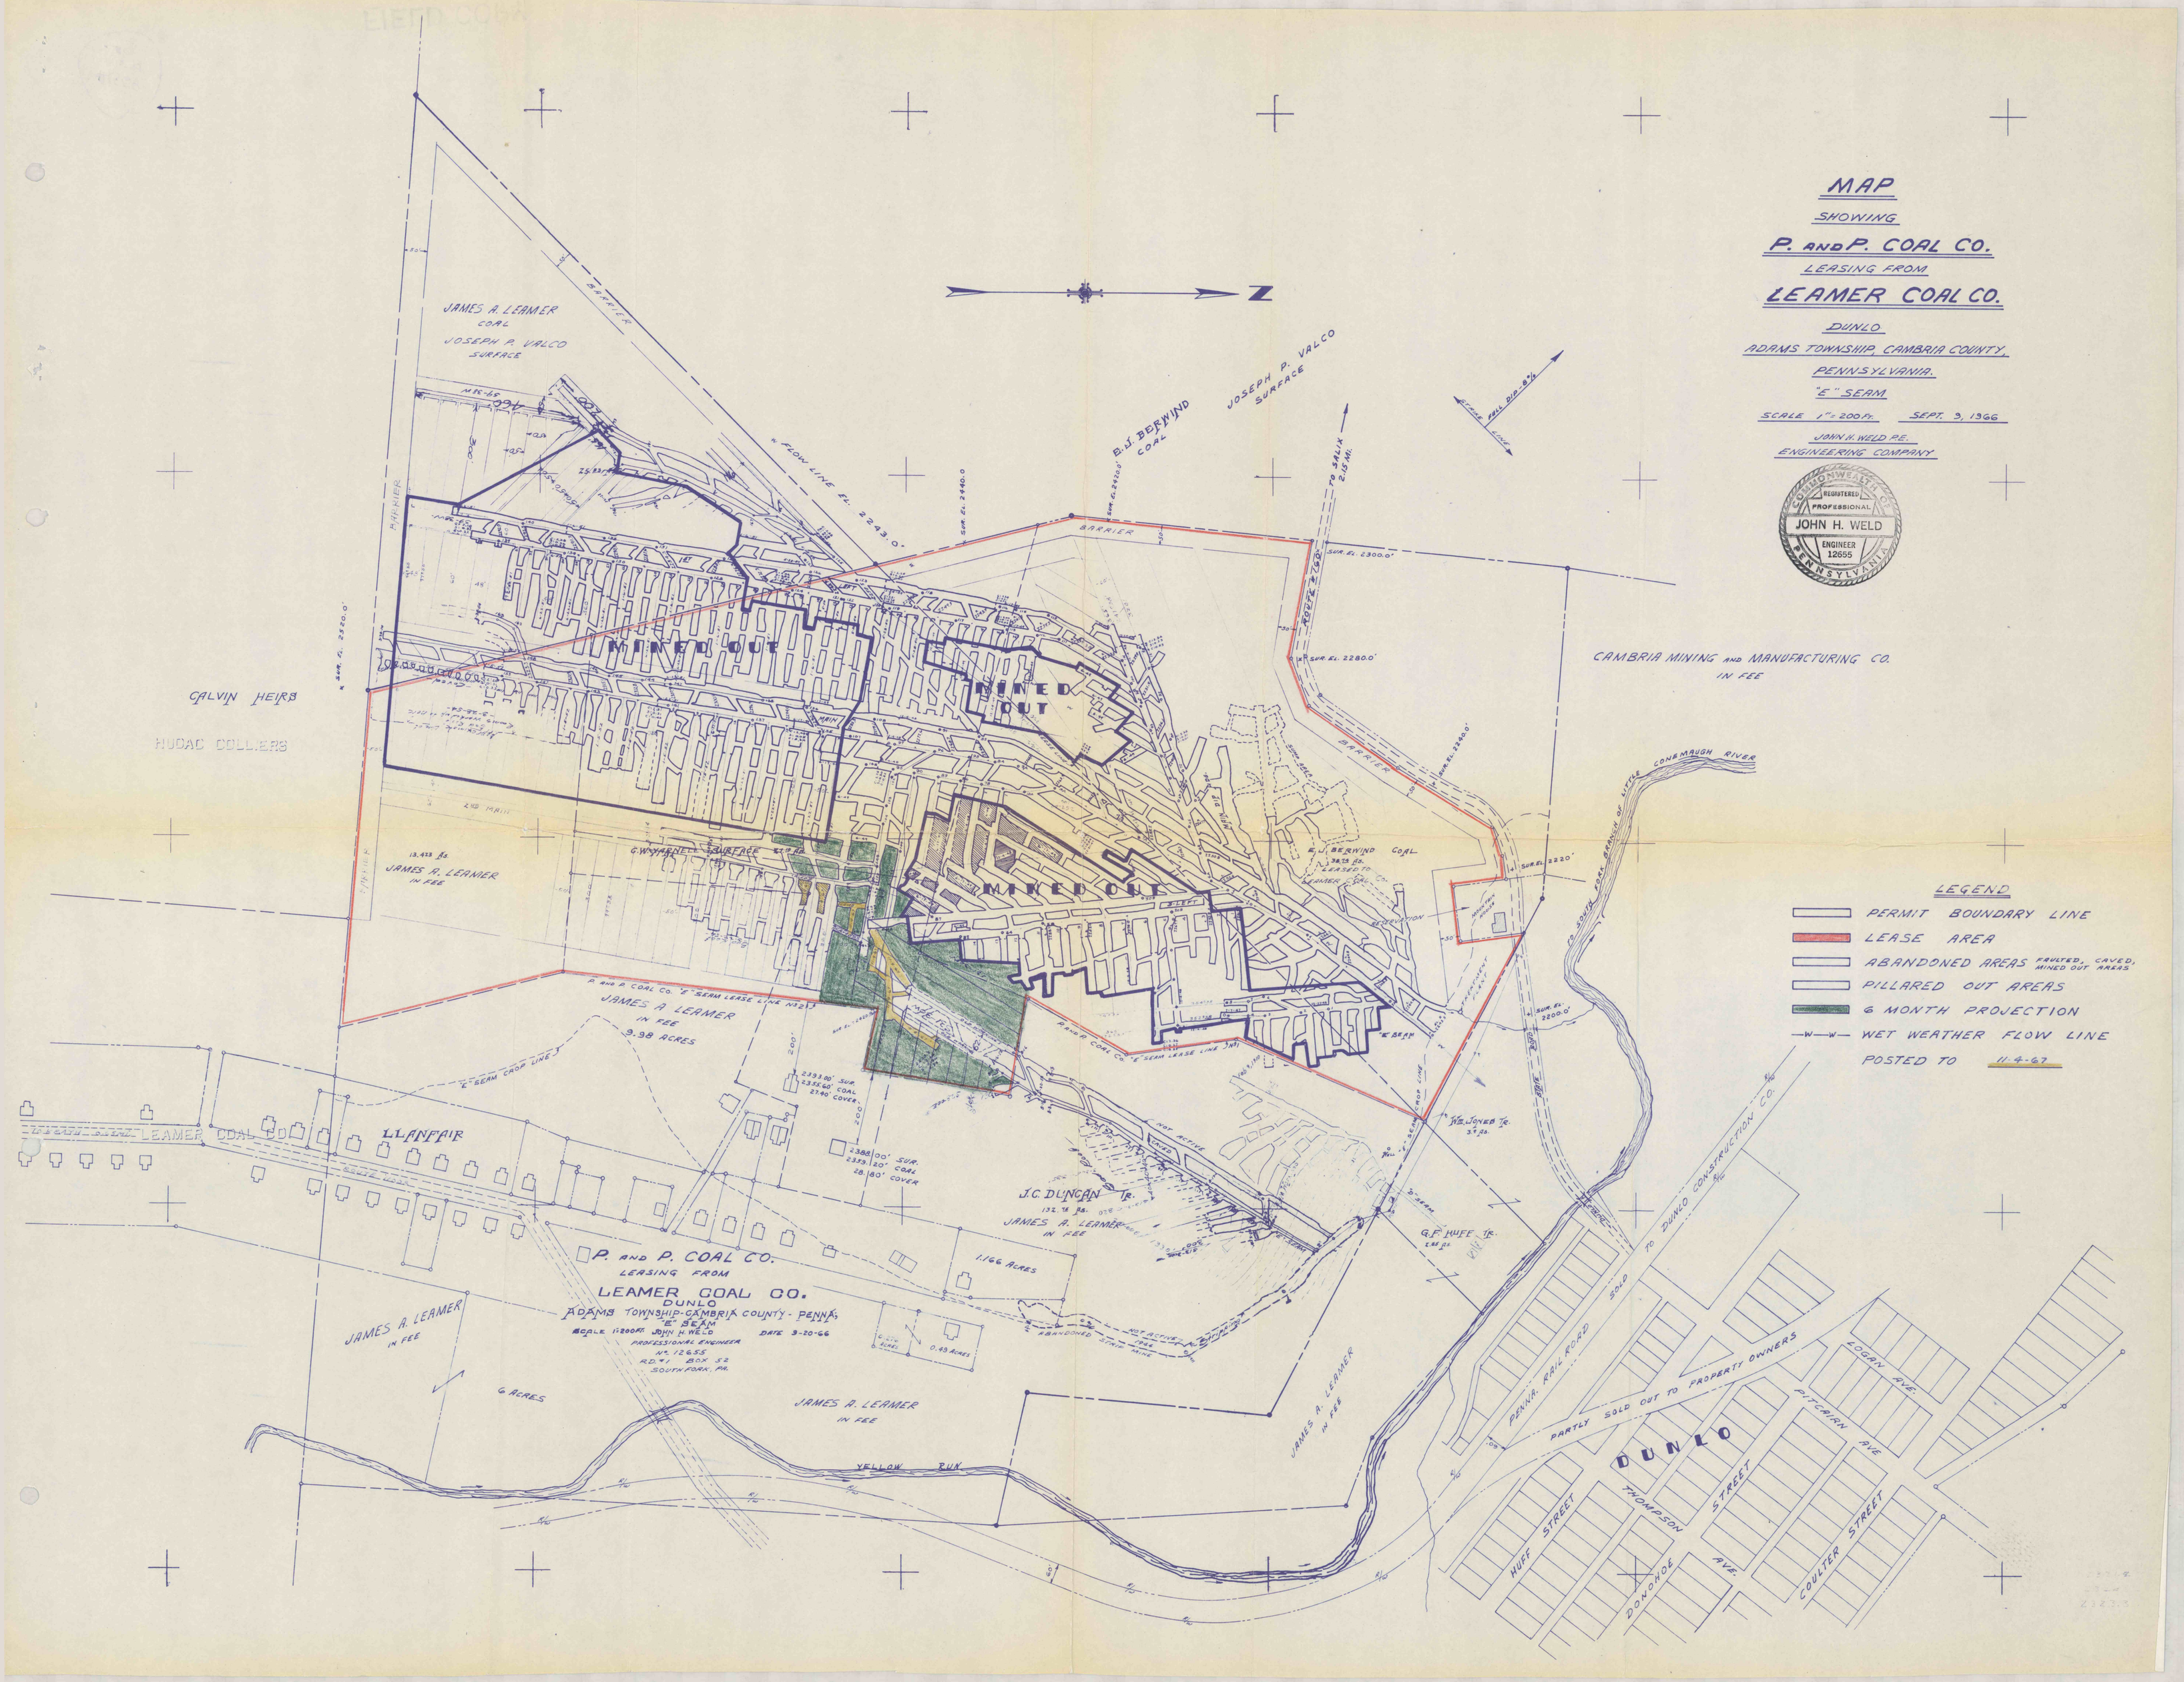
MAP
SHOWING
P. AND P. COAL CO.
LEASING FROM
LEAMER COAL CO.
DUNLO
ADAMS TOWNSHIP, CAMBRIA COUNTY,
PENNSYLVANIA.
"E" SEAM
SCALE 1" = 200 Ft.
SEPT. 9, 1966
JOHN H. WELD P.E.
ENGINEERING COMPANY
COMMONWEALTH OF PENNSYLVANIA
REGISTERED PROFESSIONAL
JOHN H. WELD
ENGINEER 12655
LEGEND
PERMIT BOUNDARY LINE
LEASE AREA
ABANDONED AREAS FAULTED, CAVED, MINED OUT AREAS
PILLARED OUT AREAS
6 MONTH PROJECTION
WET WEATHER FLOW LINE
POSTED TO 11-4-67
JAMES A. LEAMER COAL
JOSEPH P. VALCO SURFACE
E.J. BERWIND COAL
JOSEPH P. VALCO SURFACE
TO SALIX 2.15 MI.
FLOW LINE EL. 2243.0'
BARRIER
MINED OUT
MINED OUT
MINED OUT
CAMBRIA MINING AND MANUFACTURING CO. IN FEE
CALVIN HEIRS
HUDAC COLLIERS
JAMES A. LEAMER IN FEE
G.W. YARNELL SURFACE
E.J. BERWIND COAL
CONEMAUGH RIVER
JAMES A. LEAMER IN FEE
9.98 ACRES
LLANFAIR
LEAMER COAL CO.
J.C. DUNCAN Tr.
JAMES A. LEAMER IN FEE
1.166 ACRES
0.49 ACRES
P. AND P. COAL CO.
LEASING FROM
LEAMER COAL CO.
DUNLO
ADAMS TOWNSHIP-CAMBRIA COUNTY - PENNA.
"E" SEAM
SCALE 1:200 Ft. JOHN H. WELD DATE 9-20-66
PROFESSIONAL ENGINEER
No. 12655
R.D. #1 BOX 52
SOUTH FORK, PA.
JAMES A. LEAMER IN FEE
6 ACRES
JAMES A. LEAMER IN FEE
YELLOW RUN
JAMES A. LEAMER IN FEE
G.F. HUFF Tr.
W.E. JONES Tr.
PENNA. RAILROAD
PARTLY SOLD OUT TO PROPERTY OWNERS
SOLD TO DUNLO CONSTRUCTION CO.
DUNLO
HUFF STREET
THOMPSON STREET
DONOHOE AVE.
COULTER STREET
PITCAIRN AVE
LOGAN AVE.