

DAVID

WATSON

WAR.


NO.

LEAHEY

MINED OUT

MINED OUT

C. A. HUGHES & CO.

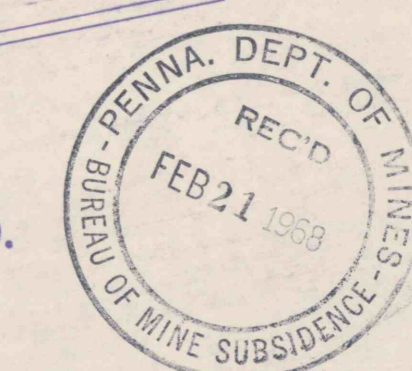

LILLY 3-A "B" SEAM MINE  
 CRESSON TOWNSHIP CAMBRIA COUNTY PA.  
 SCALE 1" = 200'  
 REVISED 6-30-1967

LEGEND  
 BOUNDARIES OF SURFACE ————  
 MINING OPERATIONS COMPLETED ————  
 PROPOSED OPERATIONS UNDER PERMIT ————  
 PROPOSED WORK NEXT SIX MONTHS ———— 6-30-68  
 PERMIT No. 288-1

