

A. H. SLAYMAN TRACT

ROBERT JOHN WARRANT  
LEAHEY HEIRS

WILLIAM JOHN WARRANT  
LEAHEY HEIRS

W.H. PIPER & CO.

PA. GAME COMMISSION - SURFACE  
JONES COAL CO - COAL

DAVID WILSON

WAR. NO.

C. A. HUGHES & CO.


LEGEND

- BOUNDARIES OF SURFACE
- MINING OPERATIONS COMPLETED
- PROPOSED OPERATIONS UNDER PERMIT
- PROPOSED WORK NEXT 6-MONTHS 1-1-67 TO 7-1-67

C.A. HUGHES AND COMPANY  
CRESSON, PA.

STRIP MINE OPERATIONS IN THE LANDS OF THE  
BETHLEHEM LAND CORPORATION

IN  
CRESSON TWP. CAMBRIA CO. AND JUNIATA TWP. BLAIR CO.  
LILLY NO. 3 MERIDIAN B SEAM WORKINGS TO  
SCALE 1"=200 B RIDER TO

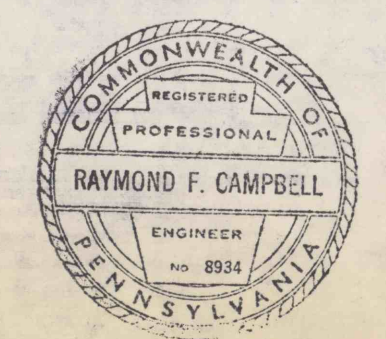

Raymond F. Campbell  
P.E., ENGR.

