

LATROBE CONSTRUCTION CO.


LATROBE CONSTRUCTION CO.

LATROBE CONSTRUCTION CO.

STATION NUMBER	OUTSIDE SURFACE ELEV.	INSIDE FLOOR ELEV.
1	1807.37	1504.92
2	1785.60	1496.67
3	1786.67	1481.94
4	1780.53	1478.80
5	1767.83	1456.59
6	1763.90	1467.64
7	1747.10	1451.78

COORDINATE VALUES

△ 1 +2471.00	△ 4 +1882.57	△ 7 +1313.50
△ 2 +2185.70	△ 5 +1603.08	△ 8 +2733.04
△ 3 +2151.07	△ 6 +1641.61	
△ 9 +2541.23	△ 10 +1967.90	

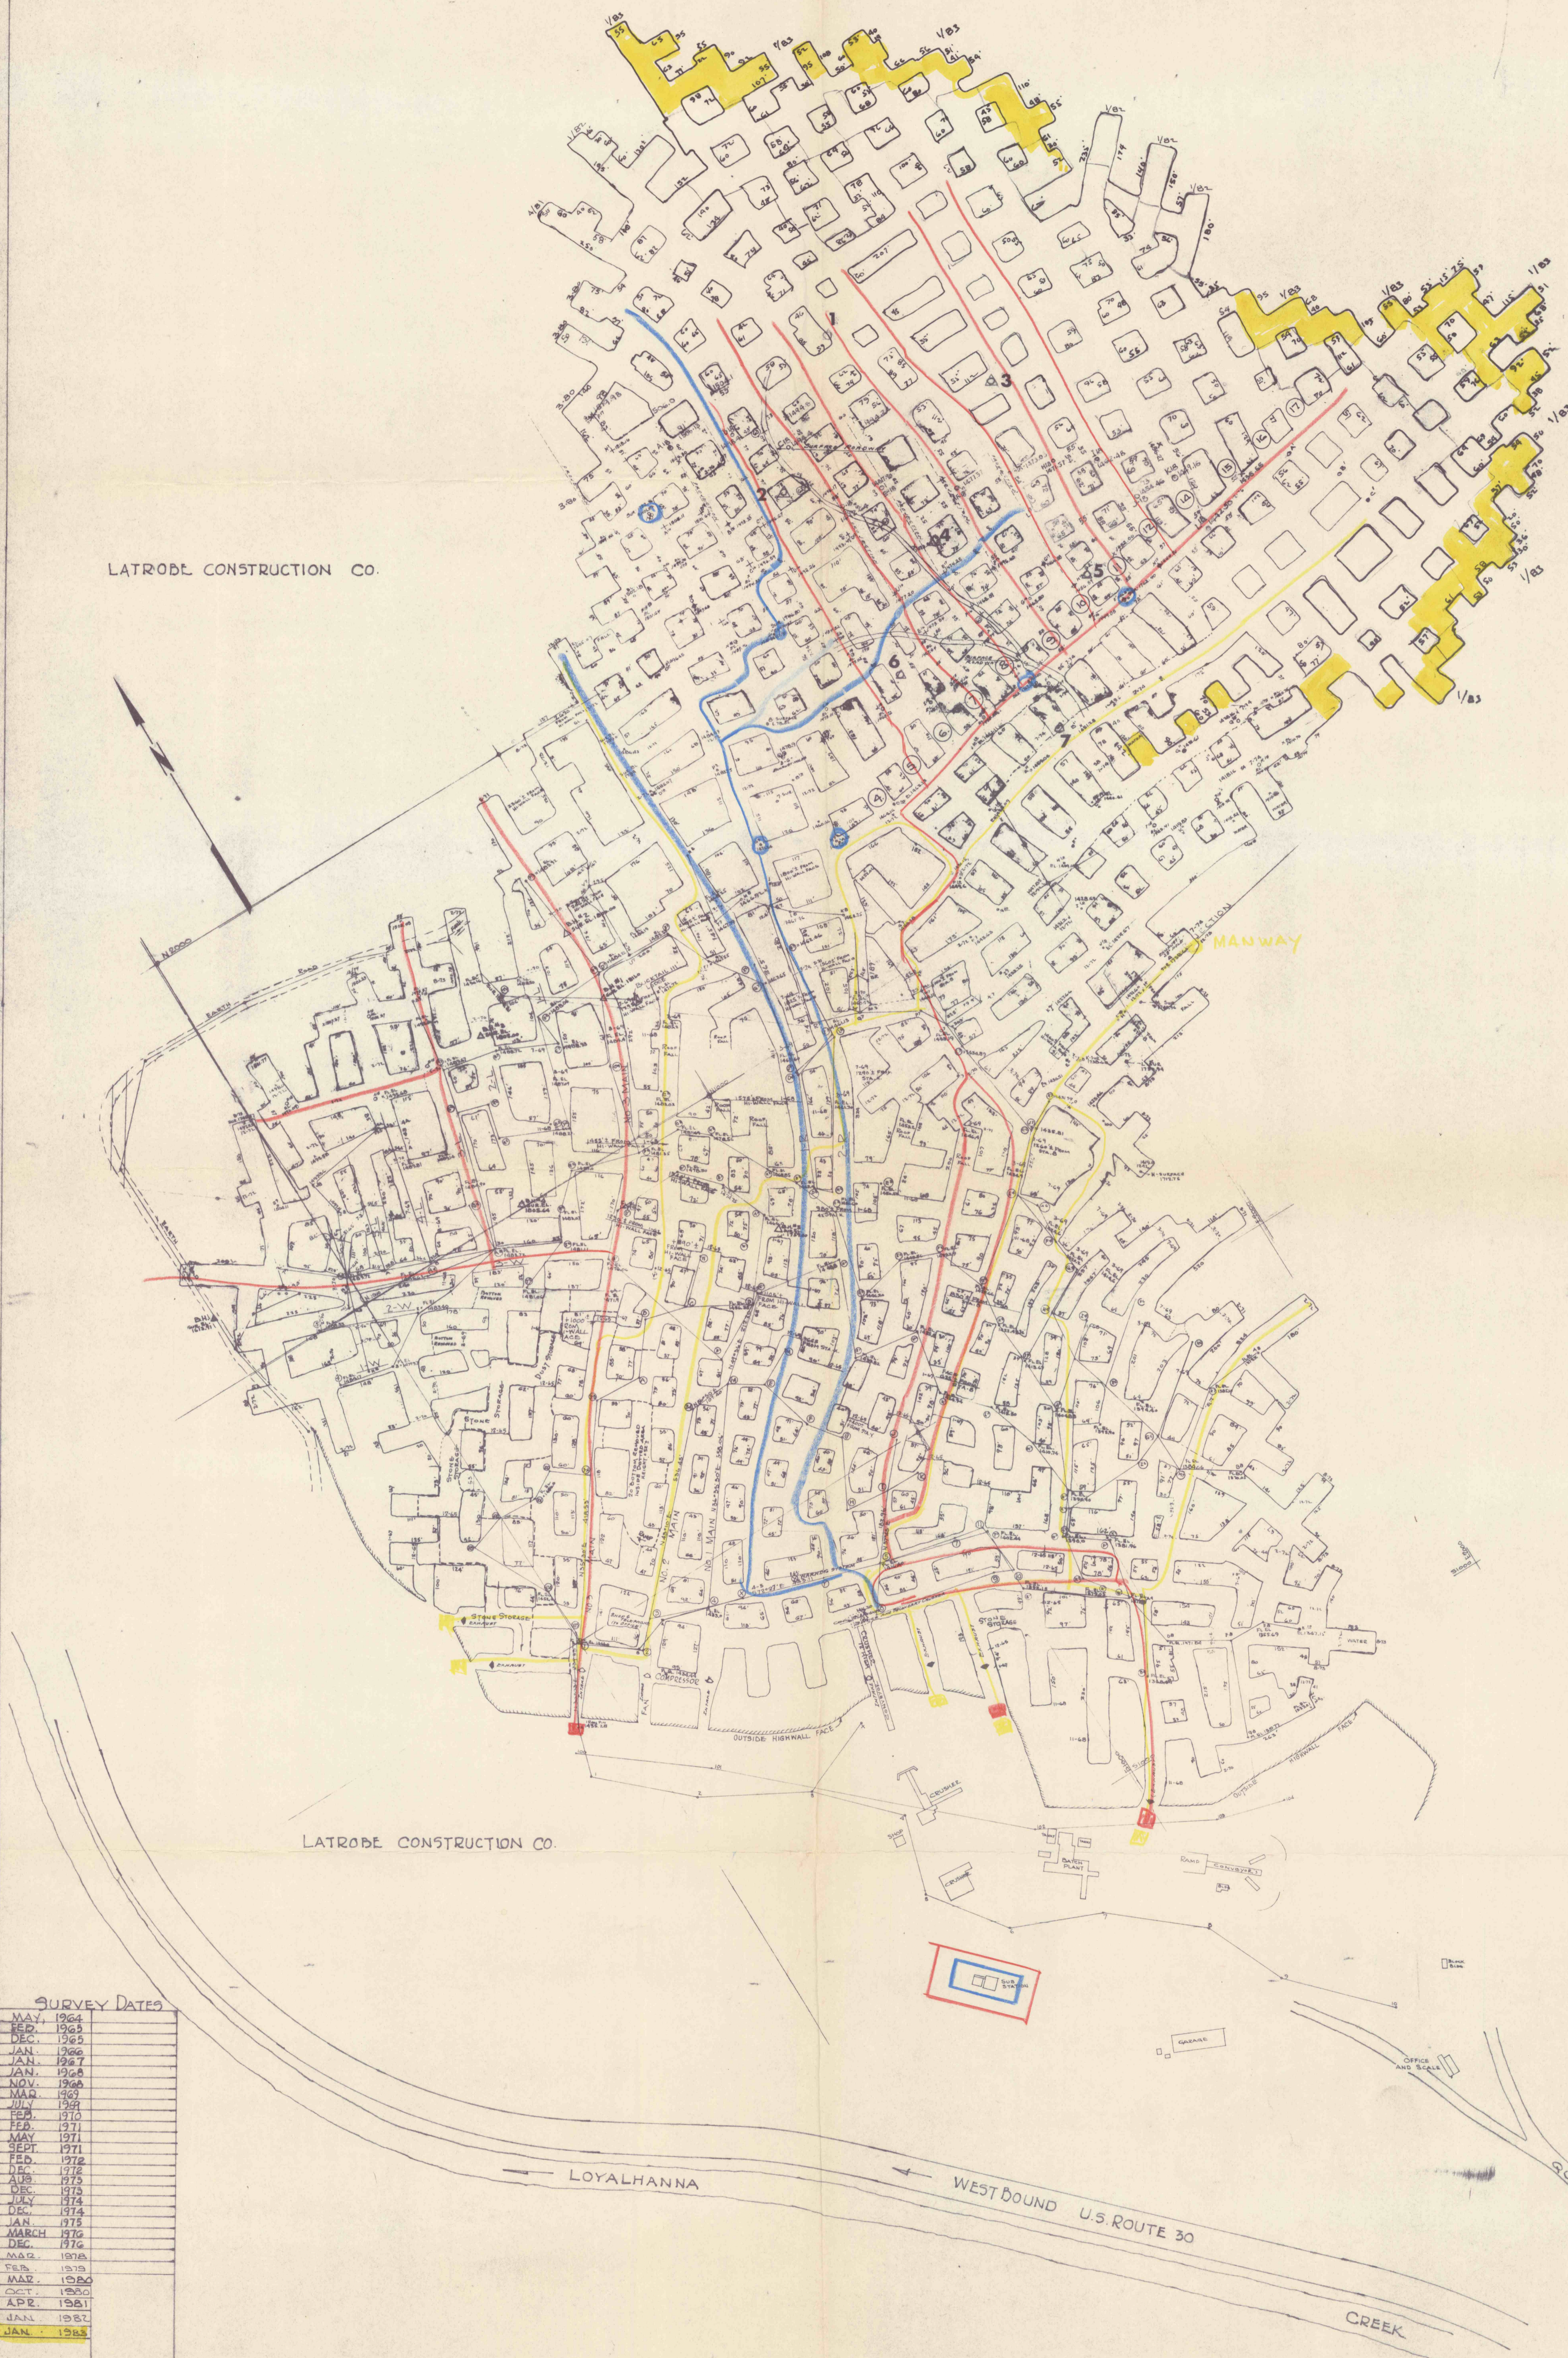


LEGEND

INLET AIRWAY	
OUTLET AIRWAY	
ROADWAY	
SUBSTATION	
ALL HEADINGS	
INLET ENTRY	
ESCAPEWAY	
AIRHOLES	

SURVEY DATES

MAY 1964
FEB 1965
DEC 1965
JAN 1966
JAN 1967
JAN 1968
NOV 1968
MAR 1969
JULY 1969
FEB 1970
FEB 1971
MAY 1971
SEPT 1971
FEB 1972
DEC 1972
AUG 1973
DEC 1973
JULY 1974
DEC 1974
JAN 1975
MARCH 1976
DEC 1976
MAR 1978
FEB 1979
MAR 1980
OCT 1980
APR 1981
JAN 1987
JAN 1988

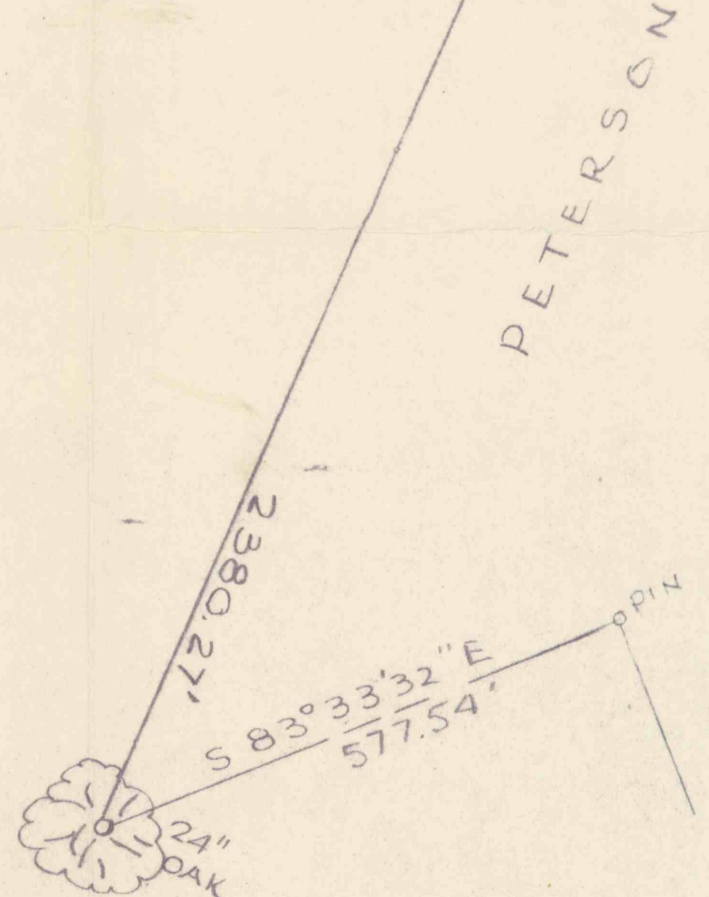

LATROBE CONSTRUCTION COMPANY
LONGBRIDGE BLUESTONE MINE
 LIGONIER TOWNSHIP, WESTMORELAND COUNTY, PA.
 SCALE: 1"=200' FEBRUARY, 1977
 GIBSON-THOMAS ENGINEERING CO. LATROBE, PA.
 REDUCED FROM AN ORIGINAL PLAN DATED FEB. 1965