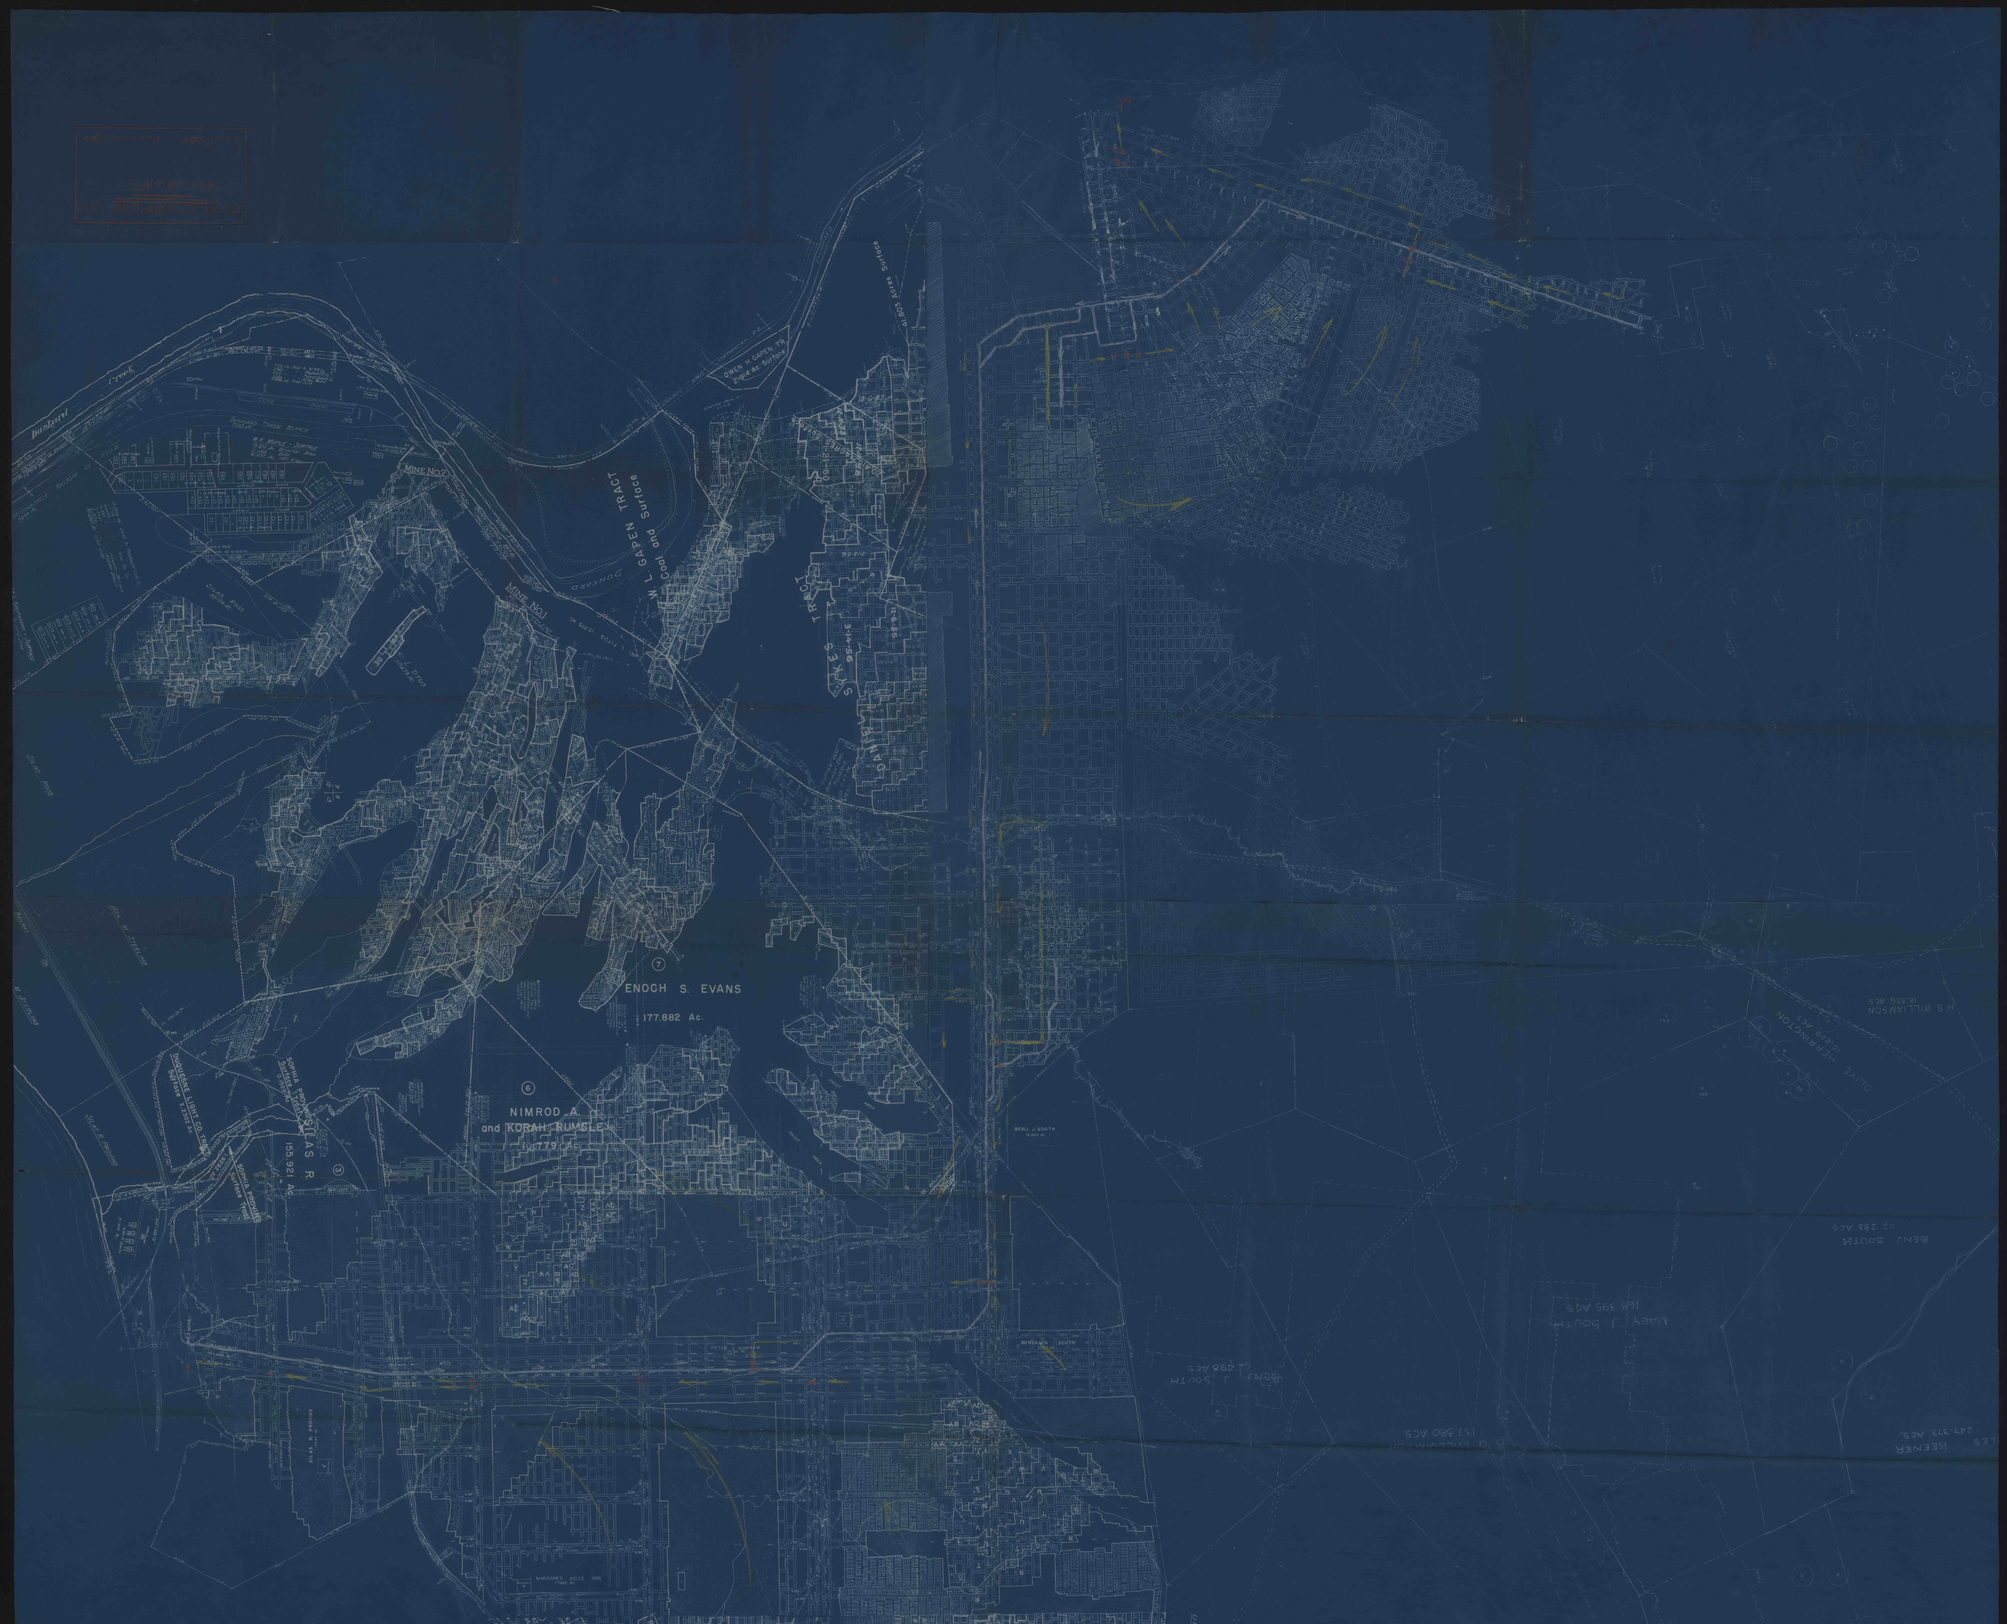
Coal and Surface
Mine No.1
Mine No.2
ENOCH S. EVANS
177.882 Ac.
NIMROD A.
and KORAH RUMSEY
10.779 Ac.
155.921 Ac.