


I, David R. Mills, do hereby certify that this print is a true and correct copy of the original map for Mark Mining No. 2, Inc., Mark No. 1 Mine and that the original map is a true, complete, and correct map and survey of all excavations made through September 30, 1980.

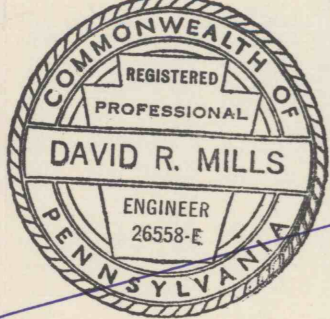

David R. Mills
David R. Mills, P.E.

FERNE GLESSNER MAUST

P.B.S. COALS
D-21

P. B. S. COALS, INC.

P. B. S. COALS
D - 6
L - 48, Tr. 3
CF - 32

P. B. S. COALS, INC.
P. B. S. COALS
D - 16

JOHN KLOTZ

P. B. S. COALS, INC.

P. B. S. COALS

- KEY TO LANDOWNERS (of small parcels)
- 1 Beachley Farm, Inc.
 - 2 Ralph L. Lishia
 - 3 Robert L. & Dorothy A. Deeter
 - 4 Robert L. & Dorothy A. Deeter
 - 5 George M. & Dorothy L. Hostetler
 - 6 P. B. S. Coals, Inc.
 - 7 Charles Webster & Deborah Kay Miller
 - 8 Charles R. & Gladys E. Deeter
 - 9 William H. & Erna C. Burk
 - 10 James E. & Wanda F. Burk
 - 11 Charles P. & Elizabeth B. Will
 - 12 Floyd D. Lehman
 - 13 P. B. S. Coals, Inc.
 - 27 Kenneth Lehman

ELEANORE MAE MAUST, ETAL.

P. B. S. COALS
L - 21 Tr. 2, 3

KENNETH U. & DORIS J. LEHMAN

PONFEIGH LAND AND MINING COMPANY

MARK MINING NO. 2 INC

MARK NO. 2 MINE


STONycreek, SOMERSET, & BROTHERS VALLEY TOWNSHIPS

SCALE 1" = 200' SOMERSET COUNTY

DATE: 3-16-87 SEAM: LOWER FREEPORT COAL

REMARKS: FINAL MAP

- LEGEND
- RAILROAD
 - LAKE, POND
 - FENCE
 - SWAMP
 - WOODS LINE
 - BENCH MARK
 - TRAVERSE STATION
 - PHOTOGRAMMETRIC SPOT ELEVATION
 - CONTOURS
 - PHOTO CENTER

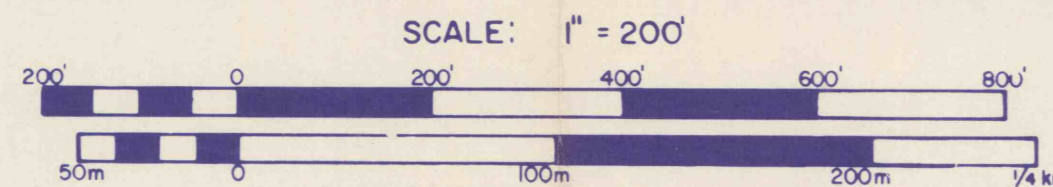

GRID VALUES IN THOUSANDS
GRID BASED ON PENNSYLVANIA STATE PLANE
COORDINATE SYSTEM (SOUTH ZONE) 1977 N.A. DATUM
VERTICAL CONTROL BASED ON 1929 M.S.L. DATUM



1	2	5
3	4	

SHEET INDEX

PLANIMETRIC SERIES

SHEET NO. 1

Sead's Engineering & Associated Design Services
Formerly Guin Engineers, Inc.
1126 Eighth Ave Altoona, PA. 16603

DATE: _____
BROTHERSVALLEY, & SOMERSET TOWNSHIPS
PENNSYLVANIA