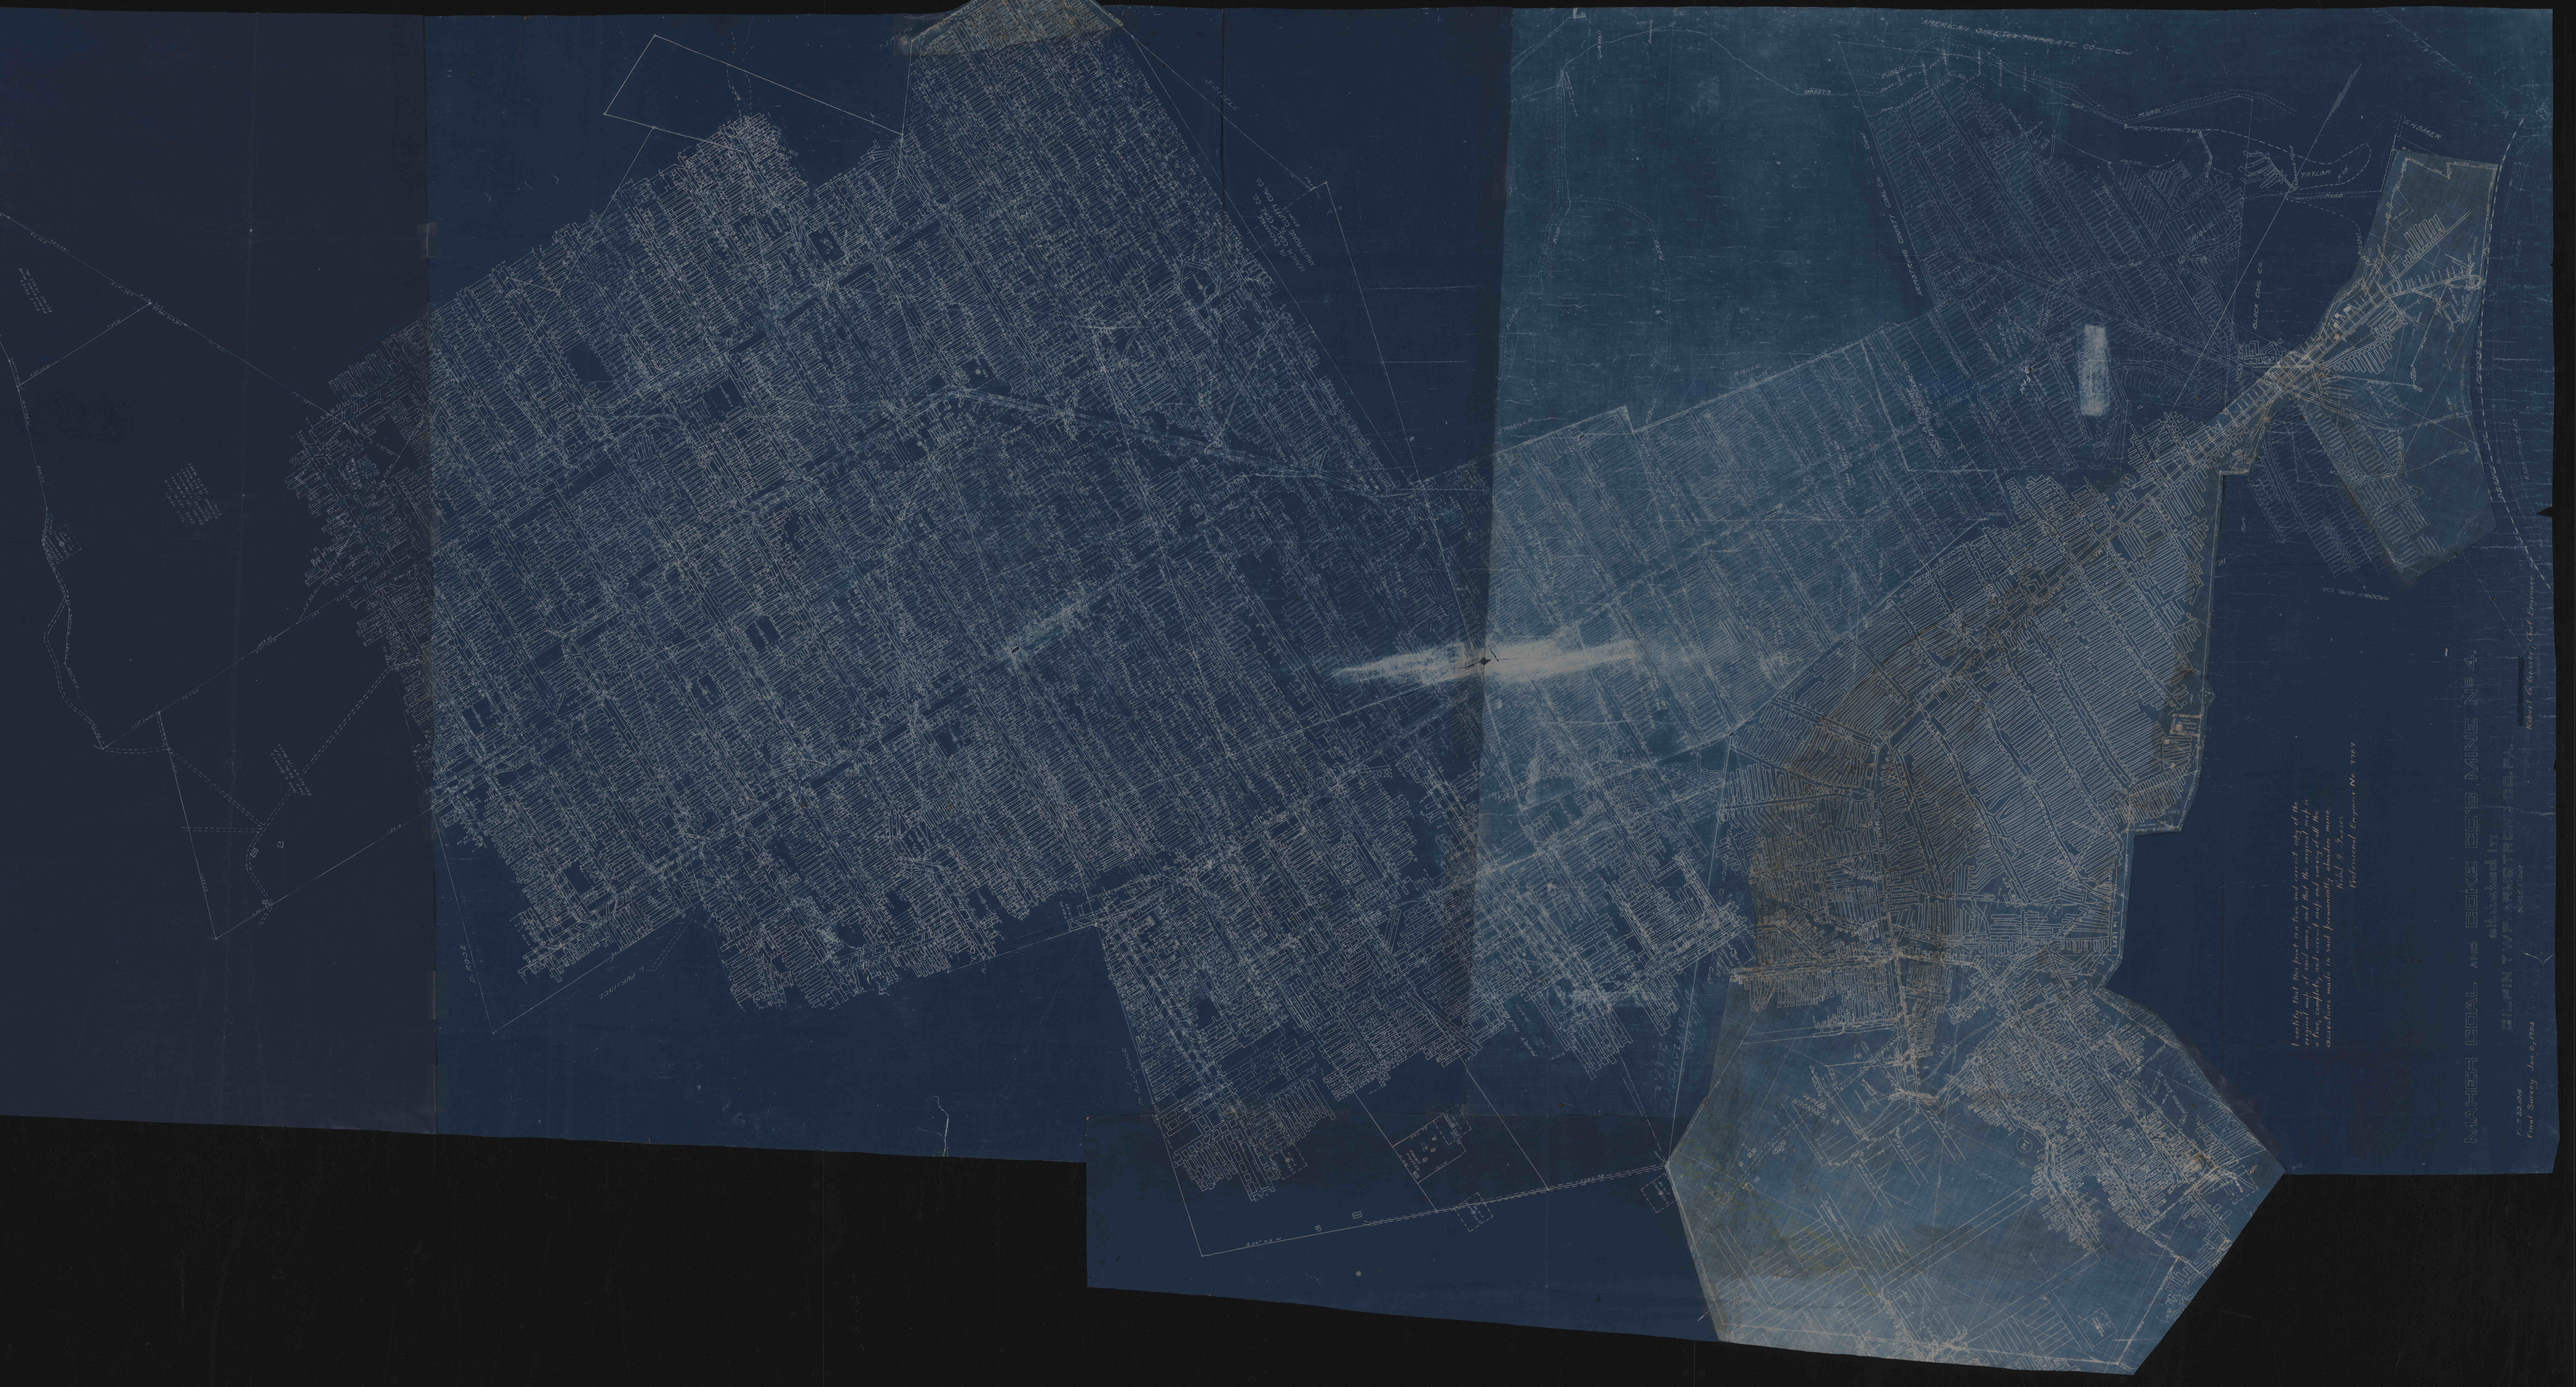
MAHER COAL AND COKE CORP. MINE No. 4
SURFACE PLAT
Robert W. Hamm, Chief Engineer
Final Survey June 9, 1954
AMERICAN SMELTING AND REFINING CO.
AMERICAN SMELTING AND REFINING CO.
AMERICAN SMELTING AND REFINING CO.