


MONT

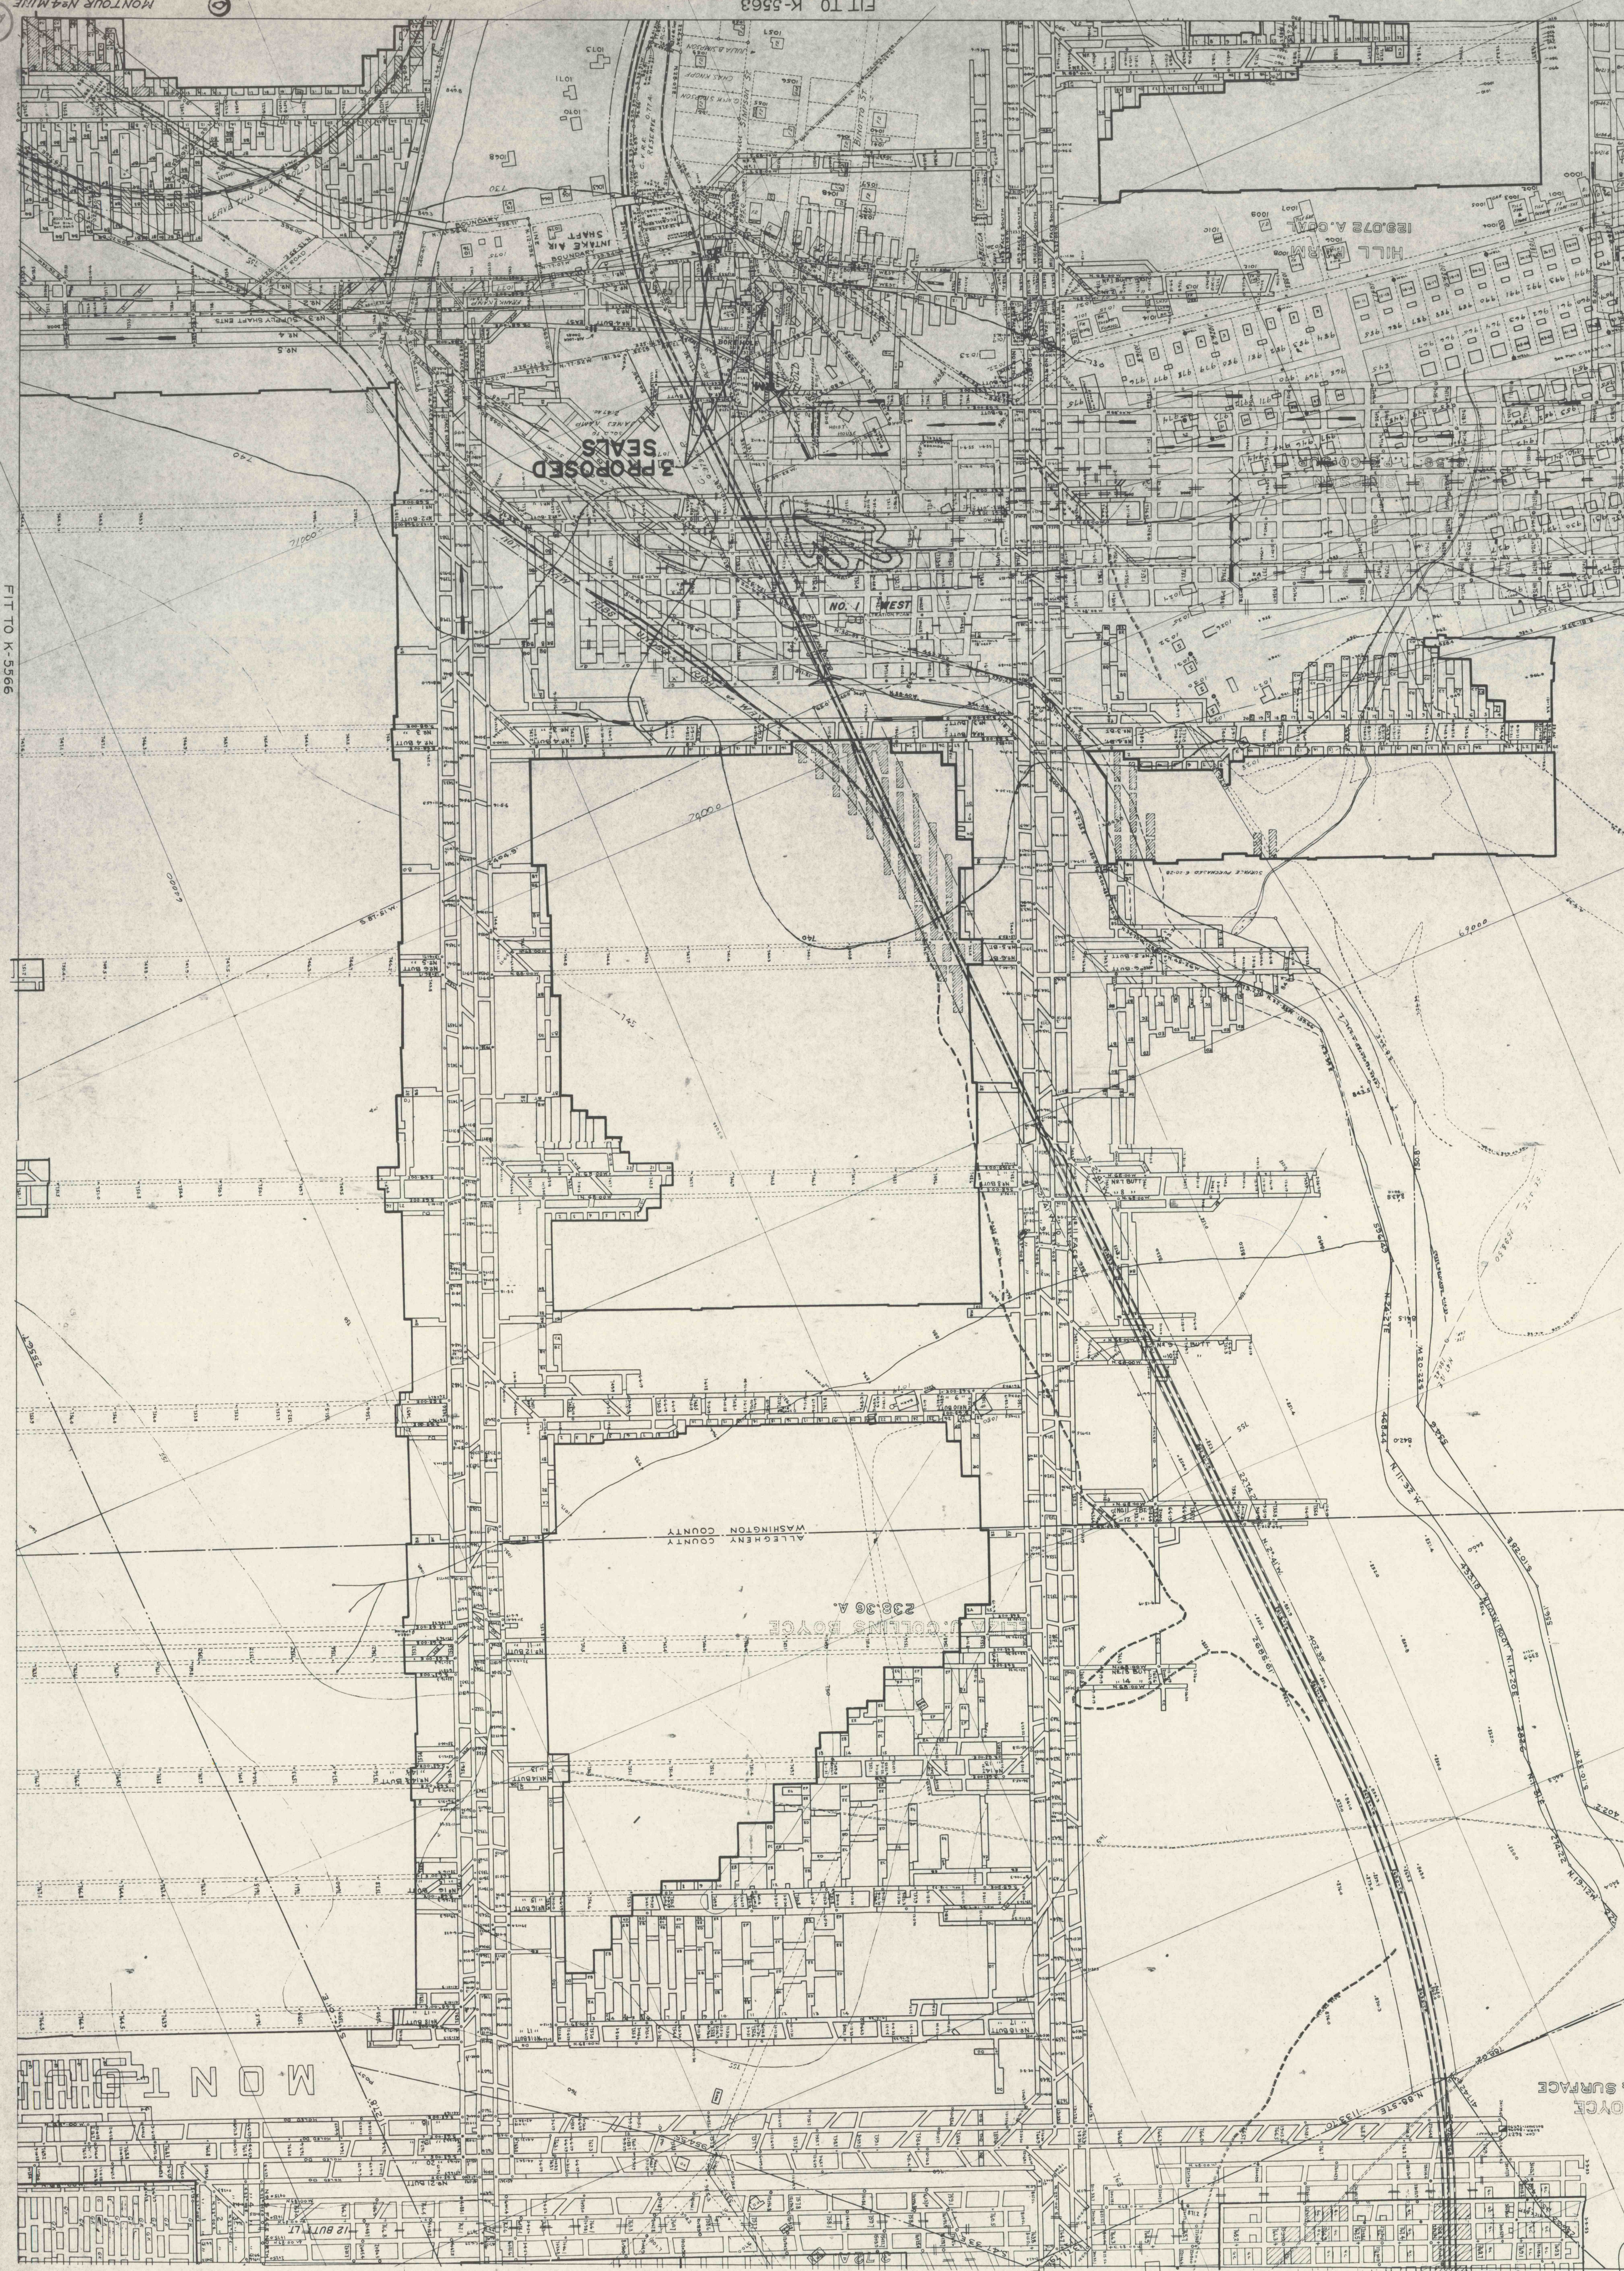

WILLIAM COAL

