


Monroe Mine K 5193

FIG. 10 A-5188

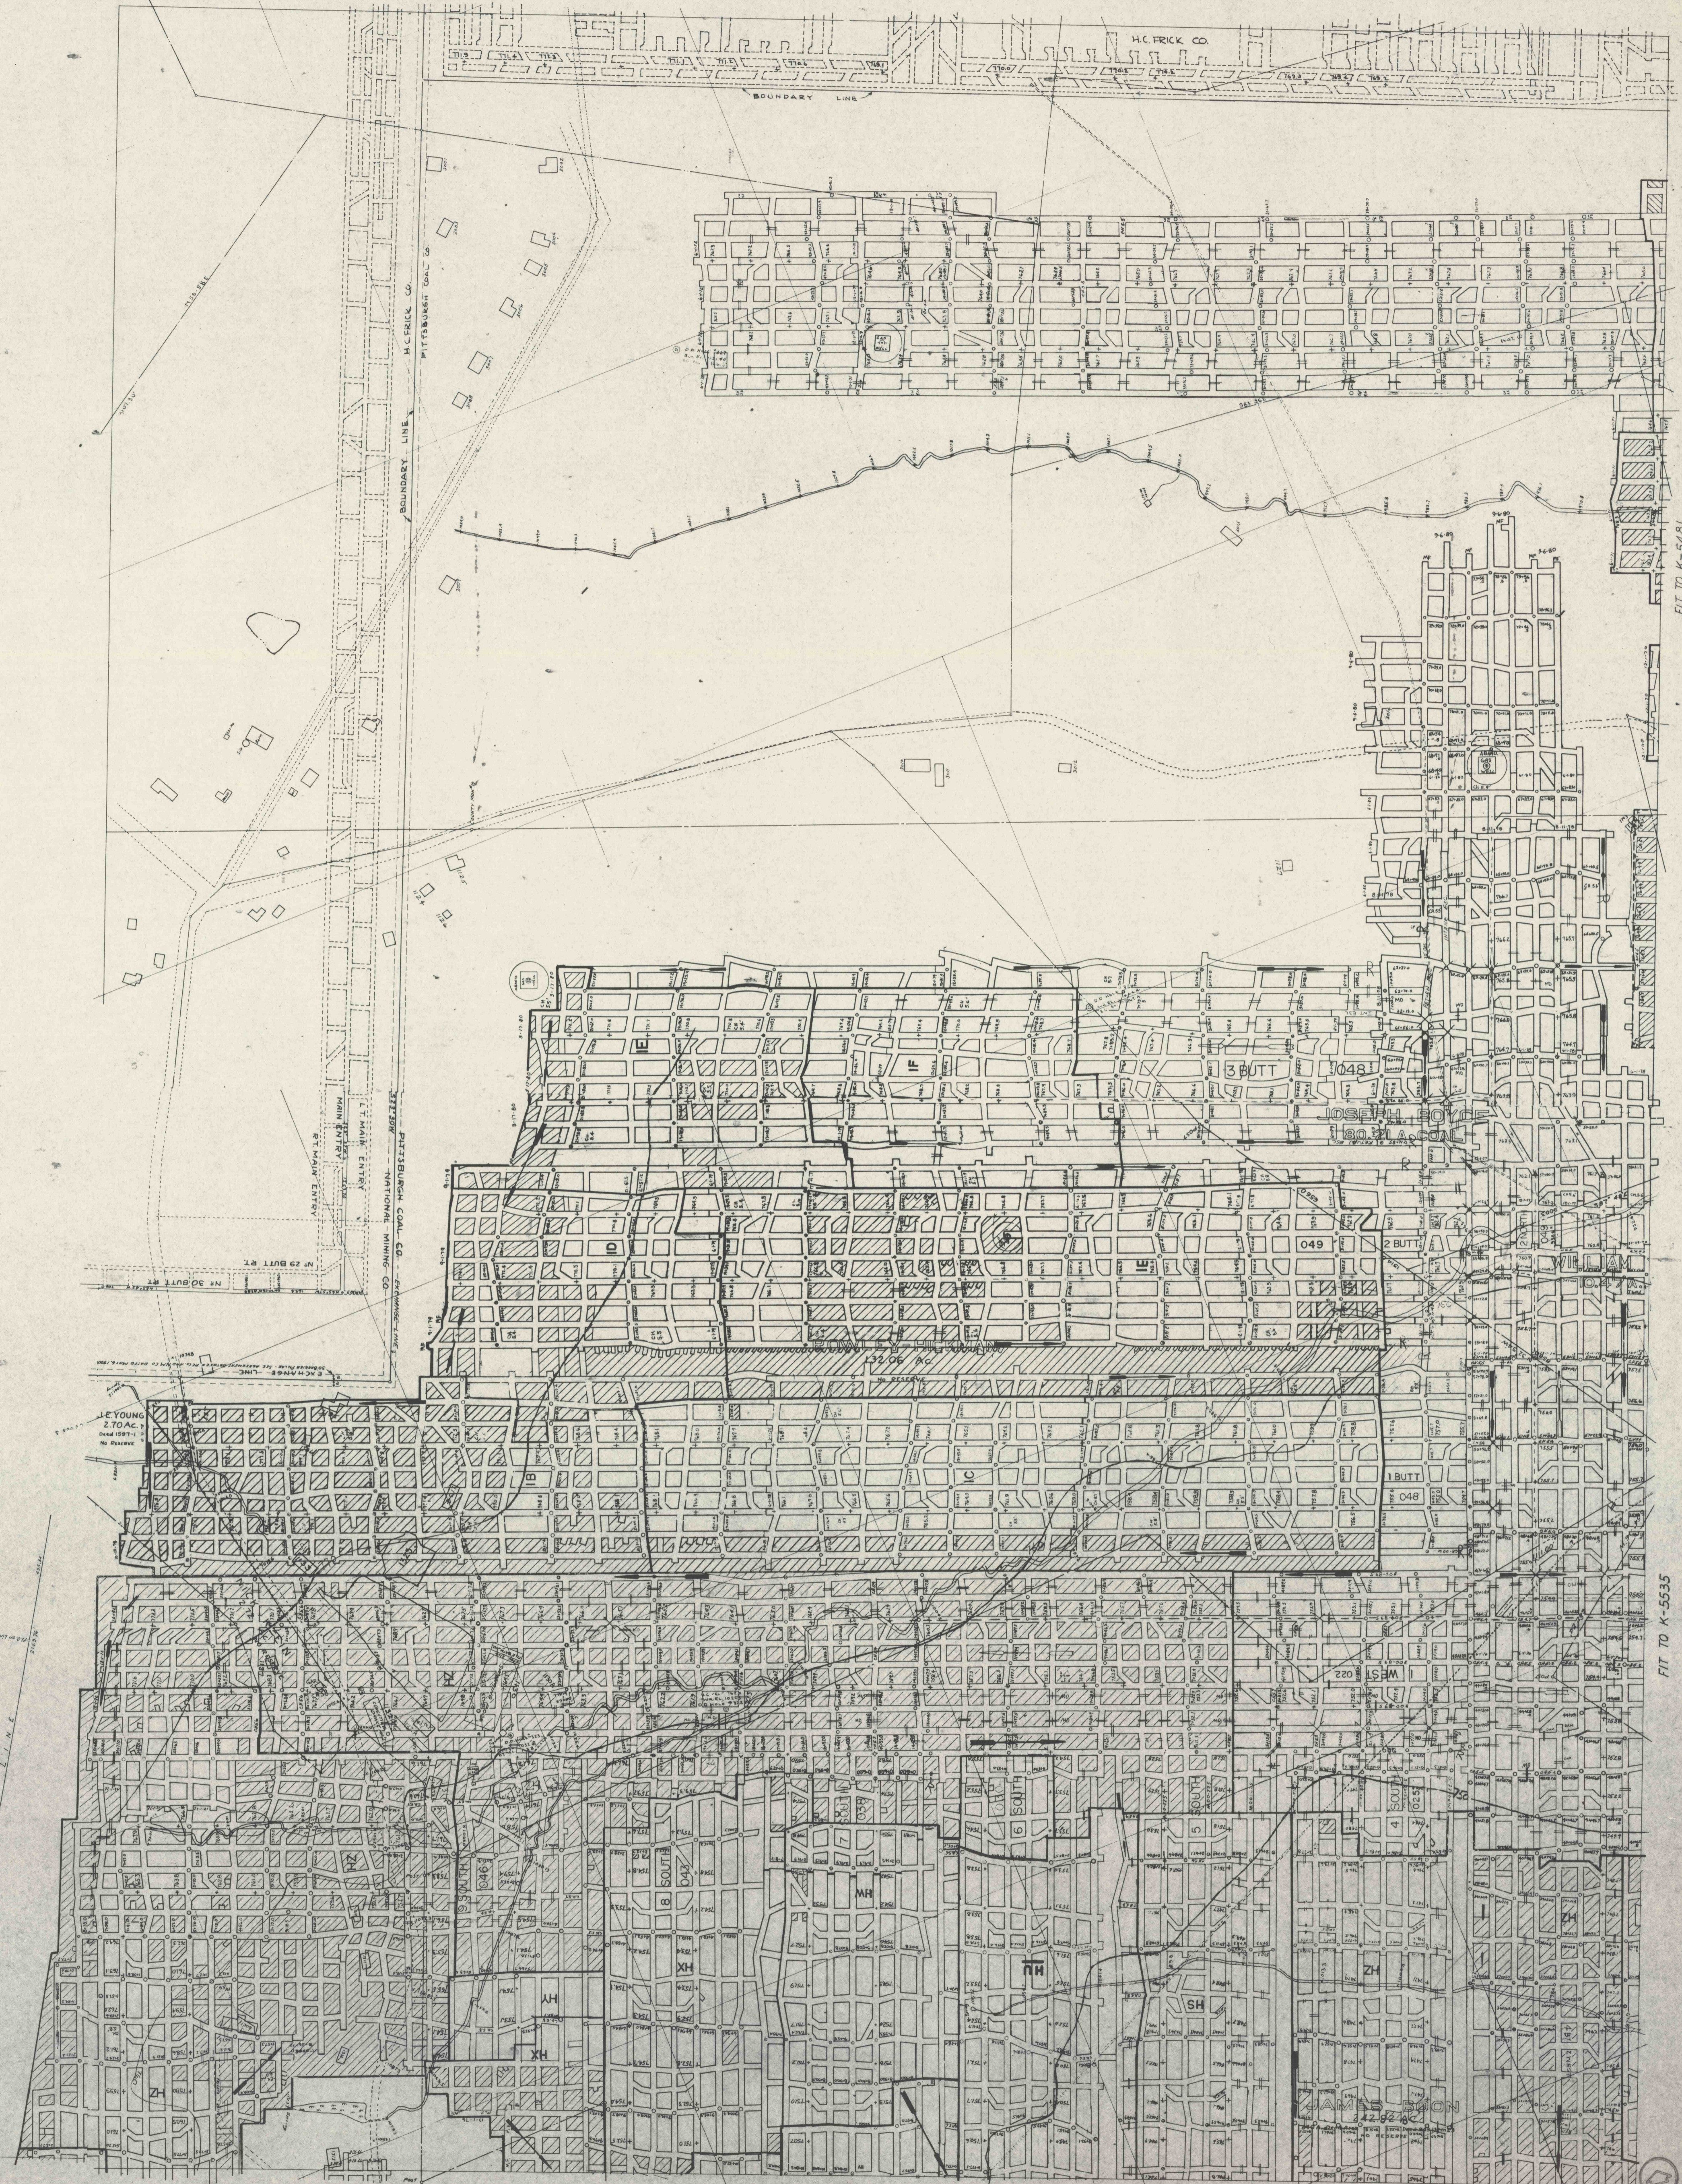

FIT TO 42

FIT TO K-5521

K 5539

FIT TO K-5481

FIT TO K-5535