


Mountaineer Mine K-520

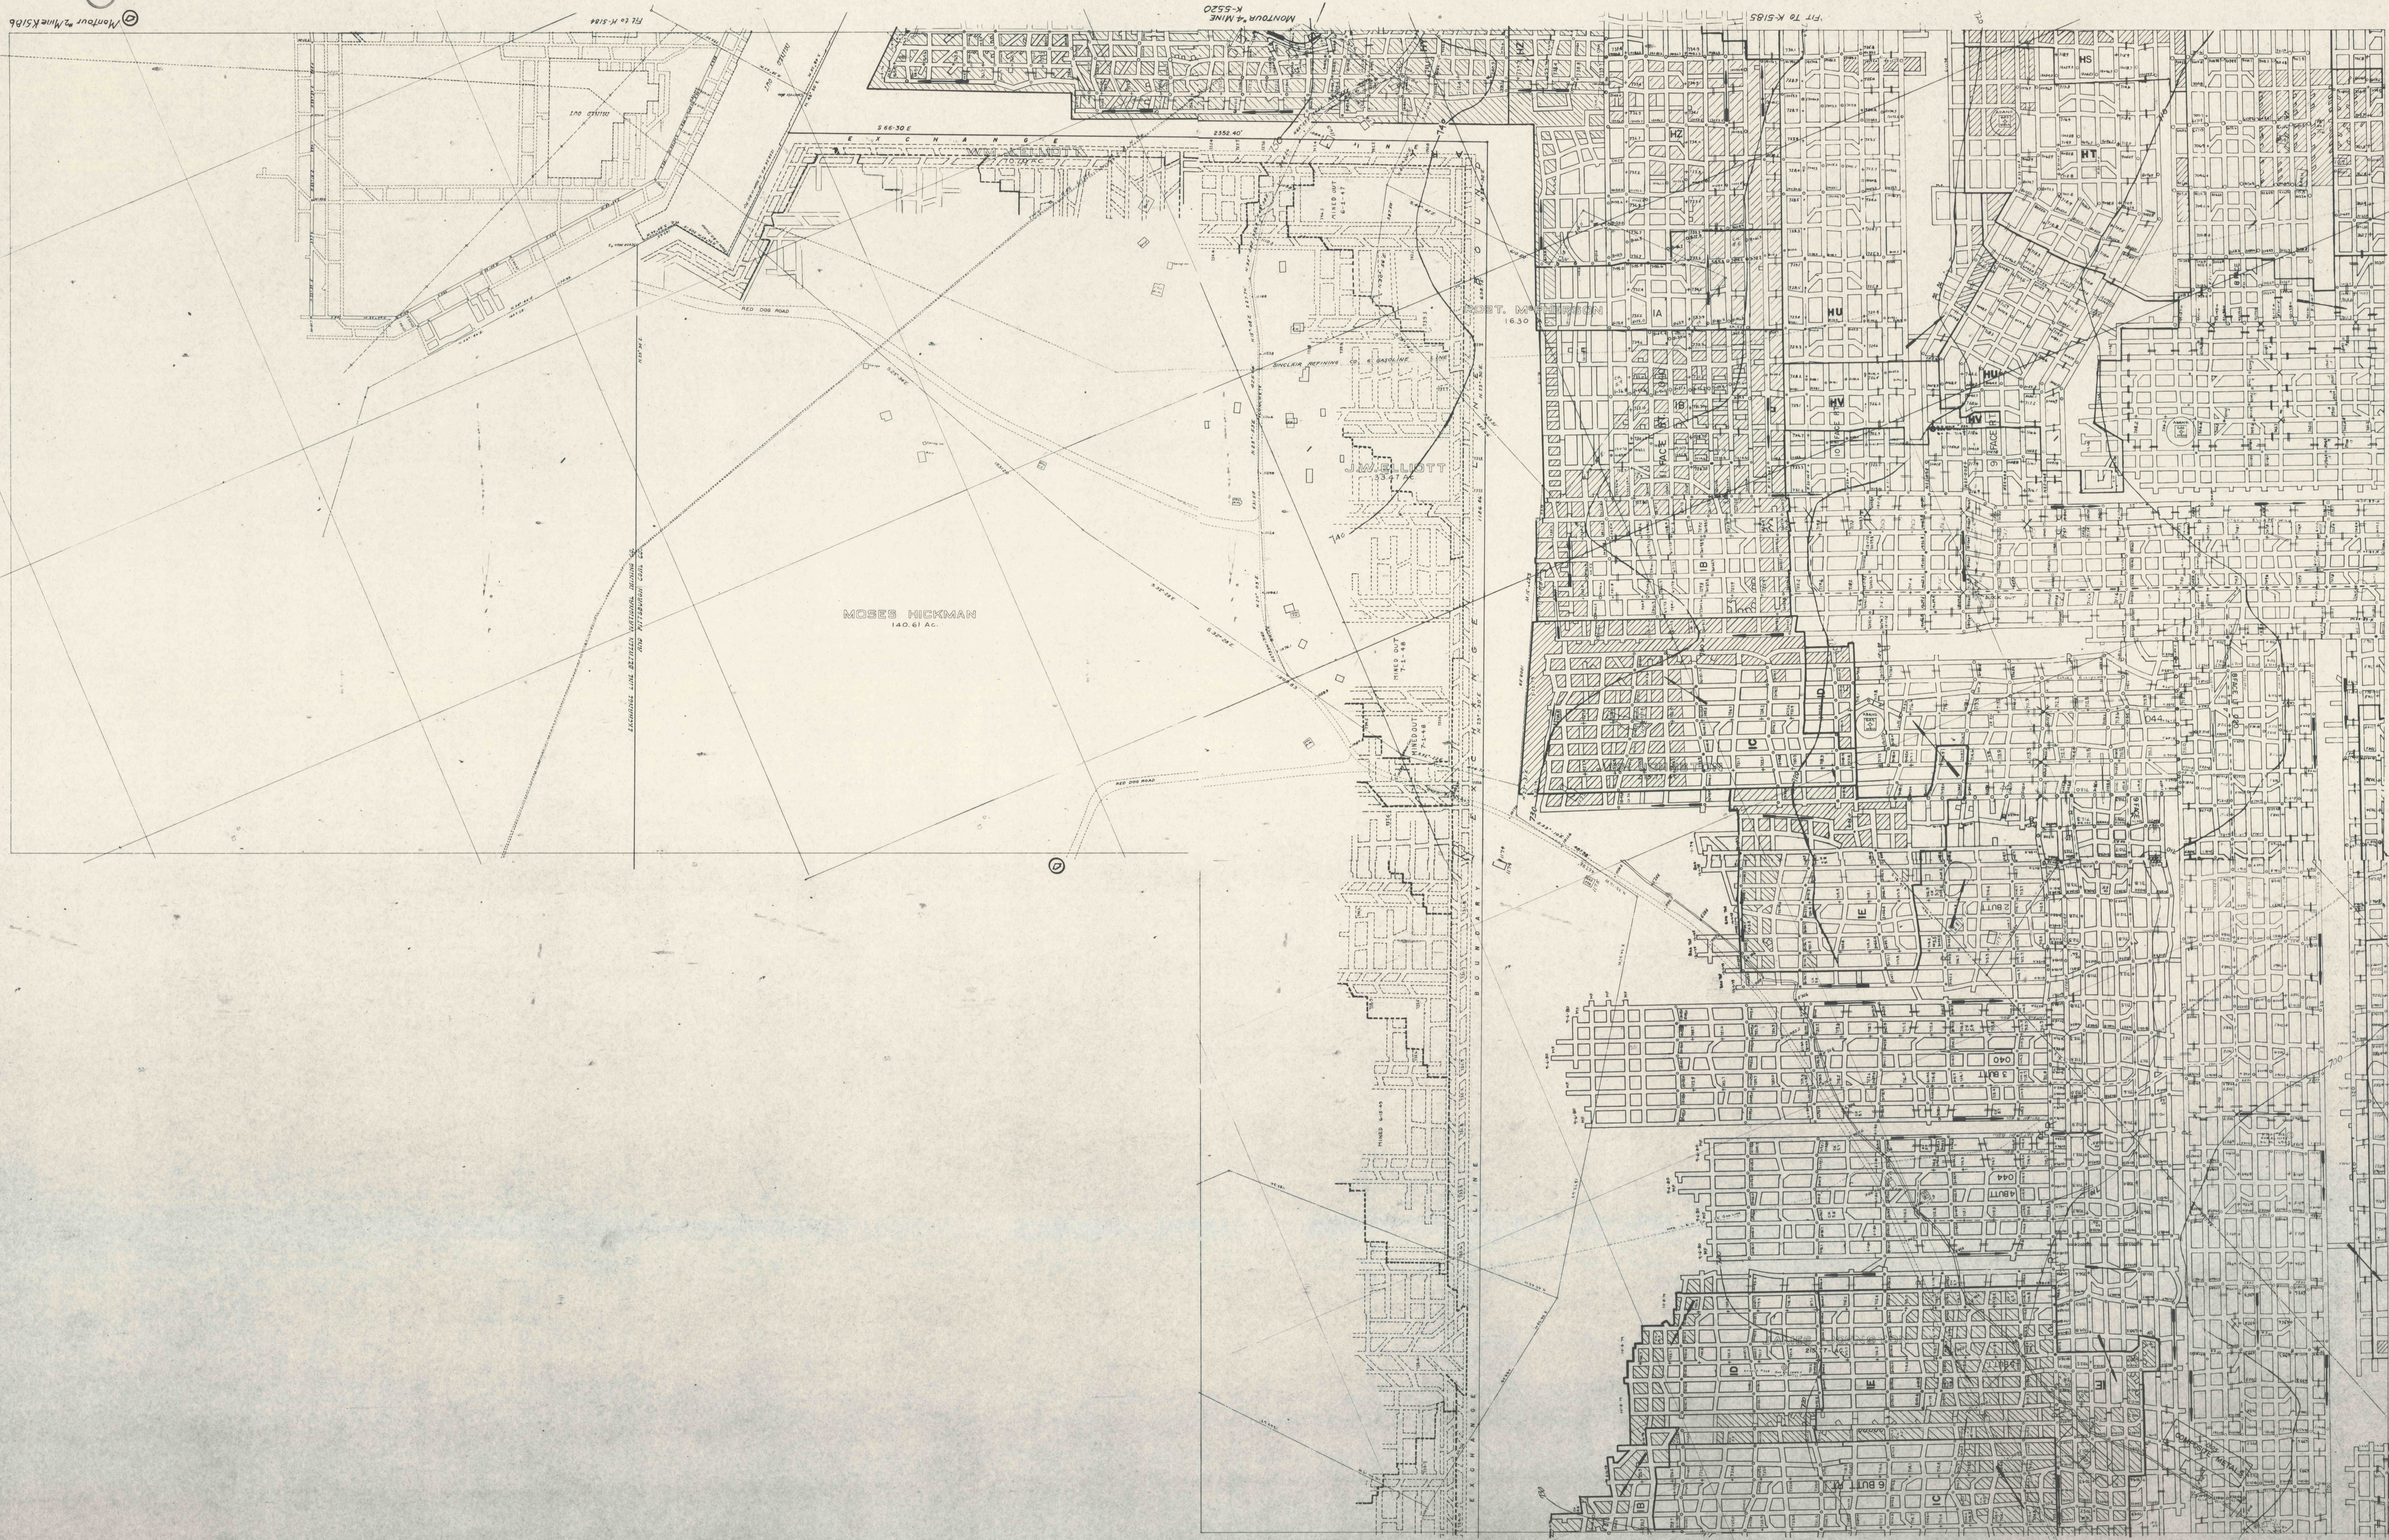

FIT TO 39

FIT TO K-520

5538