



Marshall Wade Hunt  
2-15-80


# COVERDALE OR NO. 8 MINE

BT & CORP

MINED OUT

MINED OUT

MINED OUT

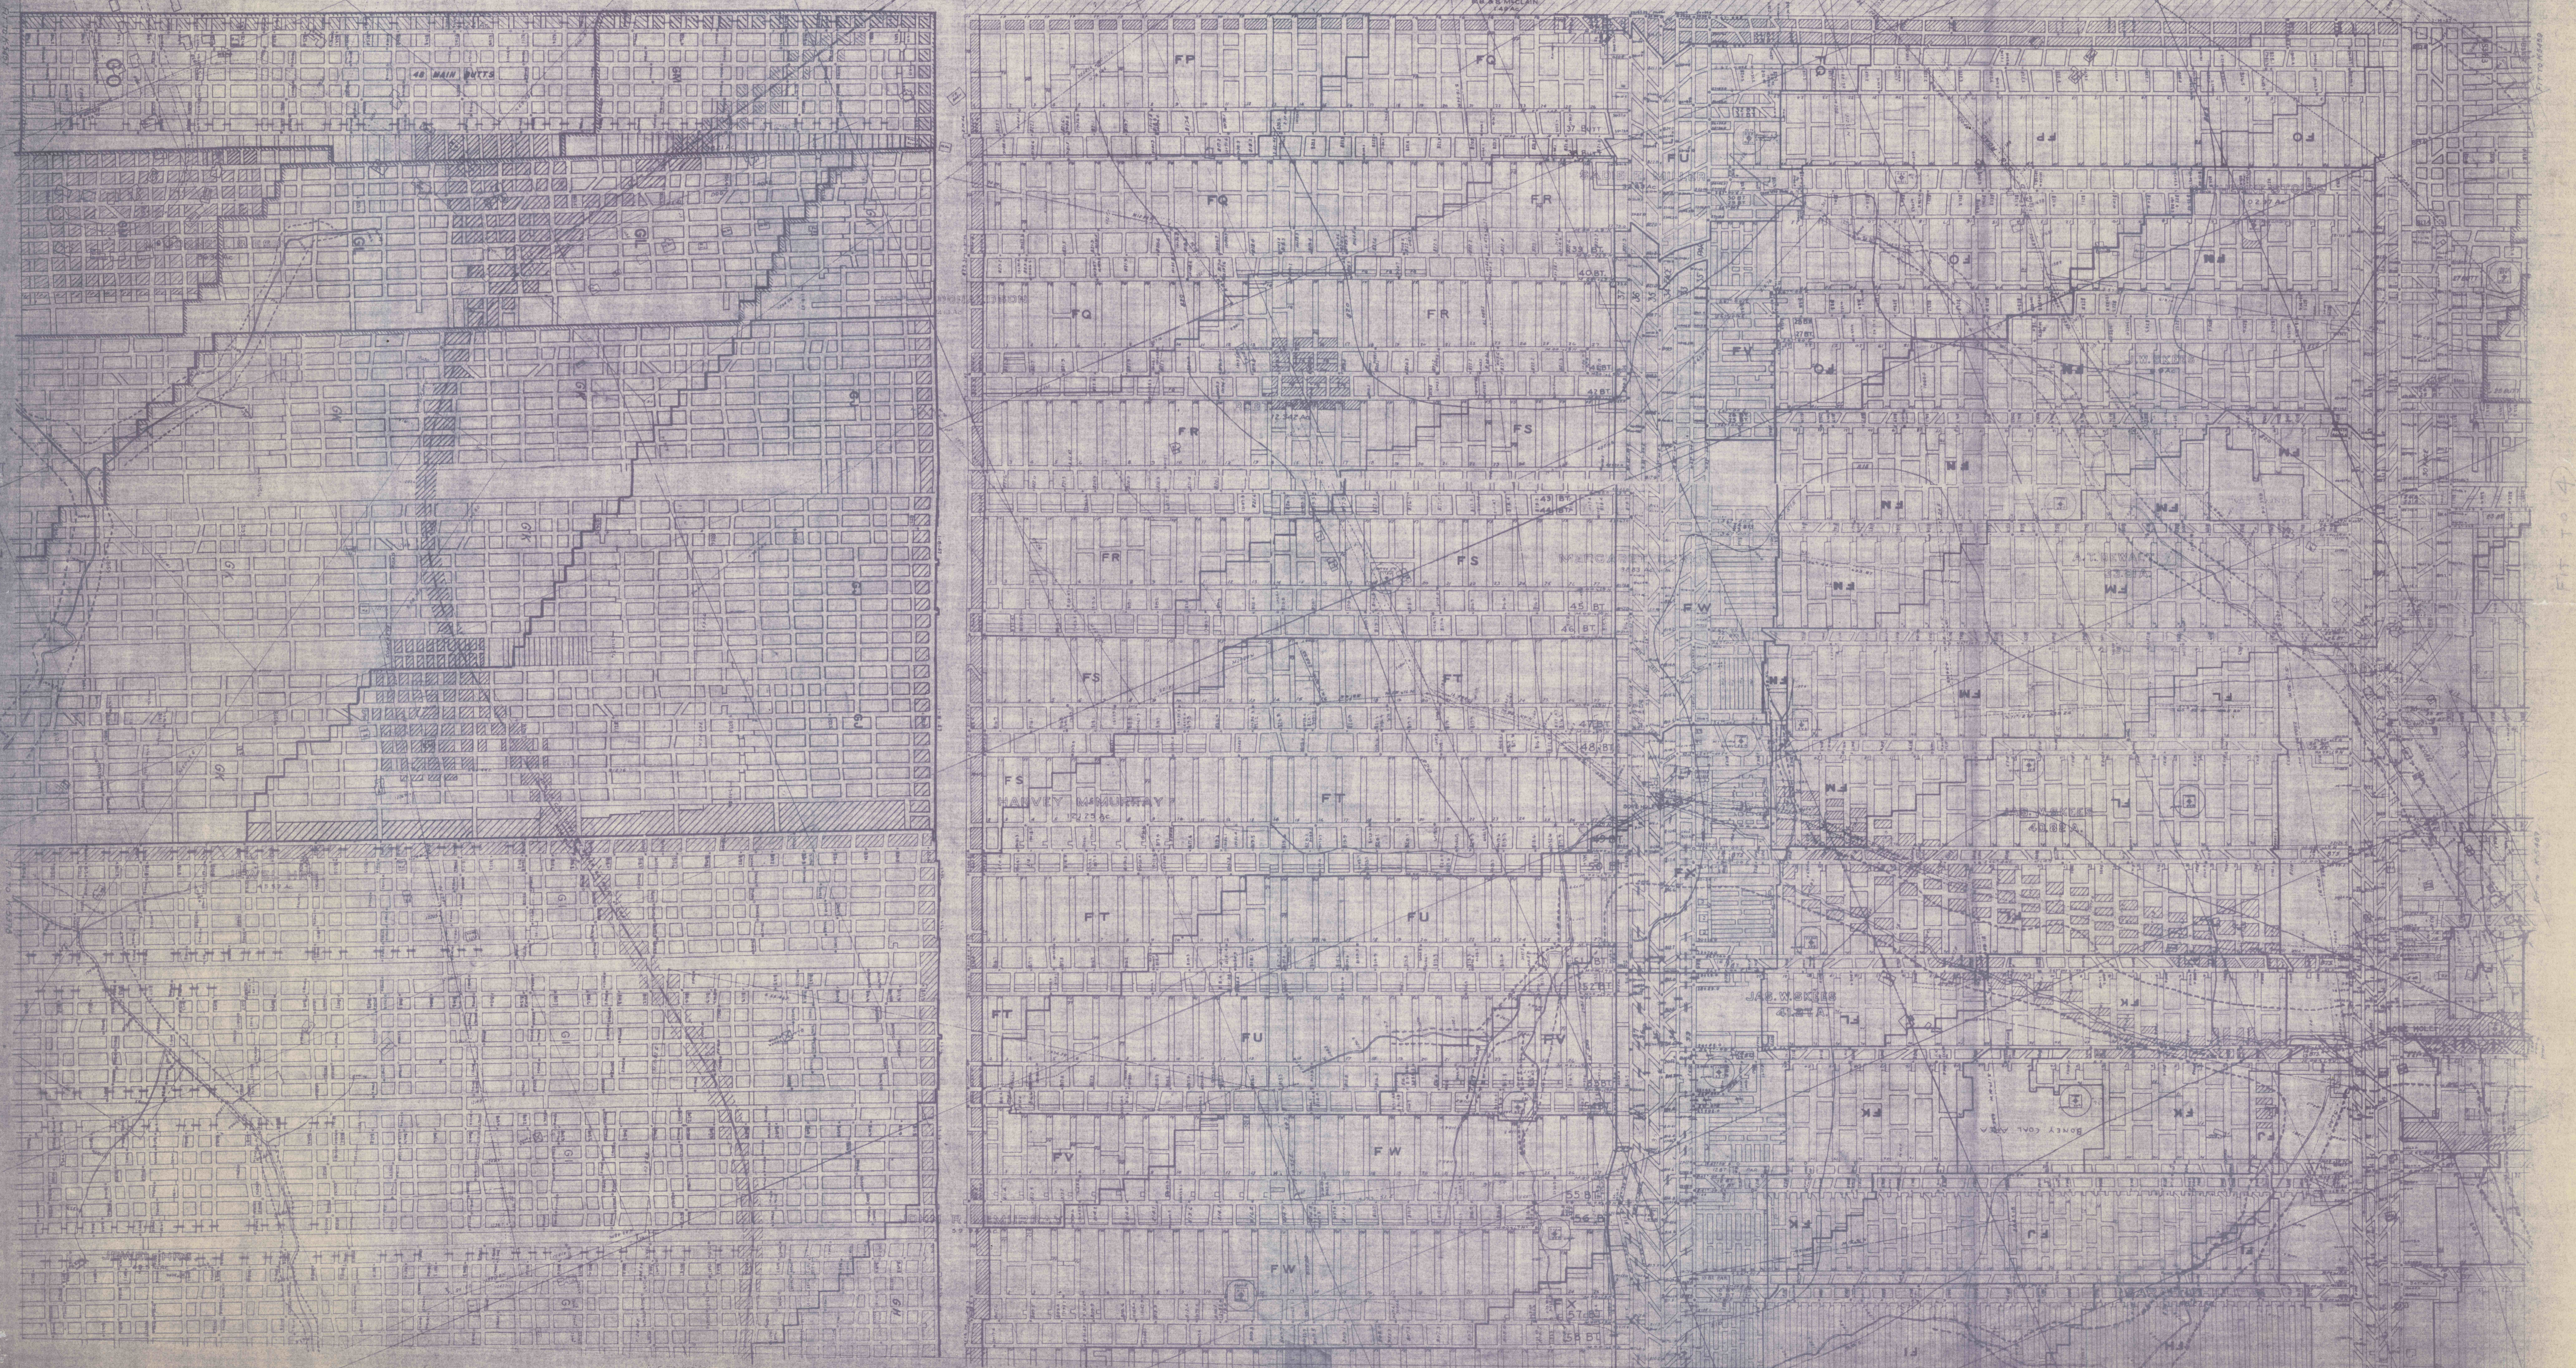

Sheet No. 4