


FIT TO 12

13

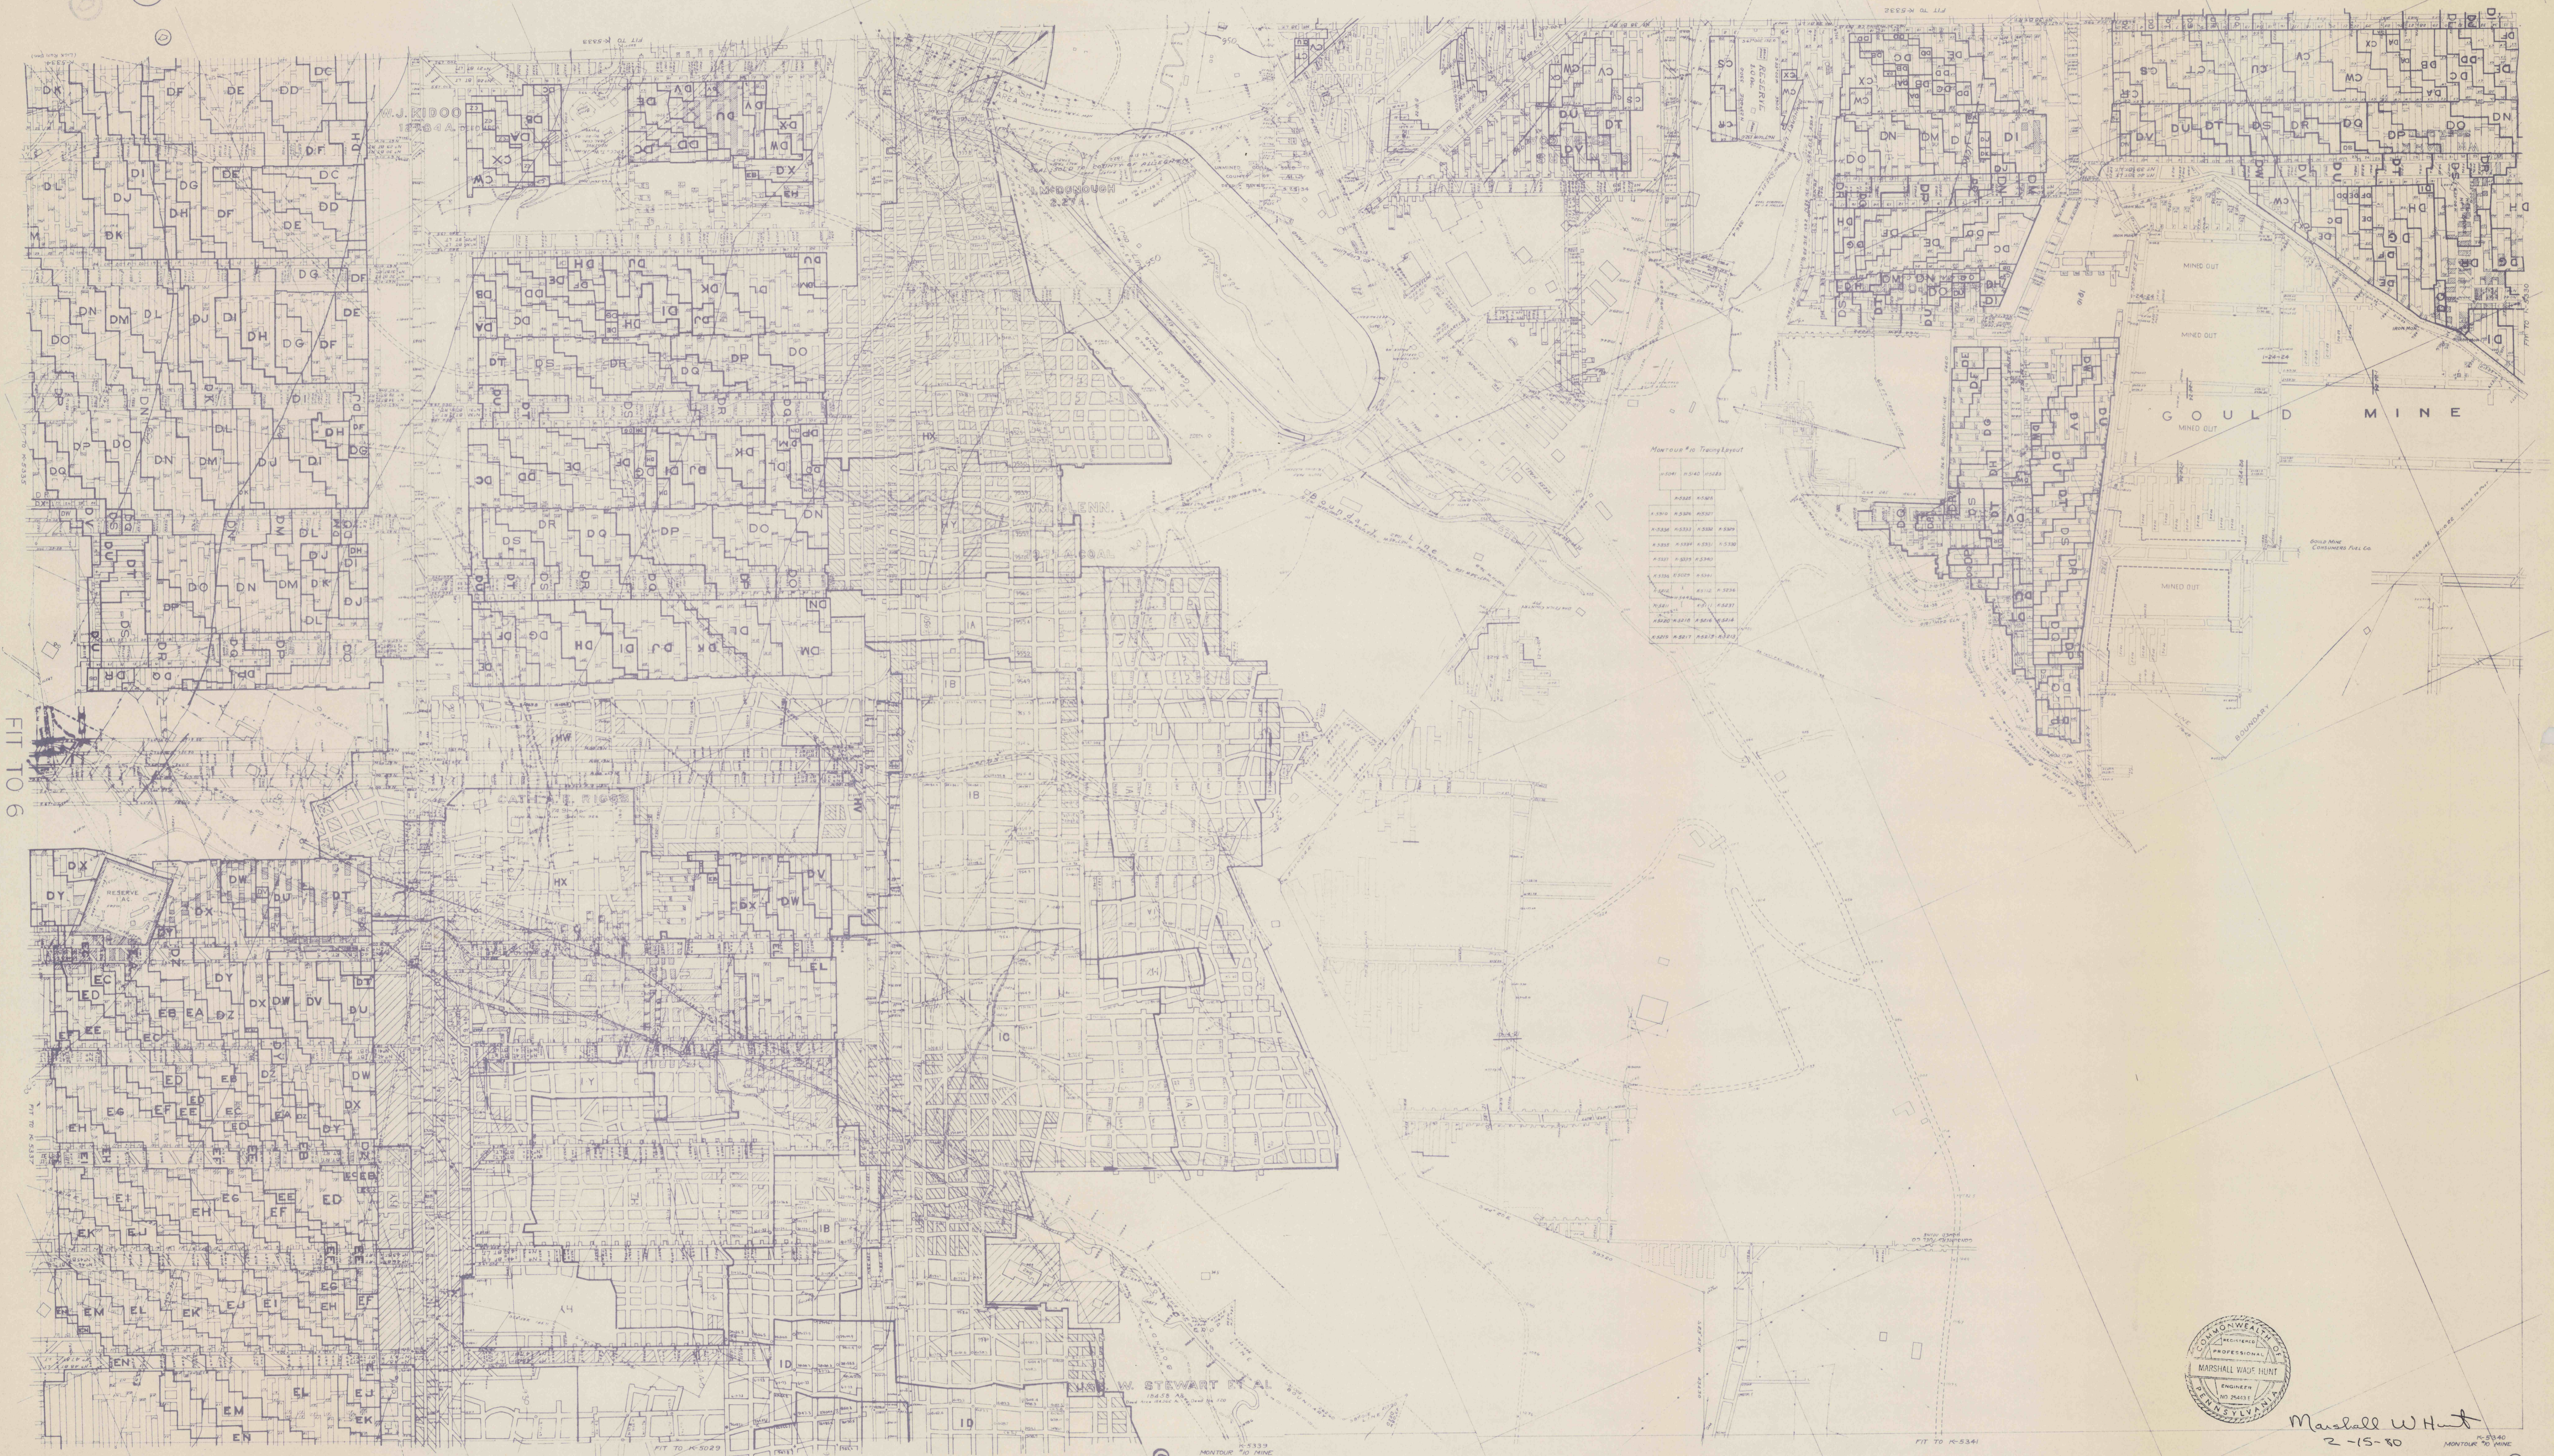

FIT TO 6



Marshall W. Hunt
 2-15-30
 PENNSYLVANIA
 PROFESSIONAL ENGINEER
 No. 25811

FIT TO 14

13