
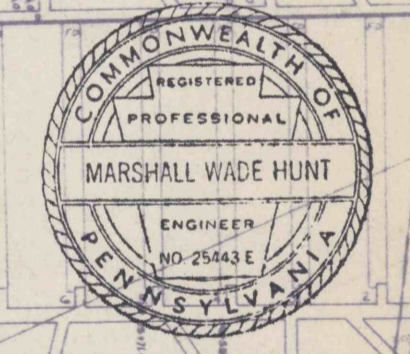


FIT TO 3

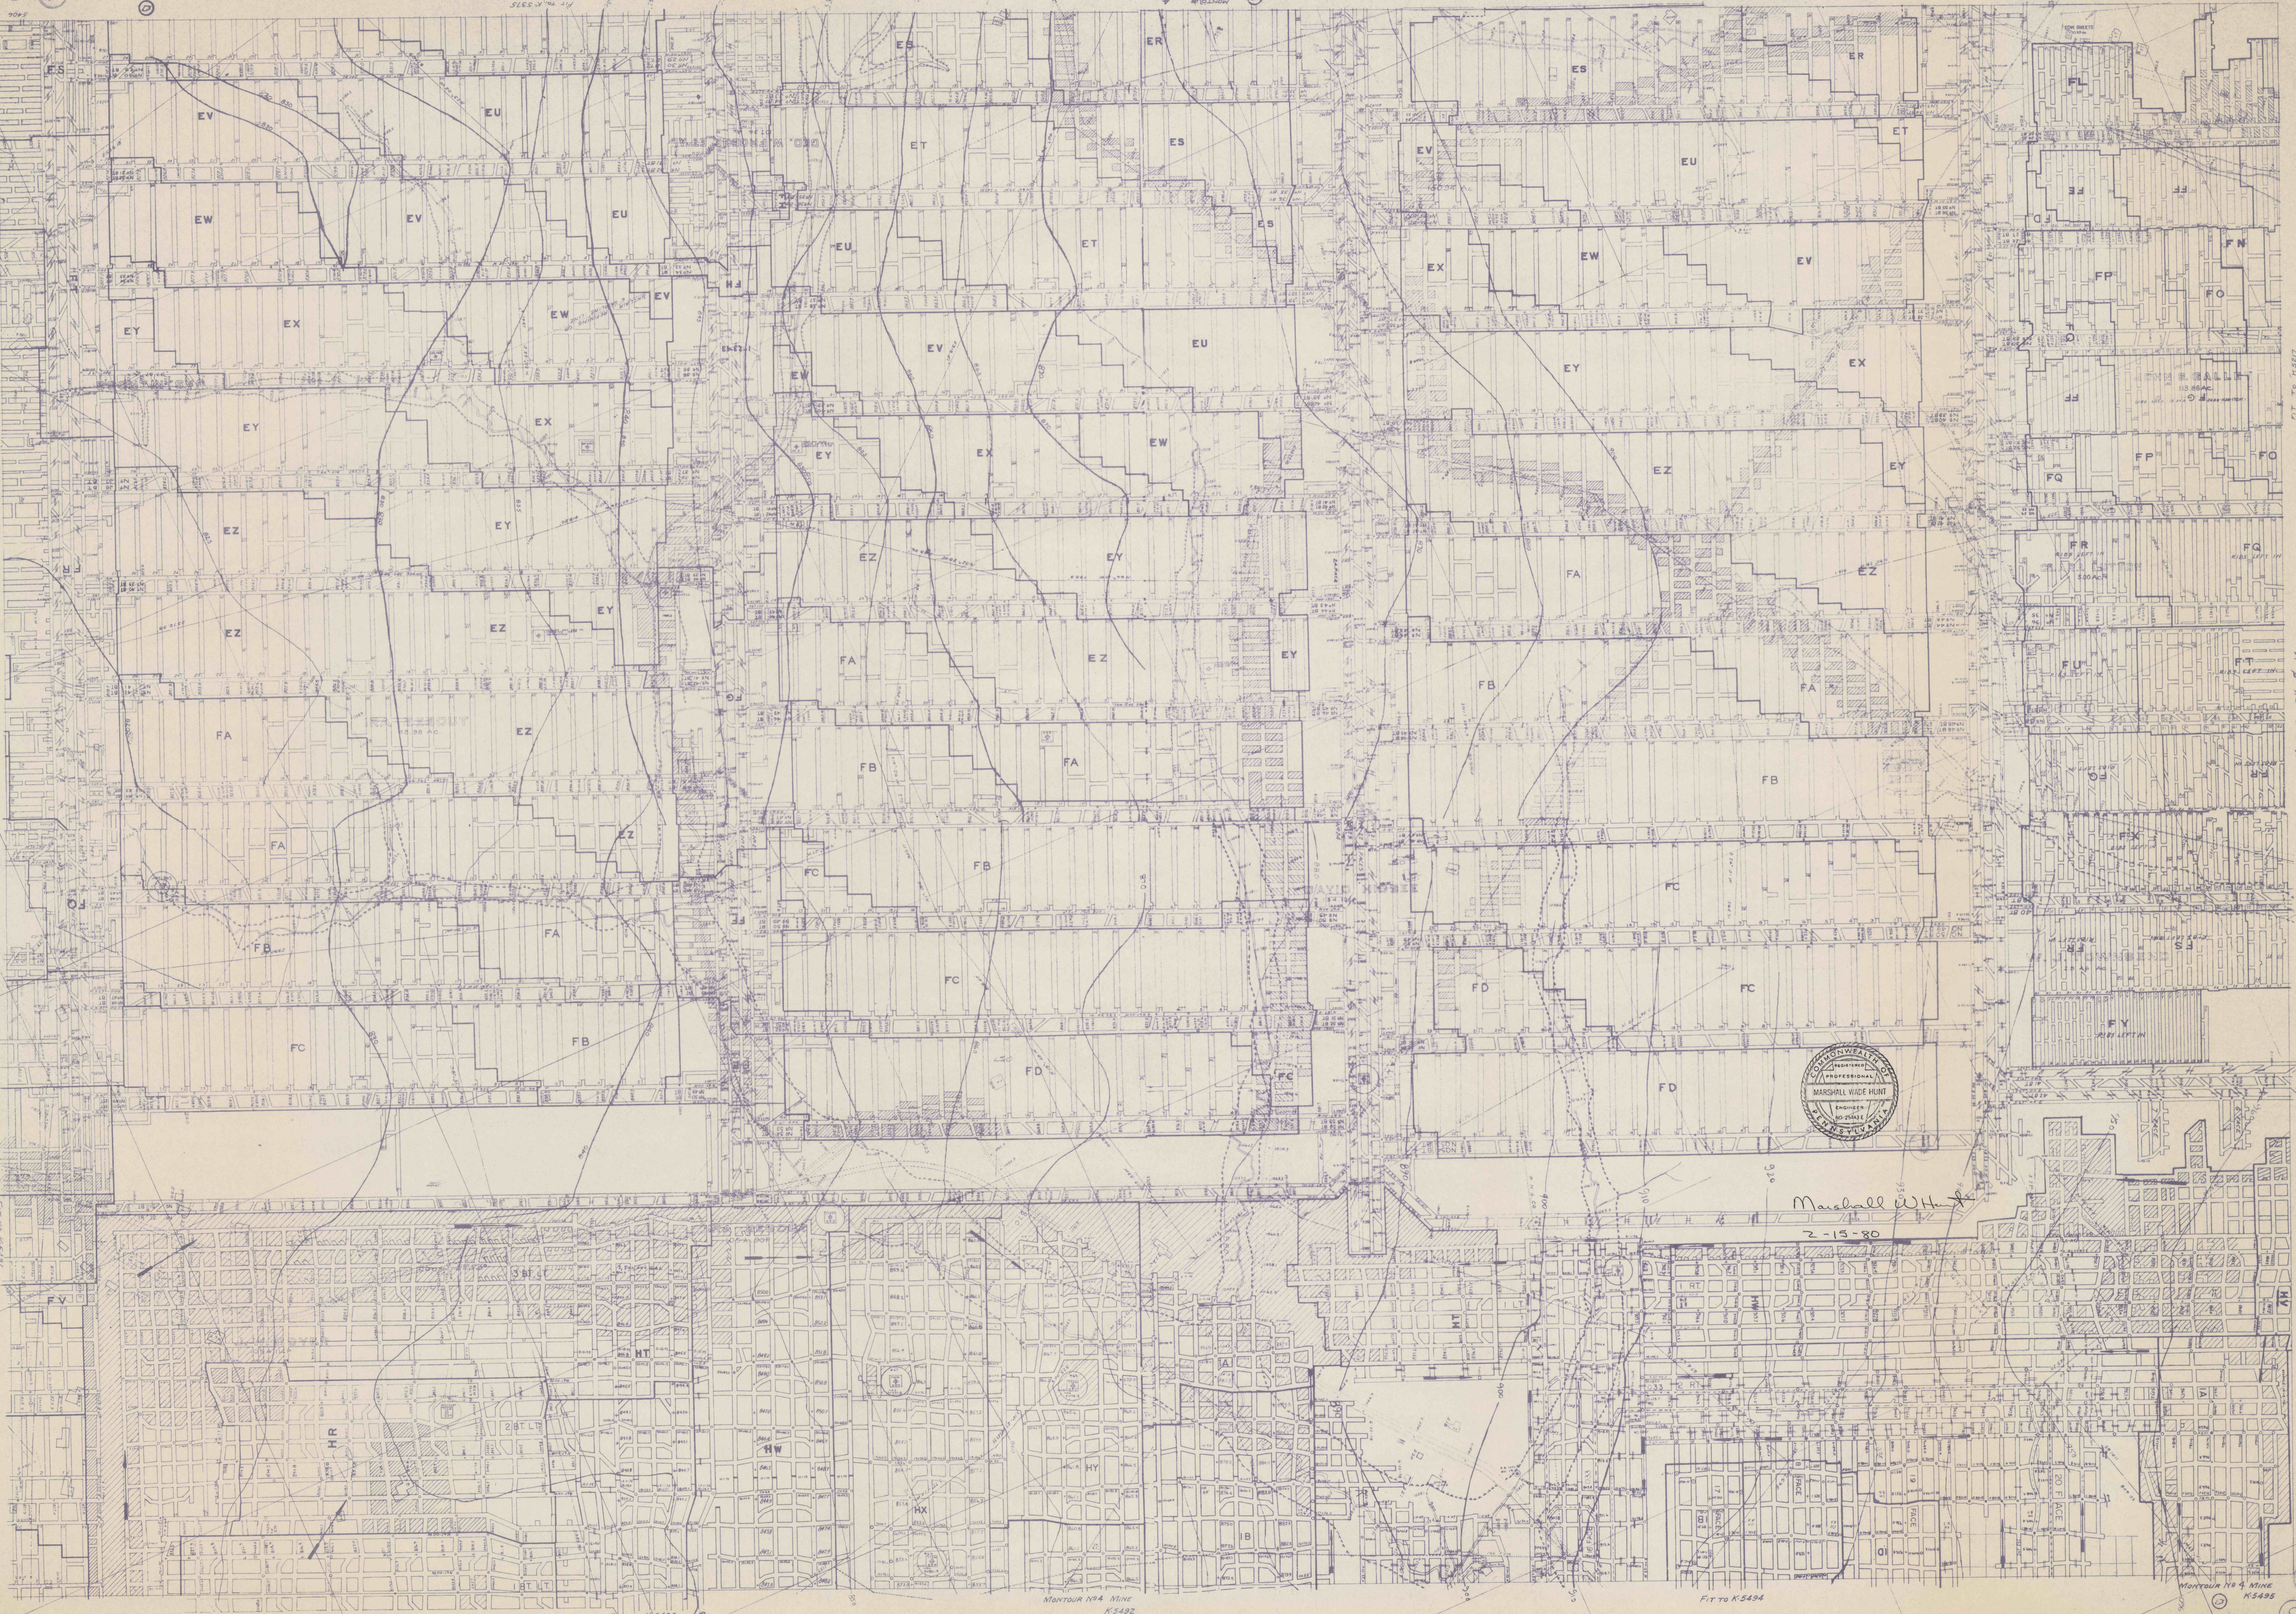

Marshall Wade Hunt  
2-13-80

FIT TO K5493

MONTOUR NO 4 MINE  
K5492  
FIT TO 10

FIT TO K5494

MONTOUR NO 4 MINE  
K5495  
FIT TO K-5555

FIT TO K5217

FIT TO MONTOUR SK. # 16

FIT TO K-5555