



Mont 10 1" = 200'

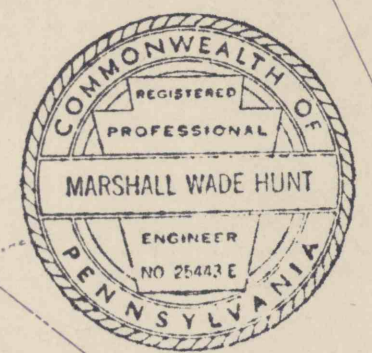

M.H. MAITS  
47.82A DEED AREA

A. B. SICKMAN et al  
16.27A  
COAL OWNER R. S. FAYETTE COAL CO

Marshall W Hunt 2-15-80

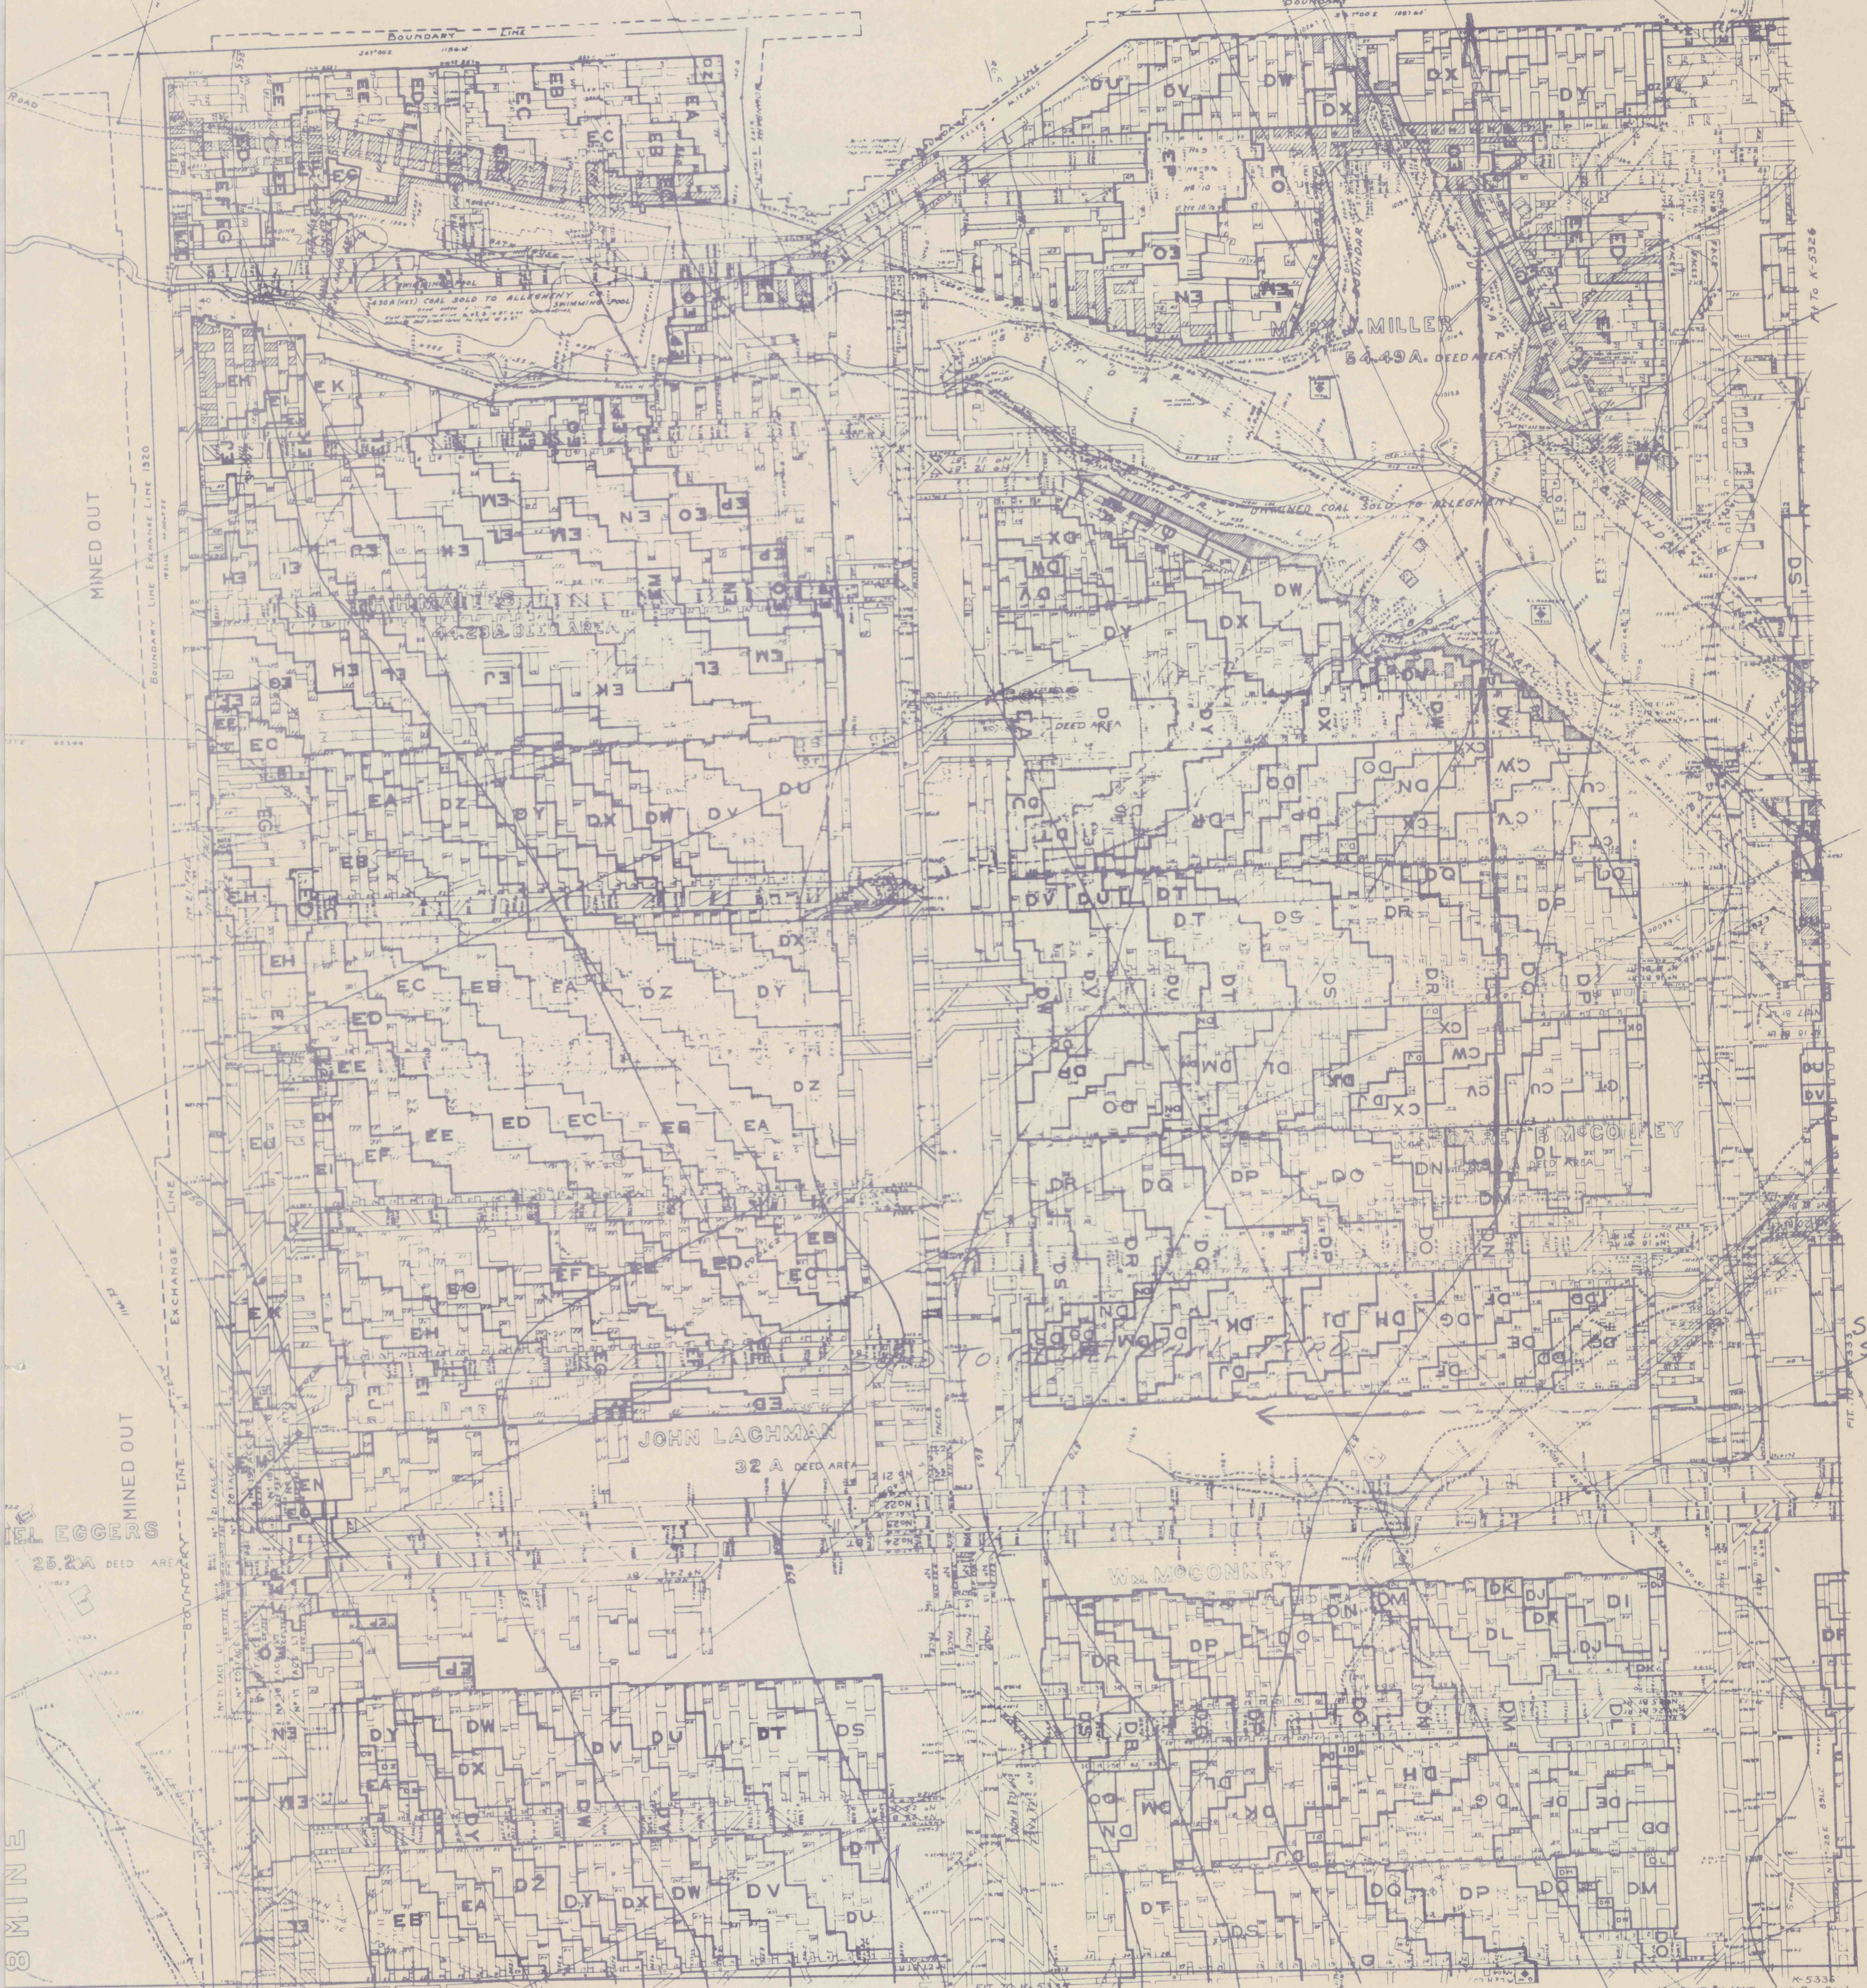

FIT TO 12

SOLD TO SO. PARK T

FIT TO 6

Mont 10 1" = 200' 5

8 MINE