


201111
FIT TO MONT 4 SH(2)

Fit to 4

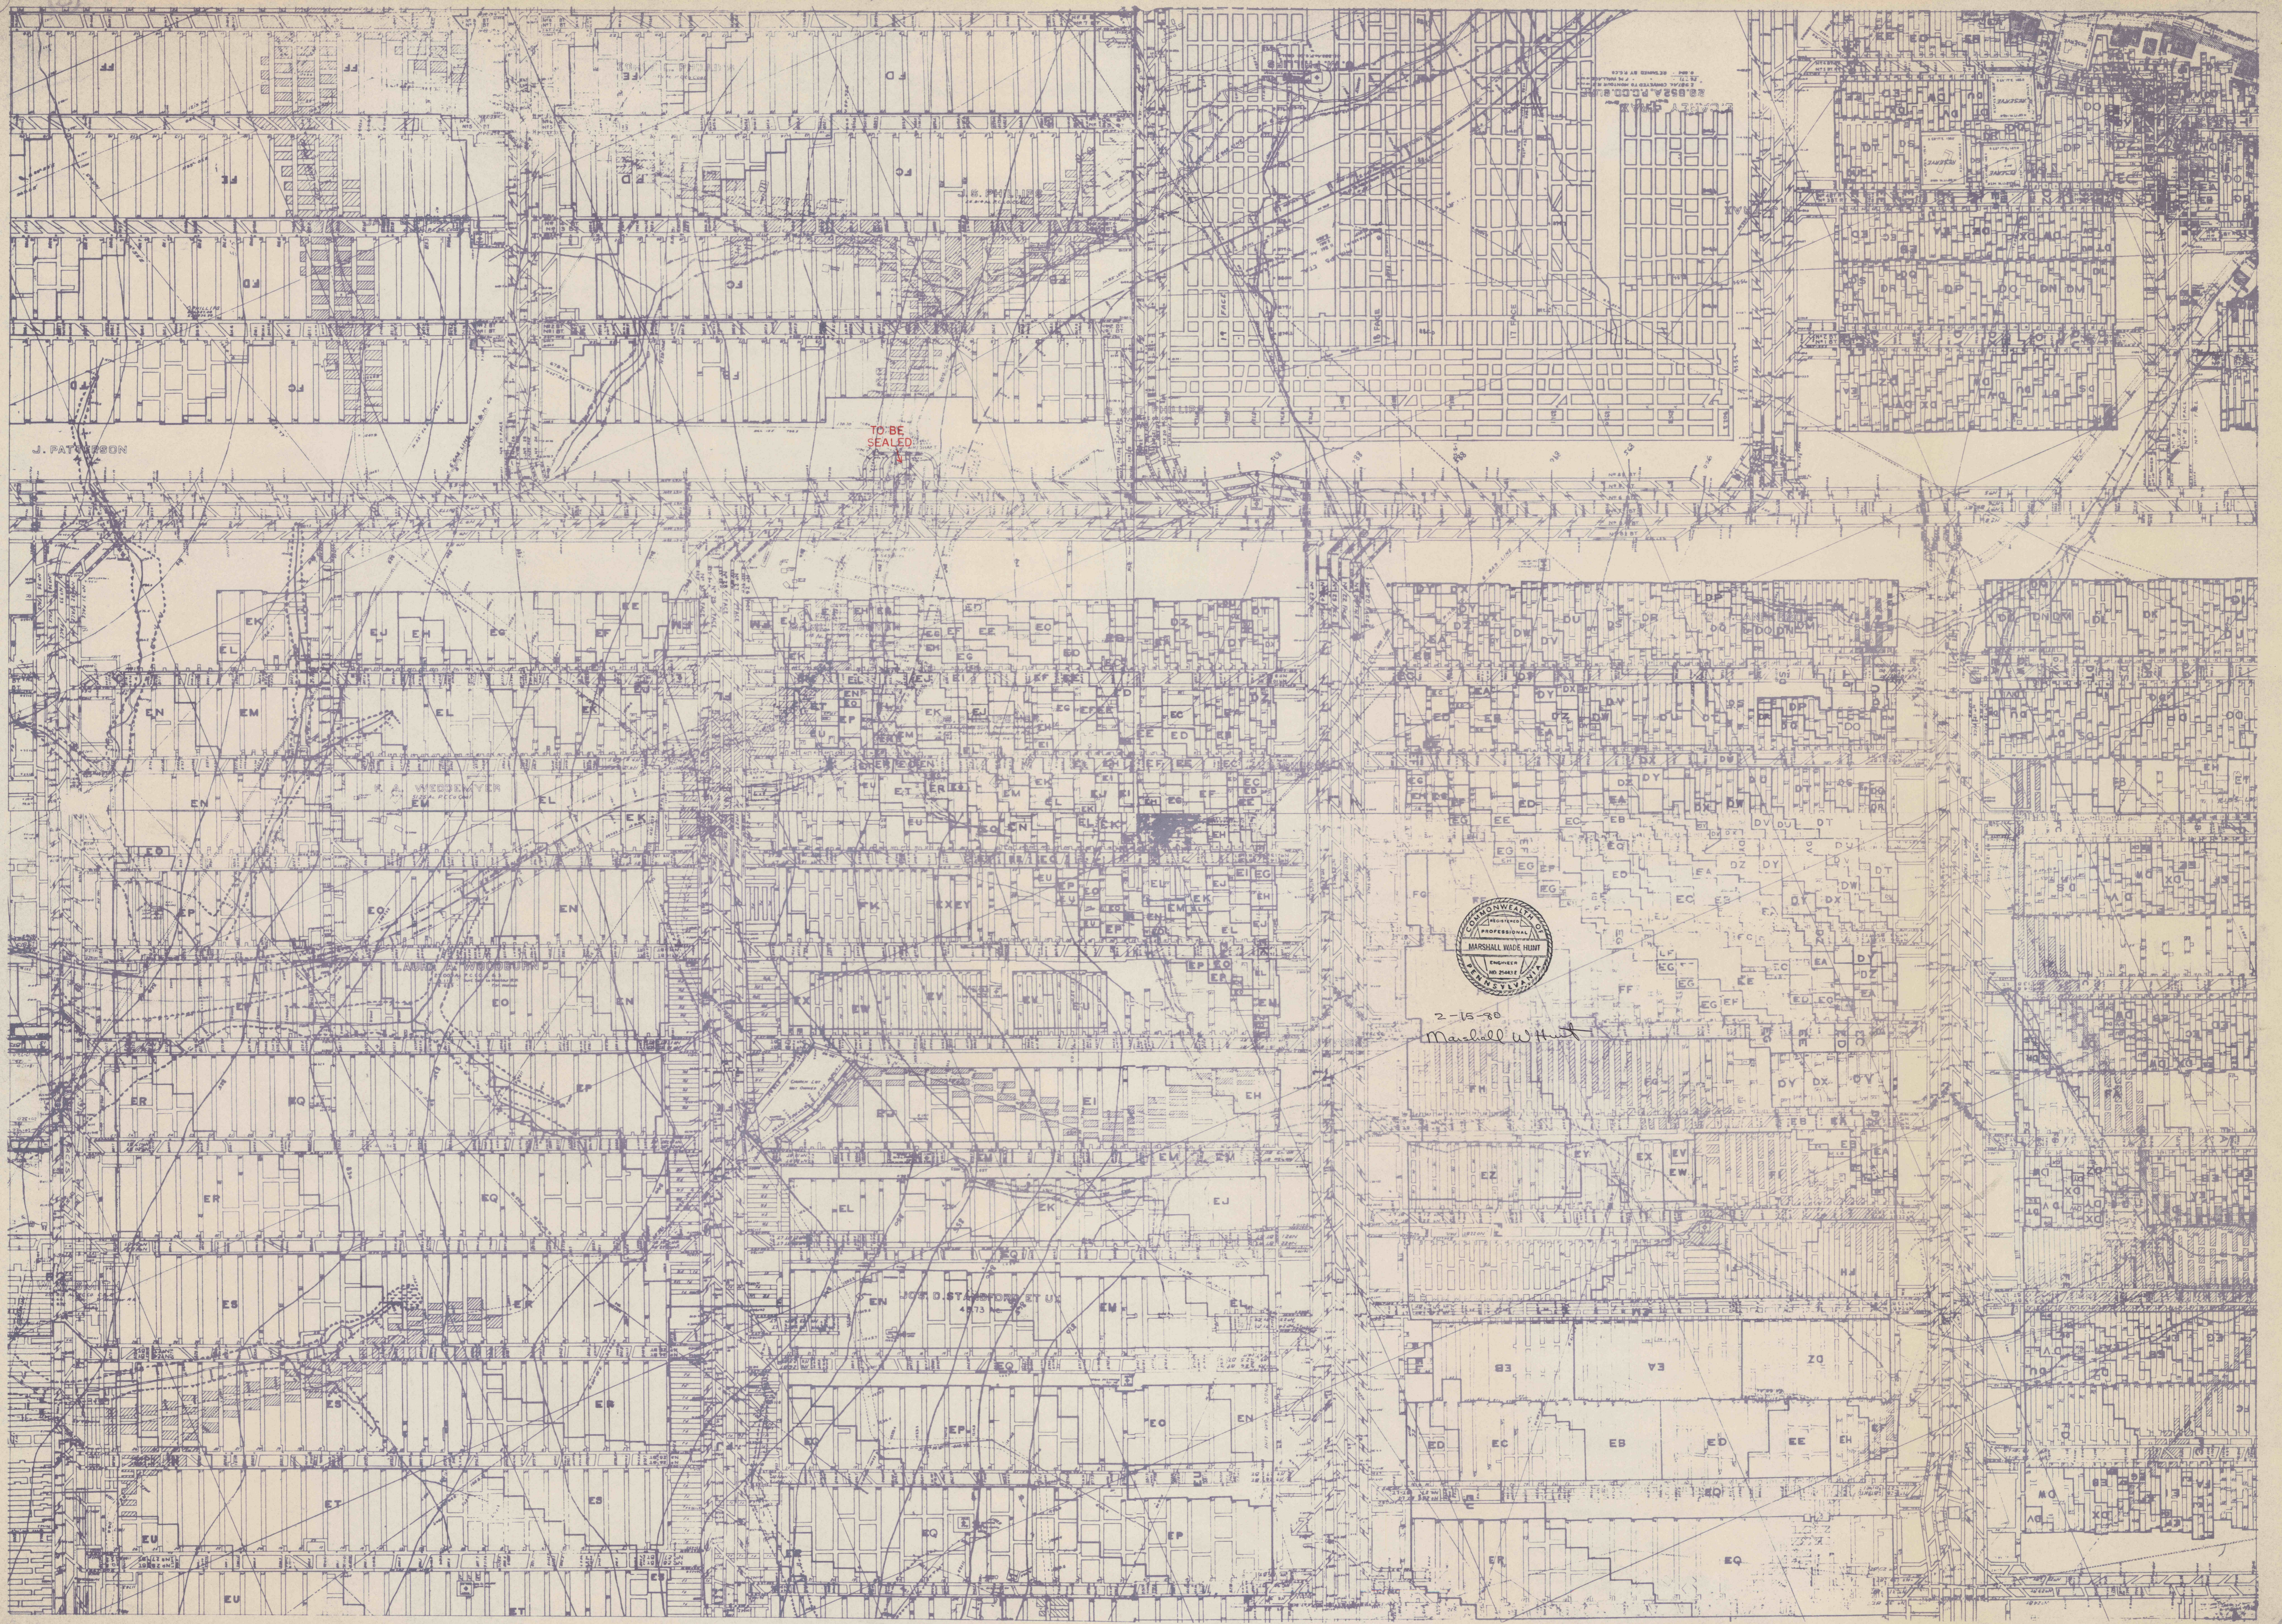

TO BE SEALED



2-15-30
Marshall W. Hunt

Fit to 9

MONT 10

8

Fit to 15