


9

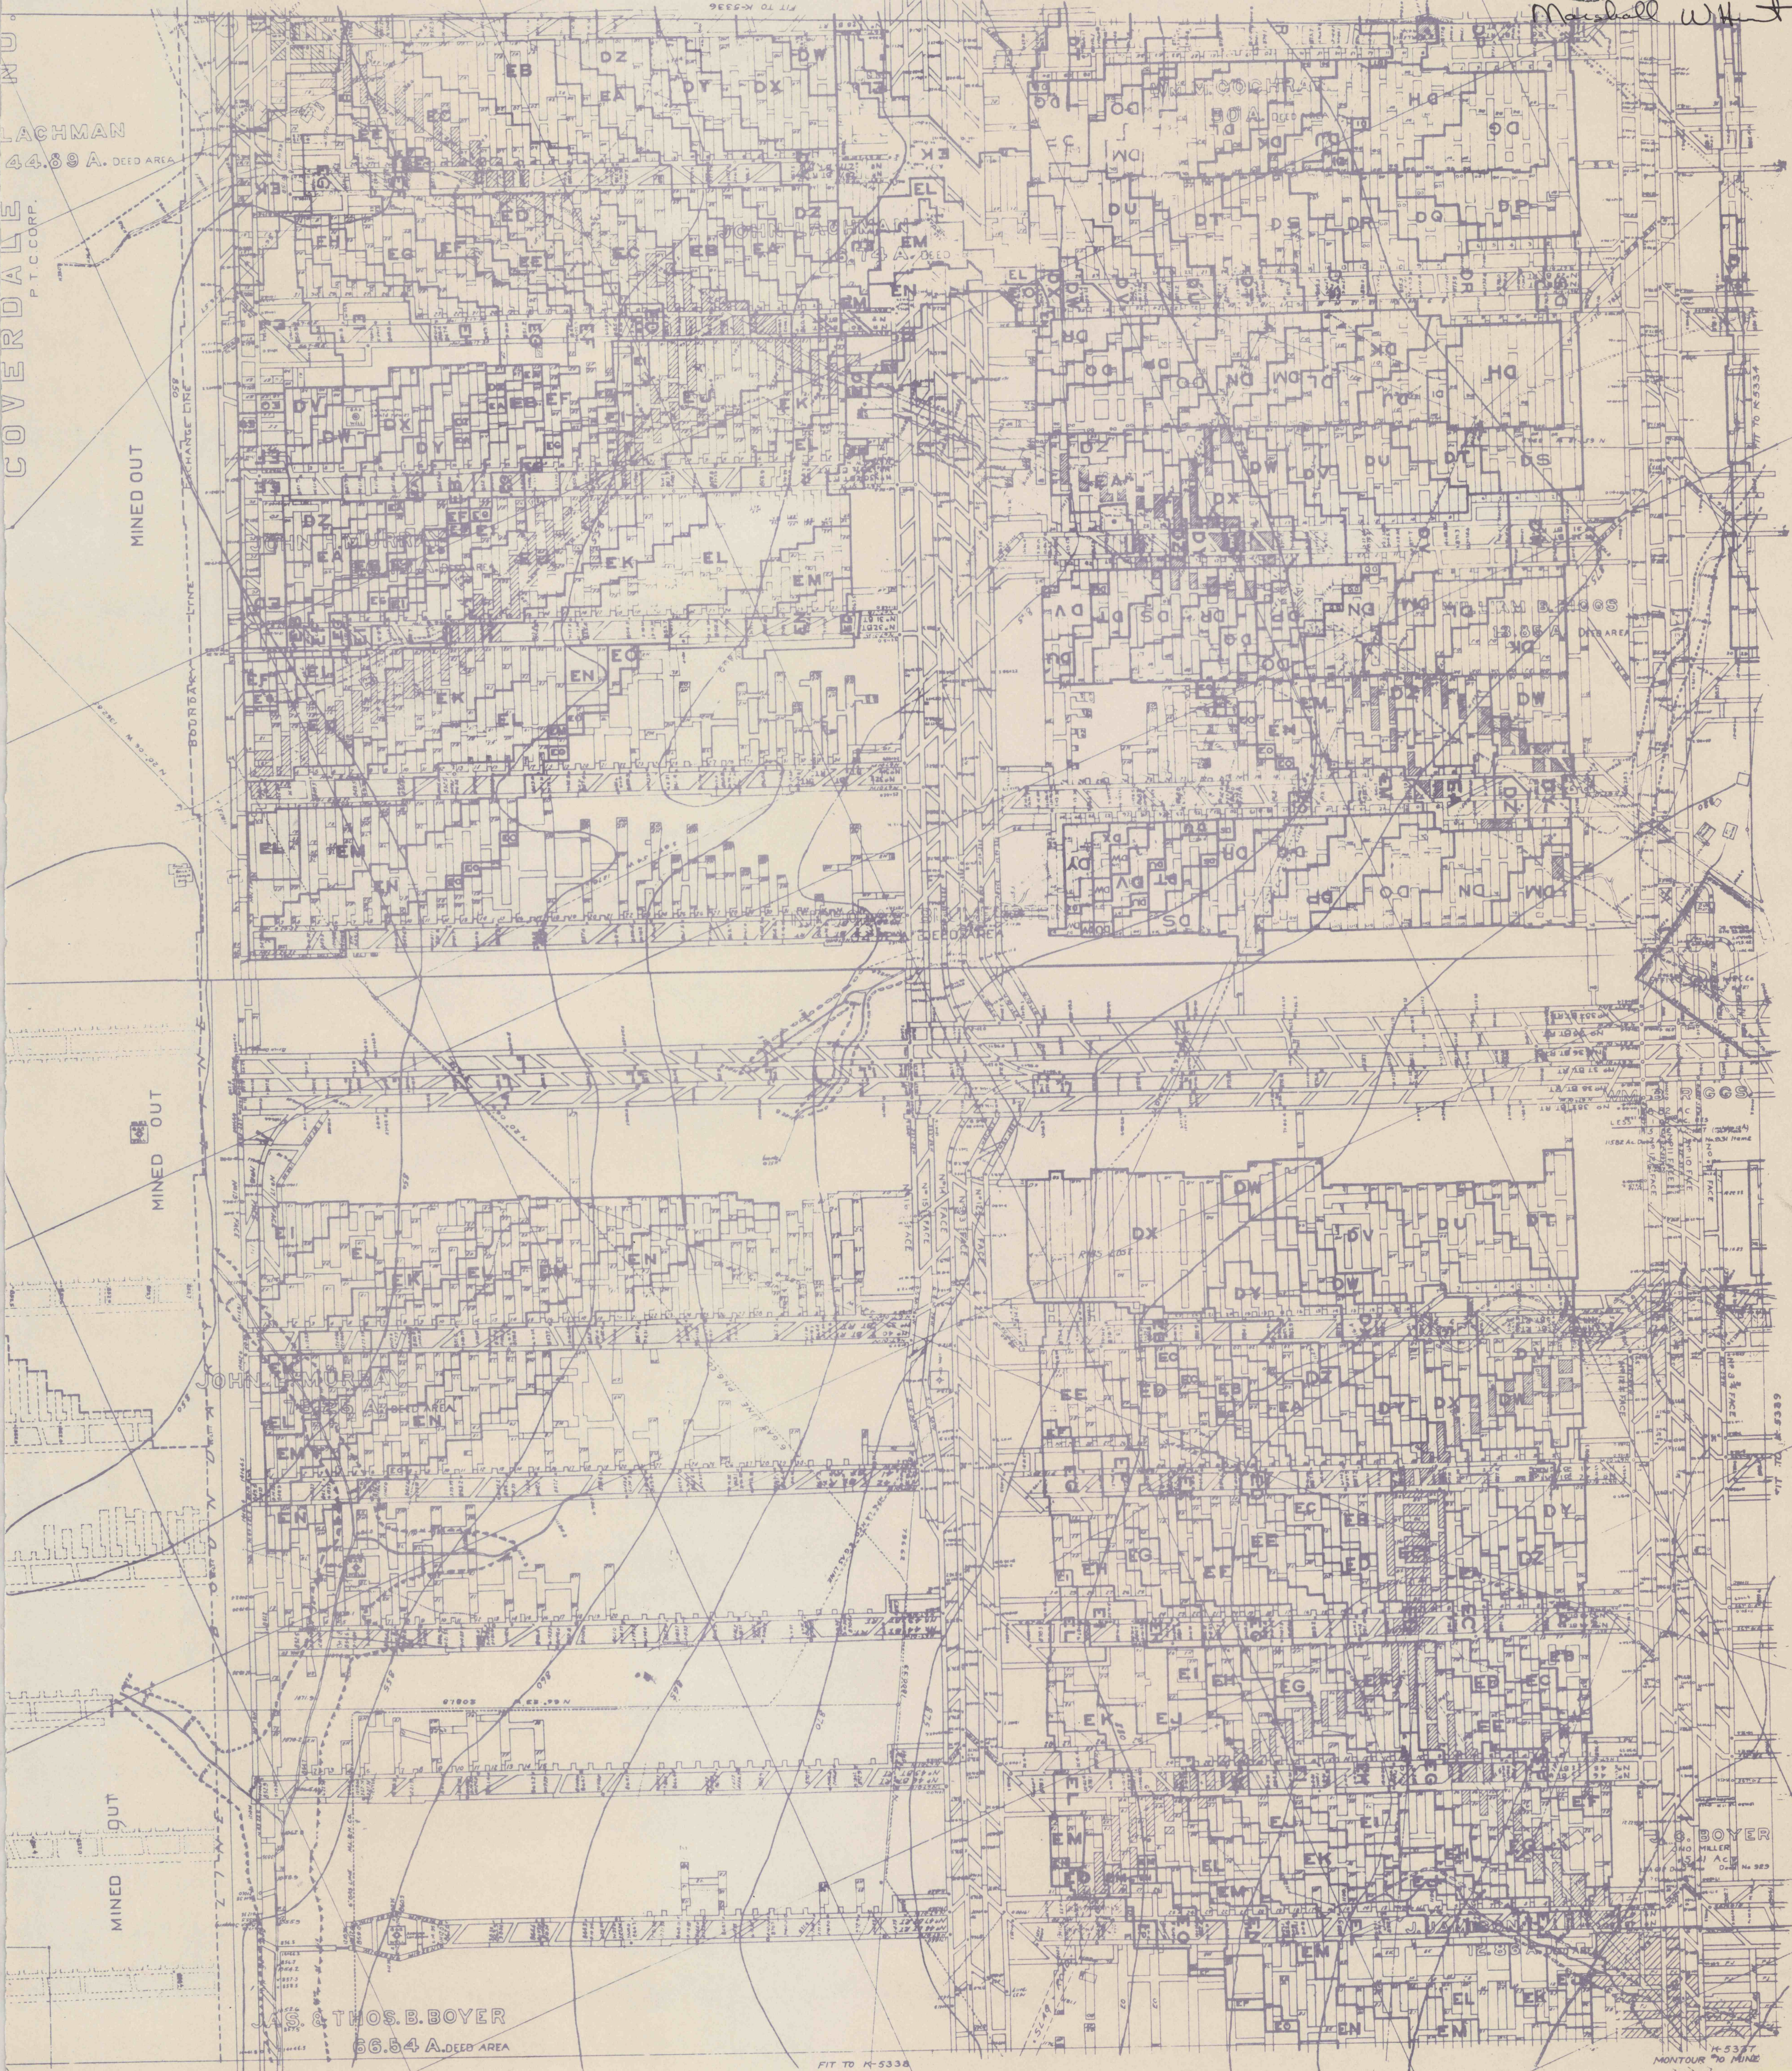

Marshall Wade Hunt 2-15-50



FIT TO 18

FIT TO 34

6