


I, HEREBY CERTIFY THAT THIS MINE HAS BEEN ABANDONED ON APRIL 27, 1955, AND THE MINE WORKINGS AS SHOWN BY SURVEY OF APRIL 27, 1955, MARKED I-1 HAVE NOT ADVANCED SINCE DATE OF SURVEY.

Robert B. Shannon
 ROBERT B. SHANNON
 REGISTERED SURVEYOR No. 703 E.

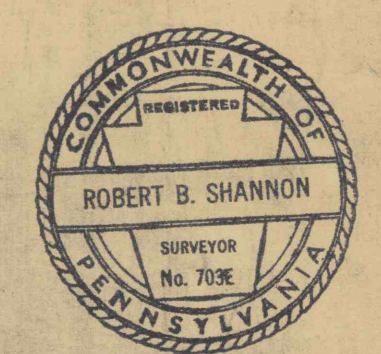

- SURVEY LEGEND
- Z APRIL 1 1941
 - A-1 FEB. 21 1942
 - B-1 NOV. 23 1942
 - C-1 DEC. 1 1943
 - D-1 JUNE 26 1945
 - E-1 NOV. 21 1946
 - F-1 DEC. 4 1947
 - G-1 JAN. 3 1951
 - H-1 JULY 18 1953
 - I-1 APRIL 27 1955

WALUWORK COAL CO.
 KITTANNING PA.
 MINE WORKINGS
 RAYBURN TWP.
 ARMSTRONG CO. PA.
 SCALE 1"=200'

#1867
 12-20-99
 CC