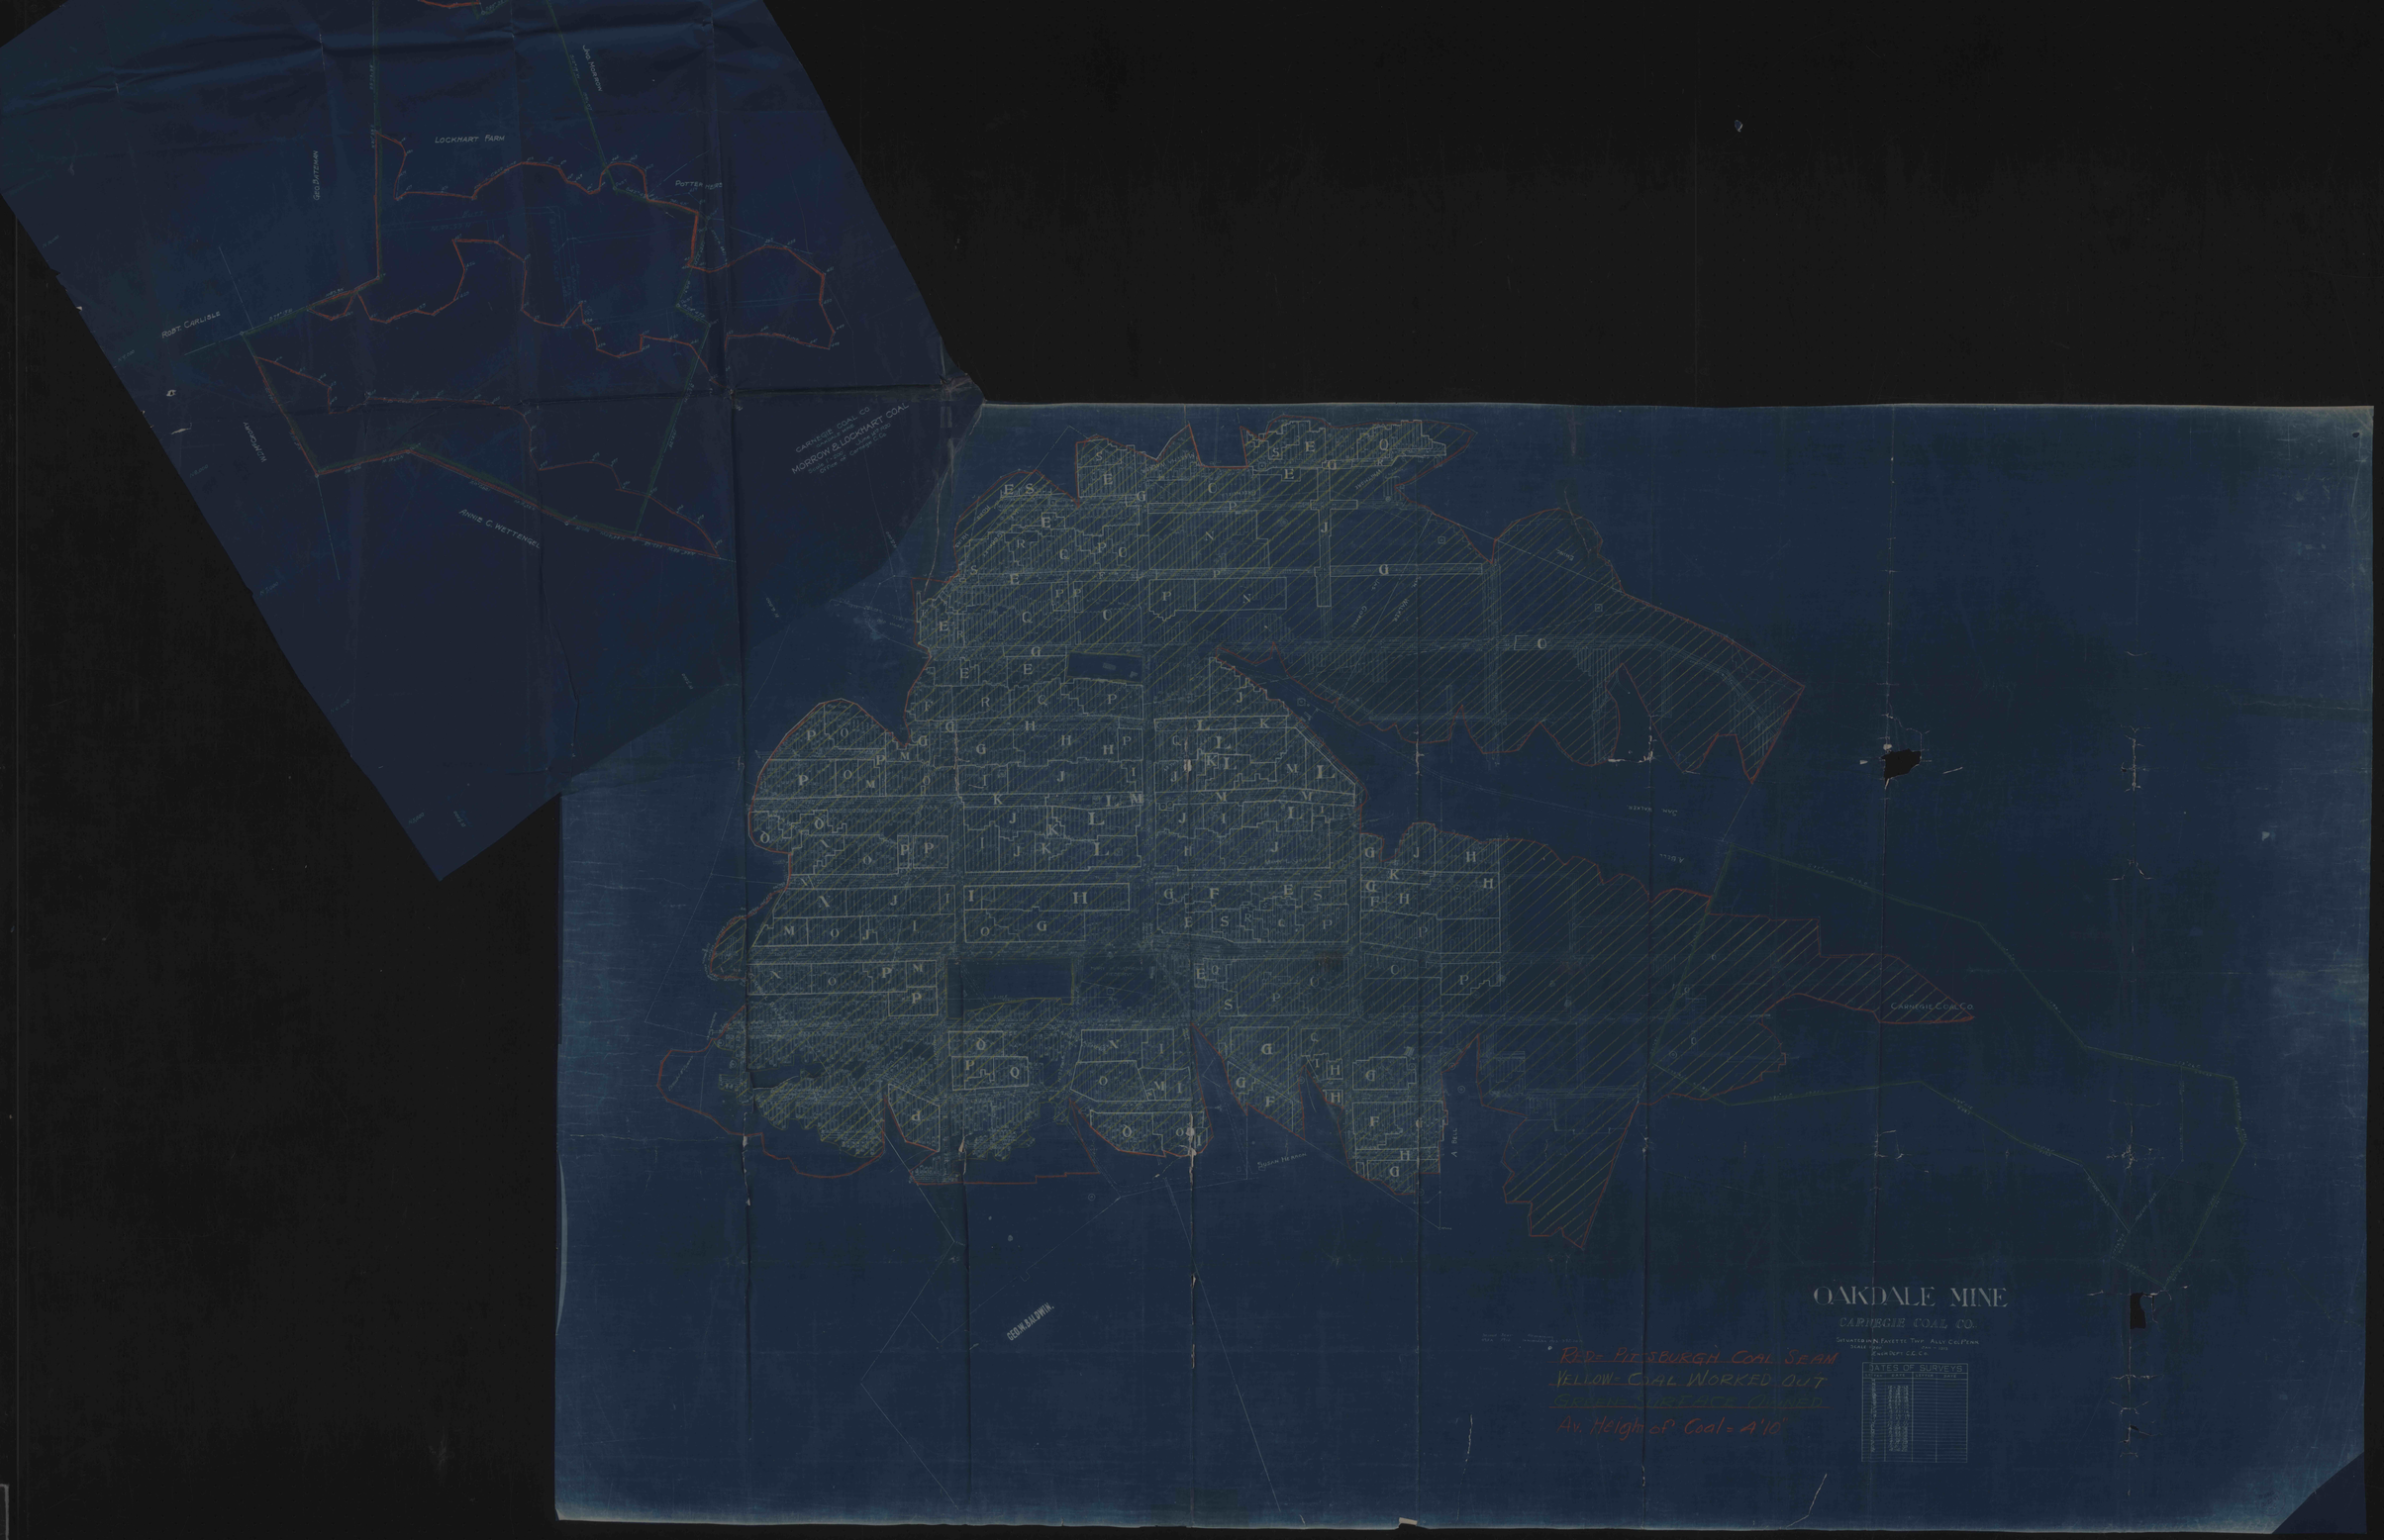
LOCKHART FARM
POTTER HEIRS
GEO. SUTTMAN
ROBT. CARLISLE
ANNIE C. WETTENGEL
CARNEGIE COAL CO
MORROW & LOCKHART COAL
CARNEGIE COAL CO.
GEO. M. BALDWIN.
OAKDALE MINE
CARNEGIE COAL CO.
SITUATED IN FAYETTE TWP. ALLEGHENY CO. PA.
SCALE 1200 = 1 INCH
CARNEGIE COAL CO.
DATES OF SURVEYS
RED= PITTSBURGH COAL SEAM
YELLOW= COAL WORKED OUT
GREEN= PRESENT CHAMBER
Av. Heigh of Coal = 4'10"