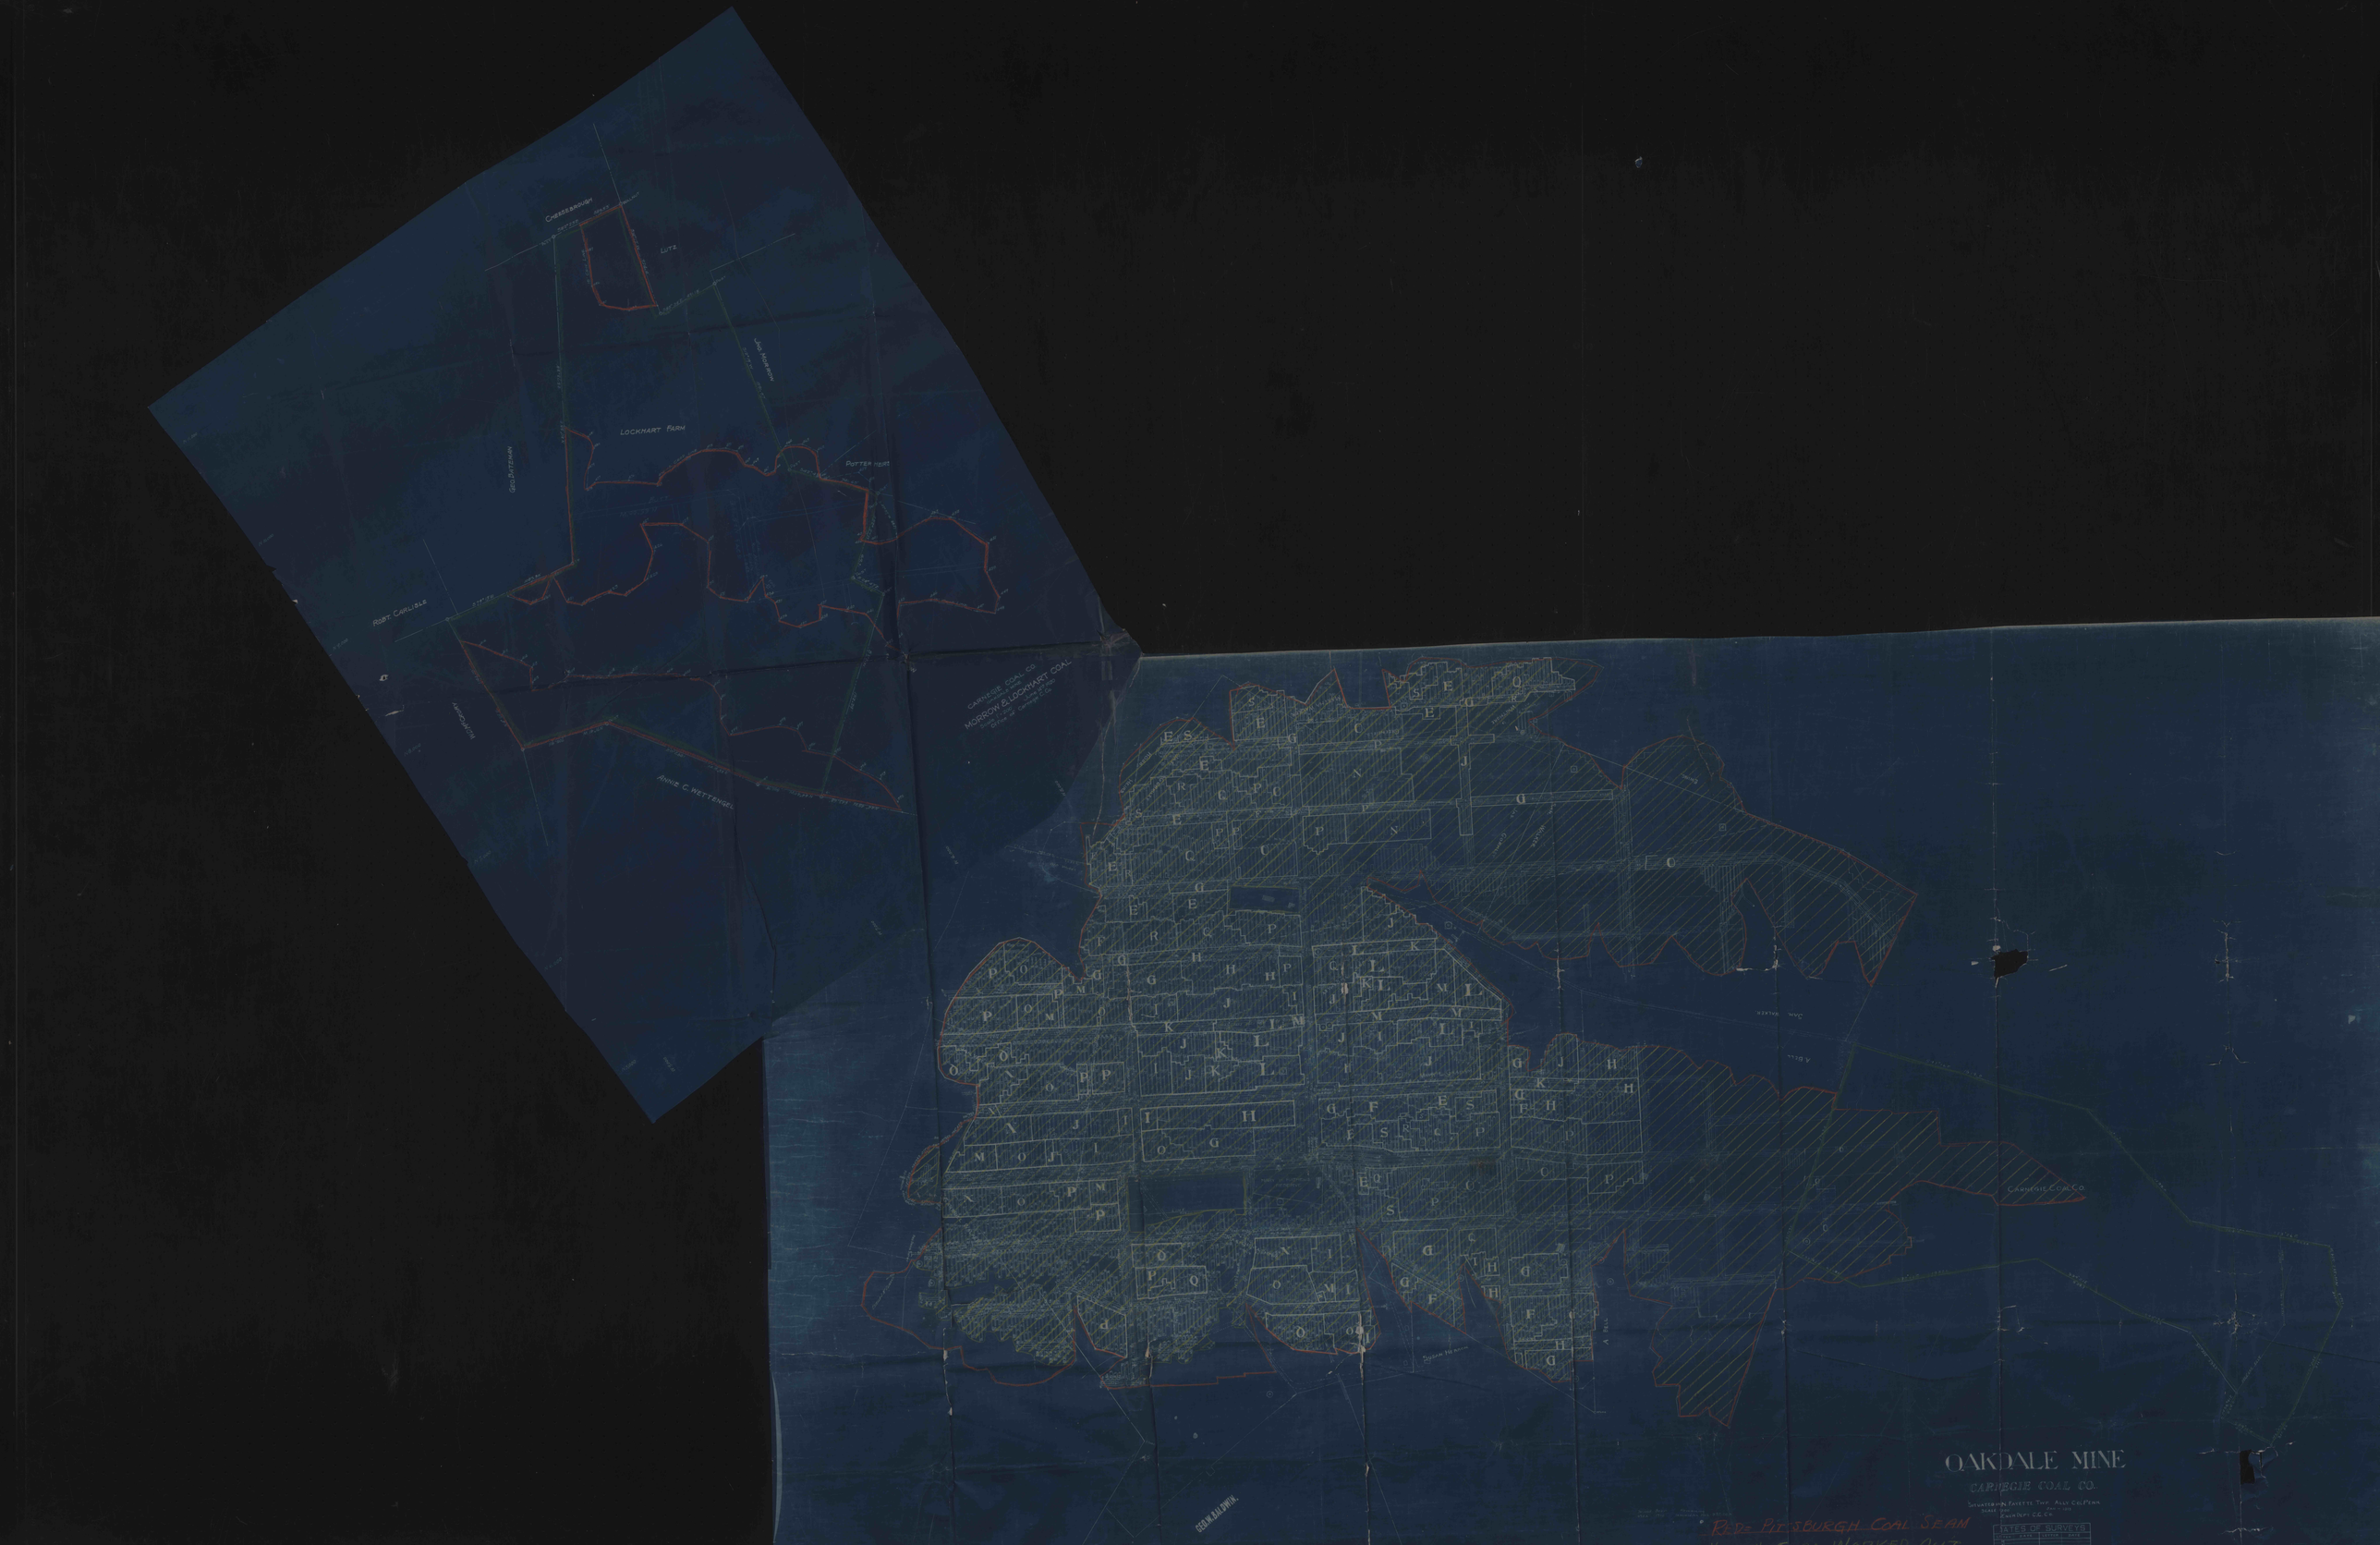
LOCKHART FARM
ROBT. CARLISLE
CARNEGIE COAL CO.
MORROW & LOCKHART COAL
CARNEGIE COAL CO.
OAKDALE MINE
CARNEGIE COAL CO.
RED= PITTSBURGH COAL SEAM