




David E. Yingling

SCALE: 1" = 200'

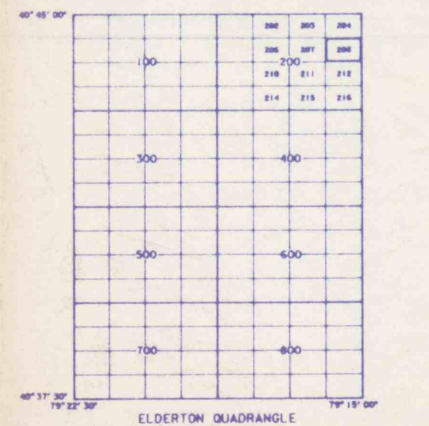

POSTING DATE 6-31-88

O'DONNELL COAL CO.
 655 CHURCH STREET, INDIANA, PA.
 NO. 3284521
 O'DONNELL AREA
 UPPER FREEPORT SEAM
 ELBERTON QUADRANGLE
 SHEET NO. 40330-11510-08
 WASHINGTON & PLUMCREEK TOWNSHIPS
 ARMSTRONG & INDIANA CO.

