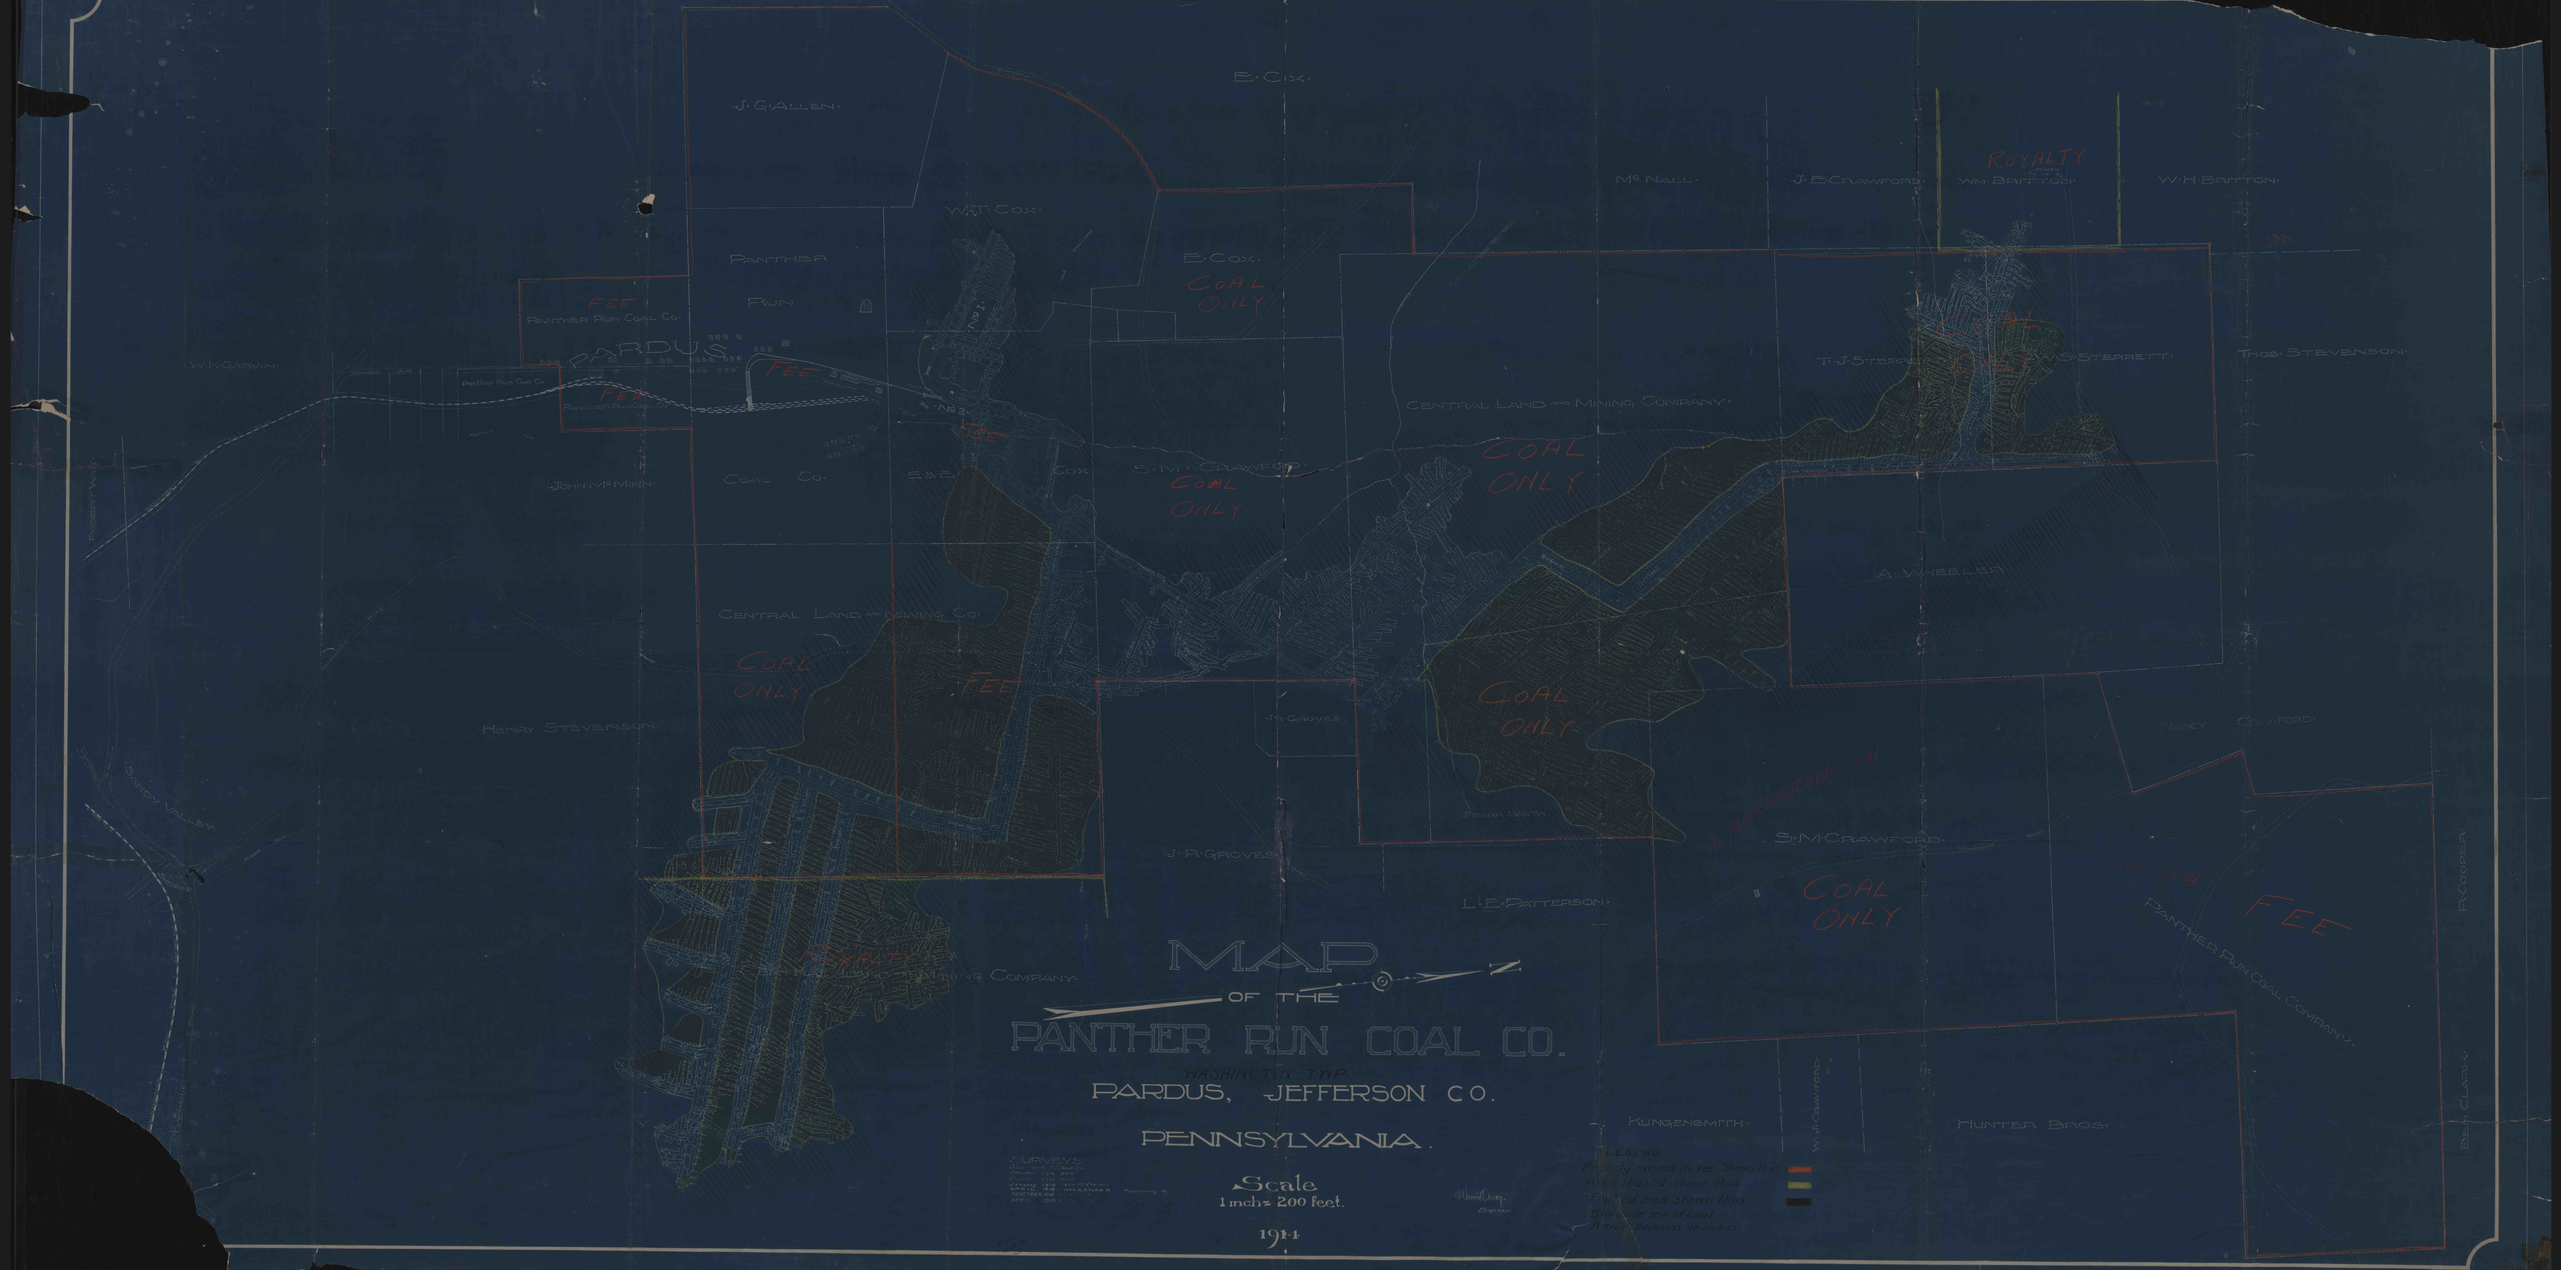
MAP
OF THE
PANTHER RUN COAL CO.
WASHINGTON TWP.
PARDUS, JEFFERSON CO.
PENNSYLVANIA.
Scale
1 inch = 200 feet.
1914
SURVEYS
Engineer
LEGEND
Property owned in Fee Shown thus
Area leased shown thus
Fee Red area shown thus
Broadville vein of coal
Average thickness 48 inches
PARDUS
FEE
COAL ONLY
ROYALTY
PANTHER RUN COAL CO.
PANTHER RUN COAL COMPANY
CENTRAL LAND AND MINING COMPANY
CENTRAL LAND AND MINING CO.
COAL CO.
J. G. ALLEN
E. COX
W. T. COX
E. COX
McNALL
J. E. CRAWFORD
WM. BRITTON
W. H. BRITTON
W. K. GARVIN
JOHN McMINN
E. & E. COX
S. M. CRAWFORD
T. J. STERRETT
W. S. STERRETT
THOS. STEVENSON
A. WHEELER
HENRY STEVENSON
J. R. GROVES
FRANK SMITH
NANCY CRAWFORD
S. M. CRAWFORD
L. E. PATTERSON
KLINGENSMITH
W. J. CRAWFORD
HUNTER BROS.
R. COOPER
BEN CLARK
SANDY VALLEY